Z 278 184 439

MR WENDELL STRINGER
STRINGER FUNERAL HOME
301 N JACKSON STREET
CRYSTAL SPRINGS MS 39059

Post Office, State, & ZIP Code	
Postage	$
Certified Fee	
Special Delivery Fee	
Restricted Delivery Fee	
Return Receipt Showing to Whom & Date Delivered	
Return Receipt Showing to Whom, Date, & Addressee's Address	
TOTAL Postage & Fees	$
Postmark or Date	

PS Form **3800**, April 1995

Stick postage stamps to article to cover First-Class postage, certified mail fee, and charges for any selected optional services *(See front).*

1. If you want this receipt postmarked, stick the gummed stub to the right of the return address leaving the receipt attached, and present the article at a post office service window or hand it to your rural carrier *(no extra charge)*

2. If you do not want this receipt postmarked, stick the gummed stub to the right of the return address of the article, date, detach, and retain the receipt, and mail the article.

3. If you want a return receipt, write the certified mail number and your name and address on a return receipt card, Form 3811, and attach it to the front of the article by means of the gummed ends if space permits. Otherwise, affix to back of article. Endorse front of article **RETURN RECEIPT REQUESTED** adjacent to the number.

4. If you want delivery restricted to the addressee, or to an authorized agent of the addressee, endorse **RESTRICTED DELIVERY** on the front of the article

5. Enter fees for the services requested in the appropriate spaces on the front of this receipt. If return receipt is requested, check the applicable blocks in item 1 of Form 3811

6. Save this receipt and present it if you make an inquiry.

PS Form **3800**, April 1995 *(Reverse)*

SENDER: COMPLETE THIS SECTION

- Complete items 1, 2, and 3. Also complete item 4 if Restricted Delivery is desired.
- Print your name and address on the reverse so that we can return the card to you.
- Attach this card to the back of the mailpiece, or on the front if space permits.

1. Article Addressed to:

MR WENDELL STRINGER
STRINGER FUNERAL HOME
501 N JACKSON STREET
CRYSTAL SPRINGS MS 39059

COMPLETE THIS SECTION ON DELIVERY

A. Received by *(Please Print Clearly)* Wendell Stringer
B. Date of Delivery 10-13-2000

C. Signature
X [signature]
☐ Agent
☒ Addressee

D. Is delivery address different from item 1? ☐ Yes
If YES, enter delivery address below: ☒ No

3. Service Type
☒ Certified Mail ☐ Express Mail
☐ Registered ☒ Return Receipt for Merchandise
☐ Insured Mail ☐ C.O.D.

4. Restricted Delivery? *(Extra Fee)* ☐ Yes

2. Article Number *(Copy from service label)*
7 278 184 437

PS Form 3811, July 1999 Domestic Return Receipt 102595-99-M-1789

UNITED STATES POSTAL SERVICE

First-Class Mail
Postage & Fees Paid
USPS
Permit No. G-10

• Sender: Please print your name, address, and ZIP+4 in this box •

MS DEPT OF ENVIRONMENTAL QUALITY
PO BOX 10385
JACKSON MS 39289-0385
ATTENTION: GRETCHEN ZMITROVICH

STATE OF MISSISSIPPI
DAVID RONALD MUSGROVE, GOVERNOR
MISSISSIPPI DEPARTMENT OF ENVIRONMENTAL QUALITY
CHARLES H. CHISOLM, EXECUTIVE DIRECTOR

October 11, 2000

CERTIFIED LETTER NO. Z 278 184 439 RETURN RECEIPT REQUESTED

Mr. Wendell Stringer
Stringer Funeral Home
301 N. Jackson Street
Crystal Springs, Mississippi 39059

RE: 301 N. Jackson Street
Crystal Springs, Copiah County, Mississippi

Dear Mr. Stringer:

The Uncontrolled Sites Section of the Mississippi Department of Environmental Quality (MDEQ) has completed a review of the sampling report prepared by Ogden Environmental and Engineering for the above referenced property. The MDEQ requires no further action at this site at this time.

If cleanup standards change or additional data becomes available for the site, then MDEQ will notify the appropriate parties of the need for any additional investigation(s) or remedial action(s). These actions will be consistent with our need to protect human health, welfare, and/or the environment.

If you have any questions, concerning this matter, please contact Gretchen Zmitrovich at (601) 961-5240.

Sincerely,

Tony Russell, Chief
Uncontrolled Sites Section

Kuhlman Electric-301 N. Jackson (Funeral Home) SNFA_10-11-00 (gz)

FILE COPY

STATE OF MISSISSIPPI
DAVID RONALD MUSGROVE, GOVERNOR
MISSISSIPPI DEPARTMENT OF ENVIRONMENTAL QUALITY
CHARLES H. CHISOLM, EXECUTIVE DIRECTOR

October 11, 2000

Mr. Wendell Stringer
Stringer Funeral Home
301 N. Jackson Street
Crystal Springs, Mississippi 39059

RE: soil and wipe sampling

Dear Mr. Stringer:

Please find attached the report for the soil and wipe sampling recently conducted at 301 N. Jackson Street, Crystal Springs, MS. The report includes the following:

1. a map showing the sampling locations,
2. a table containing the sample results for the analysis conducted by the mobile laboratory, Environmental Chemistry Consulting Services, and
3. data sheets containing the split sample results for the analysis conducted by the fixed laboratory, Paradigm Analytical Laboratories, Inc.

In addition, please find enclosed a letter from the MDEQ stating that, based on the information collected to date, no further investigative or remedial action is required on your property in regard to contamination from the Kuhlman facility.

Please contact Gretchen Zmitrovich at 601-961-5240 if you have any questions regarding this report.

Sincerely,

Tony Russell, Chief
Uncontrolled Sites Section

Enclosures

Kuhlman Electric-301 N. Jackson (Funeral Home) report_10-11-00 (gz)

COPY

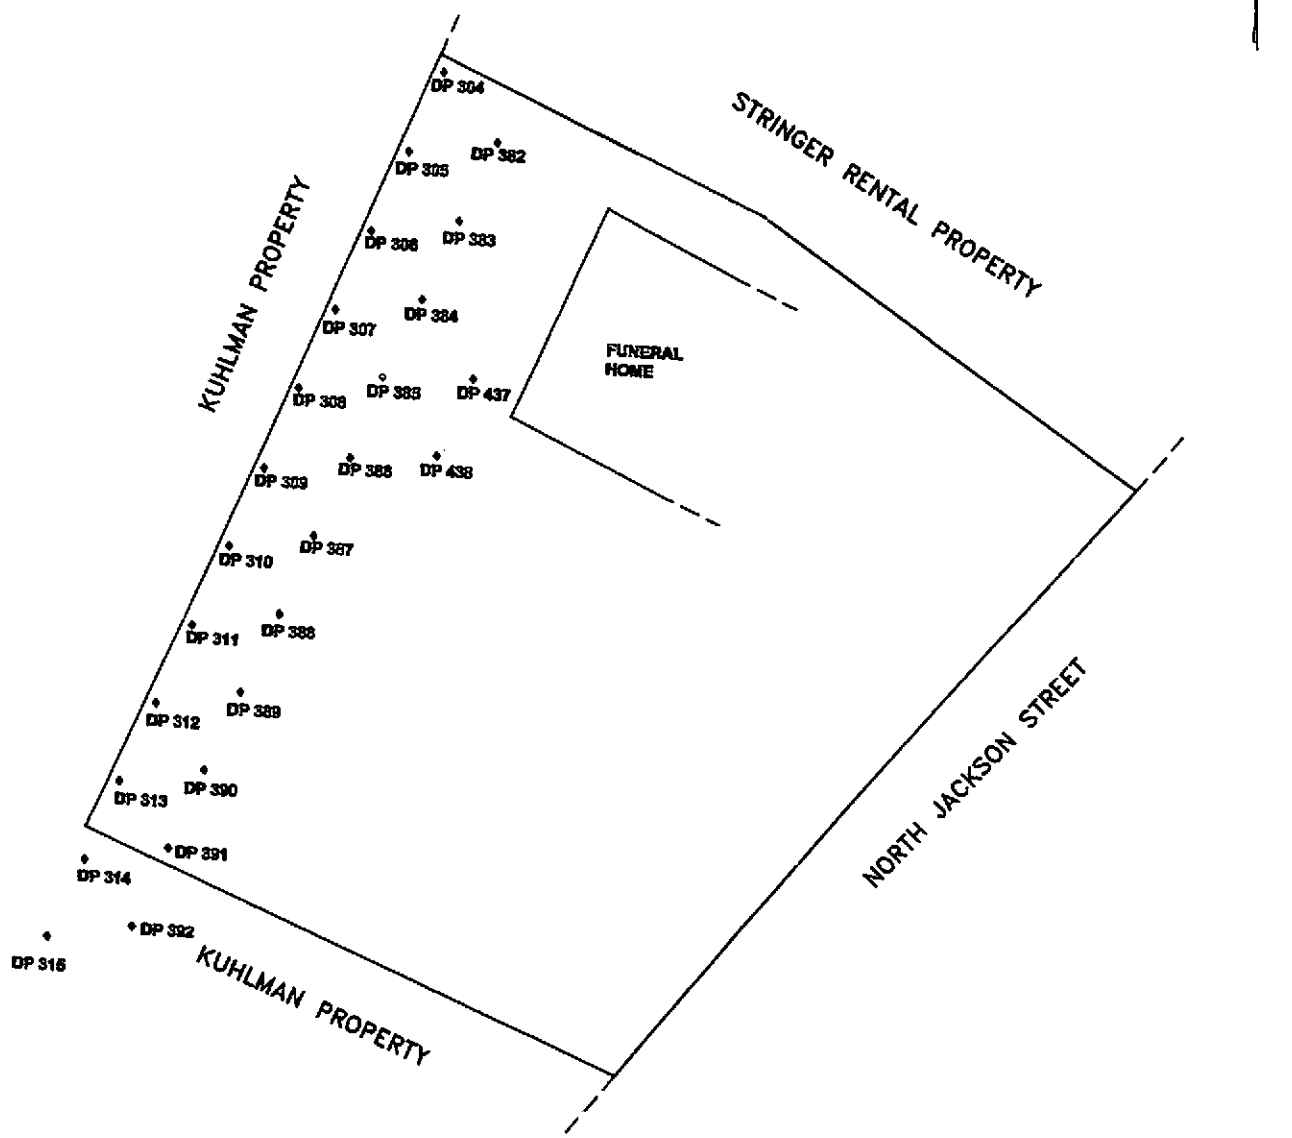

LEGEND

◆ SAMPLE POINT

DP 392 SAMPLE POINT NUMBER

1) ALL DISTANCES ARE ESTIMATED
2) THIS MAP WAS PREPARED FROM RECORD MAPS
3) THIS MAP HAS BEEN PREPARED FOR PRESENTATION PURPOSES ONLY

SAMPLE LOCATIONS FOR STRINGER FUNERAL HOME 301 NORTH JACKSON

SCALE: AS SHOWN	DR MDI	CHK TF	REV

PREPARED BY:

OGDEN ENVIRONMENTAL AND ENGINEERING SERVICES
200 SOUTH OLD STATEVILLE ROAD • HUNTERSVILLE, NC 28078 • 704-875-3570

PROJ: 073350000	DATE: 09/24/00	SHEET 1 OF 1

Soil and Wipe Sample Results
Stringer Funeral Home
301 North Jackson
Crystal Springs, Mississippi

SOIL SAMPLES (MG/KG)										
Target Analyte	Sample #	DP-304	DP-304	DP-305	DP-305	DP-306	DP-306	DP-307	DP-307	DP-308
	Depth (ft)	0.5	4	0.5	4	0.5	4	0.5	4	0.5
	Lab #	12	13	14	15	16	17	18	19	20
PCB as 1260		0.29	<0.10	0.66	<0.10	<0.10	<0.10	0.16	<0.10	0.15
	Collection Date	8/16/00	8/16/00	8/16/00	8/16/00	8/16/00	8/16/00	8/16/00	8/16/00	8/16/00
	Collection Time	10:46	10:50	10:52	10:55	10:59	11:03	11:12	11:16	11:20
	Injection Date	8/17/00	8/17/00	8/17/00	8/17/00	8/17/00	8/17/00	8/17/00	8/16/00	8/18/00

WIPE SAMPLES (TOTAL UG)					
Target Analyte	Sample #	SFH-1	SFH-2	SFH-3	SFH-4
	Depth				
	Lab #	736	737	738	739
PCB as 1260		<0.50	<0.50	<0.50	<0.50
	Collection Date	8/30/00	8/30/00	8/30/00	8/30/00
	Collection Time	13:15	13:18	13:22	13:25
	Injection Date	8/30/00	8/30/00	8/30/00	8/30/00

LOCATIONS:

SFH1: Double glass doors, entry from hearse parking.
SFH2: Wooden fence slat, 40' south of north fenceline, 4' above groud surface.
SFH3: North handrail of stairs on north side of building, leading to second story. Taken from third step up from ground level.
SFH4: Double glass doors, south side entrance.

Soil and Wipe Sample Results
Stringer Funeral Home
301 North Jackson
Crystal Springs, Mississippi

SOIL SAMPLES (MG/KG)										
Target Analyte	Sample #	DP-308	DP-309	DP-309	DP-310	DP-310	DP-311	DP-311	DP-312	DP-312
	Depth (ft)	4	0.5	4	0.5	4	0.5	4	0.5	4
	Lab #	21	22	23	24	25	26	27	28	29
PCB as 1260		<0.10	<0.10	<0.10	0.22	<0.10	<0.10	<0.10	<0.10	<0.10
	Collection Date	8/16/00	8/16/00	8/16/00	8/16/00	8/16/00	8/16/00	8/16/00	8/16/00	8/16/00
	Collection Time	11:22	11:26	11:30	11:47	11:50	11:55	12:00	12:05	12:09
	Injection Date	8/16/00	8/16/00	8/16/00	8/16/00	8/17/00	8/17/00	8/17/00	8/17/00	8/17/00

SOIL SAMPLES (MG/KG)										
Target Analyte	Sample #	DP-313	DP-313	DP-314	DP-314	DP-315	DP-315	DP-382	DP-382	DP-383
	Depth (ft)	0.5	4	0.5	4	0.5	4	0.5	4	0.5
	Lab #	30	31	32	33	34	35	185	186	187
PCB as 1260		<0.10	<0.10	0.16	<0.10	0.12	<0.10	<0.10	NA	<0.10
	Collection Date	8/16/00	8/16/00	8/16/00	8/16/00	8/16/00	8/16/00	8/19/00	8/19/00	8/19/00
	Collection Time	12:12	12:14	12:17	12:20	12:22	12:25	8:15	8:16	8:25
	Injection Date	8/17/00	8/17/00	8/17/00	8/17/00	8/17/00	8/17/00	8/19/00	NA	8/19/00

Notes:

NA Indicates Sample Not Analyzed

Soil and Wipe Sample Results
Stringer Funeral Home
301 North Jackson
Crystal Springs, Mississippi

SOIL SAMPLES (MG/KG)										
Target Analyte	Sample #	DP-383	DP-384	DP-384	DP-385	DP-385	DP-386	DP-386	DP-387	DP-387
	Depth (ft)	4	0.5	4	0.5	4	0.5	4	0.5	4
	Lab #	188	189	190	191	192	193	194	195	196
PCB as 1260		NA	<0.10	NA	0.68	<0.10	<0.10	NA	<0.10	NA
	Collection Date	8/19/00	8/19/00	8/19/00	8/19/00	8/19/00	8/19/00	8/19/00	8/19/00	8/19/00
	Collection Time	8:26	8:31	8:32	8:45	8:46	8:54	8:56	9:01	9:02
	Injection Date	NA	8/19/00	NA	8/19/00	8/19/00	8/19/00	NA	8/19/00	NA

Notes:

NA Indicates Sample Not Analyzed

SOIL SAMPLES (MG/KG)										
Target Analyte	Sample #	DP-388	DP-388	DP-389	DP-389	DP-390	DP-390	DP-391	DP-391	DP-392
	Depth (ft)	0.5	4	0.5	4	0.5	4	0.5	4	0.5
	Lab #	197	198	199	200	201	202	203	204	205
PCB as 1260		<0.10	NA	<0.10	NA	<0.10	NA	<0.10	NA	<0.10
	Collection Date	8/19/00	8/19/00	8/19/00	8/19/00	8/19/00	8/19/00	8/19/00	8/19/00	8/19/00
	Collection Time	9:09	9:10	9:15	9:17	9:19	9:20	9:22	9:24	9:26
	Injection Date	8/19/00	NA	8/19/00	NA	8/19/00	NA	8/19/00	NA	8/19/00

Notes:

NA Indicates Sample Not Analyzed

Soil and Wipe Sample Results
Stringer Funeral Home
301 North Jackson
Crystal Springs, Mississippi

SOIL SAMPLES (MG/KG)									
Target Analyte	Sample #	DP-392	DP-437	DP-437	DP-438	DP-438	DP-304	DP-305	DP-385
	Depth (ft)	4	0.5	4	0.5	4	0.1	0.1	0.1
	Lab #	208	300	301	302	303	1121	1122	1123
PCB as 1260		NA	<0.10	NA	<0.10	NA	0.37	0.60*J	0.10
	Collection Date	8/19/00	8/20/00	8/20/00	8/20/00	8/20/00	9/19/00	9/19/00	9/19/00
	Collection Time	9:27	13:20	13:22	13:35	13:36	11:40	11:42	11:45
	Injection Date	NA	8/20/00	NA	8/20/00	NA	9/20/00	9/20/00	9/20/00

Notes:

NA Indicates Sample Not Analyzed
* J Estimated level, due to interference from the presence of Technical Chlordane, DDT, DDD, & DDE.


Results for PCBs
by EPA 8082

Client Sample ID: DP304 - 0.5'
Client Project ID: Kuhlman Electric
Lab Sample ID: 93676
Lab Project ID: G185-78
Matrix: Soil %SOLIDS: 86.5

Date Collected: 8/16/00
Date Received: 8/18/00
Date Analyzed: 8/30/00
Analyzed By: CLP
Dilution: 1

Compound	Quantitation Limit (ug/KG)	Result (ug/KG)
Arochlor-1016	180	BQL
Arochlor-1221	180	BQL
Arochlor-1232	180	BQL
Arochlor-1242	180	BQL
Arochlor-1248	180	BQL
Arochlor-1254	180	BQL
Arochlor-1260	180	340
Arochlor-1262	180	BQL

Surrogate Spike Recoveries	Spike Added	Spike Result	Percent Recovered
TCMX	100	64	64

*Sample was quantitated as Aroclor 1260, but appears to contain a mixture of Aroclor 1260 and Aroclor 1262.

Comments:
BQL = Below Quantitation Limit
NA = Not applicable, surrogate diluted out.

Reviewed By:

PARADIGM ANALYTICAL LABORATORY INC.

Results for Semivolatiles
by GCMS 8270

Client Sample ID: DP304 - 0.5'
Client Project ID: Kuhlman Electric
Lab Sample ID: 93676
Lab Project ID: G185-78
Matrix: Soil %Solids: 86.5

Date Collected: 8/16/00
Date Received: 8/18/00
Date Analyzed: 8/30/00
Analyzed By: MRC
Dilution: 1

Compound	Quantitation Limit (ug/KG)	Result (ug/KG)
Acenaphthene	360	BQL
Acenaphthylene	360	BQL
Anthracene	360	BQL
Benzo[a]anthracene	360	BQL
Benzo[a]pyrene	360	BQL
Benzo[b]fluoranthene	360	BQL
Benzo[g,h,i]perylene	360	BQL
Benzo[k]fluoranthene	360	BQL
Benzoic Acid	720	BQL
Bis(2-chloroethoxy)methane	360	BQL
Bis(2-chloroethyl)ether	360	BQL
Bis(2-chloroisopropyl)ether	360	BQL
Bis(2-ethylhexyl)phthalate	360	BQL
4-bromophenyl phenyl ether	360	BQL
Butylbenzylphthalate	360	BQL
4-Chloroaniline	360	BQL
4-Chloro-3-methylphenol	360	BQL
2-Chloronaphthalene	360	BQL
2-Chlorophenol	360	BQL
4-Chlorophenyl phenyl ether	360	BQL
Chrysene	360	BQL
Di-n-Butylphthalate	360	BQL
Di-n-octylphthalate	360	BQL
Dibenzo[a,h]anthracene	360	BQL
Dibenzofuran	360	BQL
1,2-Dichlorobenzene	360	BQL
1,3-Dichlorobenzene	360	BQL
1,4-Dichlorobenzene	360	BQL
3,3'-Dichlorobenzidine	720	BQL
2,4-Dichlorophenol	360	BQL
Diethylphthalate	360	BQL
2,4-Dimethylphenol	360	BQL
Dimethylphthalate	360	BQL
4,6-Dinitro-2-methylphenol	1800	BQL
2,4-Dinitrophenol	1800	BQL
2,4-Dinitrotoluene	360	BQL
2,6-Dinitrotoluene	360	BQL
Fluoranthene	360	BQL
Fluorene	360	BQL
Hexachlorobenzene	360	BQL
Hexachlorobutadiene	360	BQL
Hexachlorocyclopentadiene	720	BQL
Hexachloroethane	360	BQL
Indeno(1,2,3-c,d)pyrene	360	BQL
Isophorone	360	BQL

Results for Semivolatiles
by GCMS 8270

Client Sample ID: DP304 - 0.5'
Client Project ID: Kuhlman Electric
Lab Sample ID: 93676
Lab Project ID: G185-78
Matrix: Soil %Solids: 86.5

Date Collected: 8/16/00
Date Received: 8/18/00
Date Analyzed: 8/30/00
Analyzed By: MRC
Dilution: 1

Compound	Quantitation Limit (ug/KG)	Result (ug/KG)
2-Methylnaphthalene	360	BQL
2-Methylphenol	360	BQL
3- & 4-Methylphenol	360	BQL
N-Nitrosodi-n-propylamine	360	BQL
N-Nitrosodiphenylamine	360	BQL
Naphthalene	360	BQL
2-Nitroaniline	360	BQL
3-Nitroaniline	360	BQL
4-Nitroaniline	360	BQL
Nitrobenzene	360	BQL
2-Nitrophenol	360	BQL
4-Nitrophenol	1800	BQL
Pentachlorobenzene	360	BQL
Pentachlorophenol	1800	BQL
Phenanthrene	360	BQL
Phenol	360	BQL
Pyrene	360	BQL
1,2,3,4-Tetrachlorobenzene	360	BQL
1,2,3,5- & 1,2,4,5-Tetrachlorobenzene	360	BQL
1,2,3-Trichlorobenzene	360	BQL
1,2,4-Trichlorobenzene	360	BQL
1,3,5-Trichlorobenzene	360	BQL
2,4,5-Trichlorophenol	360	BQL
2,4,6-Trichlorophenol	360	BQL

Surrogate Spike Recoveries	Spike Added	Spike Result	Percent Recovered
2-Fluorobiphenyl	10	10	100
2-Fluorophenol	10	9.5	95
Nitrobenzene-d5	10	9.9	99
Phenol-d6	10	10.1	101
2,4,6-Tribromophenol	10	10.6	106
4-Terphenyl-d14	10	9.8	98

Comments:

Results are corrected for %solids and dilution where applicable.

Flags:

BQL = Below Quantitation Limit.

Reviewed By:

PARAGON ANALYTICAL LABORATORIES, INC.

Results of Library Search for Semivolatile Compounds

by GCMS

Client Sample ID: DP304 - 0.5'
Client Project ID: Kuhlman Electric
Lab Sample ID: 93676
Lab Project ID: G185-78
Matrix: Soil %SOLIDS 86.5

Date Collected: 8/16/00
Date Received: 8/18/00
Date Analyzed: 8/30/00
Analyzed By: MRC
Dilution: 1

Num.	Compound	CAS#	Match Probability	Result (ug/KG)
1	Alkane, Unknown			1700
2	Unknown			1100
3	Alkane, Unknown			960
4	Carboxylic Acid, Unknown			860
5	Alkane, Unknown			790
6	Unknown			700
7	Unknown			430
8	Unknown			370
9	Unknown			340
10	Vanillin	000121-33-5	91	340

Comment:

Tentatively Identified Compound (TIC) refers to substances which are not present in the list of target compounds. Therefore, not all TICs are identified and quantitated using individual standards. TIC listings are prepared utilizing a computerized library search of electron impact mass spectral data and evaluation of the relevant data by a mass spectral data specialist.

Quantitation is accomplished by relative peak height of the compound compared to that of the nearest internal standard from the total ion chromatogram. TICs are identified and quantitated only if the peak height is equal to or greater than 10% of that of the nearest internal standard. Quantitation provided is an estimate.

Reviewed by: _____

PARADIGM ANALYTICAL LABORATORIES INC.

Results for PCBs
by EPA 8082

Client Sample ID: DP305 - 0.5'
Client Project ID: Kuhlman Electric
Lab Sample ID: 93677
Lab Project ID: G185-78
Matrix: Soil %SOLIDS: 81.5

Date Collected: 8/16/00
Date Received: 8/18/00
Date Analyzed: 8/30/00
Analyzed By: CLP
Dilution: 1

Compound	Quantitation Limit (ug/KG)	Result (ug/KG)
Arochlor-1016	190	BQL
Arochlor-1221	190	BQL
Arochlor-1232	190	BQL
Arochlor-1242	190	BQL
Arochlor-1248	190	BQL
Arochlor-1254	190	BQL
Arochlor-1260	190	390
Arochlor-1262	190	BQL

Surrogate Spike Recoveries	Spike Added	Spike Result	Percent Recovered
TCMX	100	69	69

*Sample was quantitated as Aroclor 1260, but appears to contain a mixture of Aroclor 1260 and Aroclor 1262.

Comments:
BQL = Below Quantitation Limit
NA = Not applicable, surrogate diluted out.

Reviewed By:

PARAGON ANALYTICAL LABORATORIES, INC.

Results for Semivolatiles
by GCMS 8270

Client Sample ID: DP305 - 0.5'
Client Project ID: Kuhlman Electric
Lab Sample ID: 93677
Lab Project ID: G185-78
Matrix: Soil %Solids: 81.5

Date Collected: 8/16/00
Date Received: 8/18/00
Date Analyzed: 8/31/00
Analyzed By: MRC
Dilution: 1

Compound	Quantitation Limit (ug/KG)	Result (ug/KG)
Acenaphthene	380	BQL
Acenaphthylene	380	BQL
Anthracene	380	BQL
Benzo[a]anthracene	380	BQL
Benzo[a]pyrene	380	**440**
Benzo[b]fluoranthene	380	**530**
Benzo[g,h,i]perylene	380	**450**
Benzo[k]fluoranthene	380	**380**
Benzoic Acid	760	BQL
Bis(2-chloroethoxy)methane	380	BQL
Bis(2-chloroethyl)ether	380	BQL
Bis(2-chloroisopropyl)ether	380	BQL
Bis(2-ethylhexyl)phthalate	380	BQL
4-bromophenyl phenyl ether	380	BQL
Butylbenzylphthalate	380	BQL
4-Chloroaniline	380	BQL
4-Chloro-3-methylphenol	380	BQL
2-Chloronaphthalene	380	BQL
2-Chlorophenol	380	BQL
4-Chlorophenyl phenyl ether	380	BQL
Chrysene	380	BQL
Di-n-Butylphthalate	380	BQL
Di-n-octylphthalate	380	BQL
Dibenzo[a,h]anthracene	380	BQL
Dibenzofuran	380	BQL
1,2-Dichlorobenzene	380	BQL
1,3-Dichlorobenzene	380	BQL
1,4-Dichlorobenzene	380	BQL
3,3'-Dichlorobenzidine	760	BQL
2,4-Dichlorophenol	380	BQL
Diethylphthalate	380	BQL
2,4-Dimethylphenol	380	BQL
Dimethylphthalate	380	BQL
4,6-Dinitro-2-methylphenol	1900	BQL
2,4-Dinitrophenol	1900	BQL
2,4-Dinitrotoluene	380	BQL
2,6-Dinitrotoluene	380	BQL
Fluoranthene	380	**520**
Fluorene	380	BQL
Hexachlorobenzene	380	BQL
Hexachlorobutadiene	380	BQL
Hexachlorocyclopentadiene	760	BQL
Hexachloroethane	380	BQL
Indeno(1,2,3-c,d)pyrene	380	BQL
Isophorone	380	BQL

Results for Semivolatiles
by GCMS 8270

Client Sample ID: DP305 - 0.5'
Client Project ID: Kuhlman Electric
Lab Sample ID: 93677
Lab Project ID: G185-78
Matrix: Soil %Solids: 81.5

Date Collected: 8/16/00
Date Received: 8/18/00
Date Analyzed: 8/31/00
Analyzed By: MRC
Dilution: 1

Compound	Quantitation Limit (ug/KG)	Result (ug/KG)
2-Methylnaphthalene	380	BQL
2-Methylphenol	380	BQL
3- & 4-Methylphenol	380	BQL
N-Nitrosodi-n-propylamine	380	BQL
N-Nitrosodiphenylamine	380	BQL
Naphthalene	380	BQL
2-Nitroaniline	380	BQL
3-Nitroaniline	380	BQL
4-Nitroaniline	380	BQL
Nitrobenzene	380	BQL
2-Nitrophenol	380	BQL
4-Nitrophenol	1900	BQL
Pentachlorobenzene	380	BQL
Pentachlorophenol	1900	BQL
Phenanthrene	380	BQL
Phenol	380	BQL
Pyrene	380	420
1,2,3,4-Tetrachlorobenzene	380	BQL
1,2,3,5- & 1,2,4,5-Tetrachlorobenzene	380	BQL
1,2,3-Trichlorobenzene	380	BQL
1,2,4-Trichlorobenzene	380	BQL
1,3,5-Trichlorobenzene	380	BQL
2,4,5-Trichlorophenol	380	BQL
2,4,6-Trichlorophenol	380	BQL

Surrogate Spike Recoveries	Spike Added	Spike Result	Percent Recovered
2-Fluorobiphenyl	10	9.1	91
2-Fluorophenol	10	5.2	52
Nitrobenzene-d5	10	9.1	91
Phenol-d6	10	7.5	74
2,4,6-Tribromophenol	10	6.6	66
4-Terphenyl-d14	10	9.7	97

Comments:

Results are corrected for %solids and dilution where applicable.

Flags:

BQL = Below Quantitation Limit.

Reviewed By:

PARAGM ANALYTICAL LABORATORIES, INC.

Results of Library Search for Semivolatile Compounds

by GCMS

Client Sample ID: DP305 - 0.5'
Client Project ID: Kuhlman Electric
Lab Sample ID: 93677
Lab Project ID: G185-78
Matrix: Soil %SOLIDS 81.5

Date Collected: 8/16/00
Date Received: 8/18/00
Date Analyzed: 8/31/00
Analyzed By: MRC
Dilution: 1

Num.	Compound	CAS#	Match Probability	Result (ug/KG)
1	Unknown			1800
2	Carboxylic Acid, Unknown			1600
3	Unknown			920
4	Unknown			780
5	Alkane, Unknown			770
6	Unknown			740
7	Unknown			500
8	Alkane, Unknown			500
9	Unknown			440
10	Unknown			400

Comment:

Tentatively Identified Compound (TIC) refers to substances which are not present in the list of target compounds. Therefore, not all TICs are identified and quantitated using individual standards. TIC listings are prepared utilizing a computerized library search of electron impact mass spectral data and evaluation of the relevant data by a mass spectral data specialist.

Quantitation is accomplished by relative peak height of the compound compared to that of the nearest internal standard from the total ion chromatogram. TICs are identified and quantitated only if the peak height is equal to or greater than 10% of that of the nearest internal standard. Quantitation provided is an estimate.

Reviewed by: _____

PARADIGM ANALYTICAL LABORATORIES, INC.

Results for PCBs
by EPA 8082

Client Sample ID: DP307 - 0.5'
Client Project ID: Kuhlman Electric
Lab Sample ID: 93678
Lab Project ID: G185-78
Matrix: Soil %SOLIDS: 95.2

Date Collected: 8/16/00
Date Received: 8/18/00
Date Analyzed: 8/30/00
Analyzed By: CLP
Dilution: 1

Compound	Quantitation Limit (ug/KG)	Result (ug/KG)
Arochlor-1016	160	BQL
Arochlor-1221	160	BQL
Arochlor-1232	160	BQL
Arochlor-1242	160	BQL
Arochlor-1248	160	BQL
Arochlor-1254	160	BQL
Arochlor-1260	160	BQL
Arochlor-1262	160	BQL

Surrogate Spike Recoveries	Spike Added	Spike Result	Percent Recovered
TCMX	100	72	72

Comments:
BQL = Below Quantitation Limit
NA = Not applicable, surrogate diluted out.

Reviewed By:

PARADIGM ANALYTICAL LABORATORIES, INC.

Results for Semivolatiles
by GCMS 8270

Client Sample ID: DP307 - 0.5'
Client Project ID: Kuhlman Electric
Lab Sample ID: 93678
Lab Project ID: G185-78
Matrix: Soil %Solids: 95.2

Date Collected: 8/16/00
Date Received: 8/18/00
Date Analyzed: 8/31/00
Analyzed By: MRC
Dilution: 1

Compound	Quantitation Limit (ug/KG)	Result (ug/KG)
Acenaphthene	320	BQL
Acenaphthylene	320	BQL
Anthracene	320	BQL
Benzo[a]anthracene	320	BQL
Benzo[a]pyrene	320	BQL
Benzo[b]fluoranthene	320	BQL
Benzo[g,h,i]perylene	320	BQL
Benzo[k]fluoranthene	320	BQL
Benzoic Acid	640	BQL
Bis(2-chloroethoxy)methane	320	BQL
Bis(2-chloroethyl)ether	320	BQL
Bis(2-chloroisopropyl)ether	320	BQL
Bis(2-ethylhexyl)phthalate	320	BQL
4-bromophenyl phenyl ether	320	BQL
Butylbenzylphthalate	320	BQL
4-Chloroaniline	320	BQL
4-Chloro-3-methylphenol	320	BQL
2-Chloronaphthalene	320	BQL
2-Chlorophenol	320	BQL
4-Chlorophenyl phenyl ether	320	BQL
Chrysene	320	BQL
Di-n-Butylphthalate	320	BQL
Di-n-octylphthalate	320	BQL
Dibenzo[a,h]anthracene	320	BQL
Dibenzofuran	320	BQL
1,2-Dichlorobenzene	320	BQL
1,3-Dichlorobenzene	320	BQL
1,4-Dichlorobenzene	320	BQL
3,3'-Dichlorobenzidine	640	BQL
2,4-Dichlorophenol	320	BQL
Diethylphthalate	320	BQL
2,4-Dimethylphenol	320	BQL
Dimethylphthalate	320	BQL
4,6-Dinitro-2-methylphenol	1600	BQL
2,4-Dinitrophenol	1600	BQL
2,4-Dinitrotoluene	320	BQL
2,6-Dinitrotoluene	320	BQL
Fluoranthene	320	BQL
Fluorene	320	BQL
Hexachlorobenzene	320	BQL
Hexachlorobutadiene	320	BQL
Hexachlorocyclopentadiene	640	BQL
Hexachloroethane	320	BQL
Indeno(1,2,3-c,d)pyrene	320	BQL
Isophorone	320	BQL

Results for Semivolatiles
by GCMS 8270

Client Sample ID: DP307 - 0.5'
Client Project ID: Kuhlman Electric
Lab Sample ID: 93678
Lab Project ID: G185-78
Matrix: Soil
%Solids: 95.2

Date Collected: 8/16/00
Date Received: 8/18/00
Date Analyzed: 8/31/00
Analyzed By: MRC
Dilution: 1

Compound	Quantitation Limit (ug/KG)	Result (ug/KG)
2-Methylnaphthalene	320	BQL
2-Methylphenol	320	BQL
3- & 4-Methylphenol	320	BQL
N-Nitrosodi-n-propylamine	320	BQL
N-Nitrosodiphenylamine	320	BQL
Naphthalene	320	BQL
2-Nitroaniline	320	BQL
3-Nitroaniline	320	BQL
4-Nitroaniline	320	BQL
Nitrobenzene	320	BQL
2-Nitrophenol	320	BQL
4-Nitrophenol	1600	BQL
Pentachlorobenzene	320	BQL
Pentachlorophenol	1600	BQL
Phenanthrene	320	BQL
Phenol	320	BQL
Pyrene	320	BQL
1,2,3,4-Tetrachlorobenzene	320	BQL
1,2,3,5- & 1,2,4,5-Tetrachlorobenzene	320	BQL
1,2,3-Trichlorobenzene	320	BQL
1,2,4-Trichlorobenzene	320	BQL
1,3,5-Trichlorobenzene	320	BQL
2,4,5-Trichlorophenol	320	BQL
2,4,6-Trichlorophenol	320	BQL

Surrogate Spike Recoveries	Spike Added	Spike Result	Percent Recovered
2-Fluorobiphenyl	10	10.7	107
2-Fluorophenol	10	9.1	91
Nitrobenzene-d5	10	10.6	106
Phenol-d6	10	9.9	99
2,4,6-Tribromophenol	10	9	90
4-Terphenyl-d14	10	11.1	111

Comments:

Results are corrected for %solids and dilution where applicable.

Flags:

BQL = Below Quantitation Limit.

Reviewed By:

PARAGON ANALYTICAL LABORATORIES, INC.

Results of Library Search for Semivolatile Compounds

by GCMS

Client Sample ID: DP307 - 0.5'
Client Project ID: Kuhlman Electric
Lab Sample ID: 93678
Lab Project ID: G185-78
Matrix: Soil %SOLIDS 95.2

Date Collected: 8/16/00
Date Received: 8/18/00
Date Analyzed: 8/31/00
Analyzed By: MRC
Dilution: 1

Num.	Compound	CAS#	Match Probability	Result (ug/KG)
1	Unknown			380
2	Unknown			190
3	Unknown			150
4	Unknown			150
5	Unknown			130
6				
7				
8				
9				
10				

Comment:

Tentatively Identified Compound (TIC) refers to substances which are not present in the list of target compounds. Therefore, not all TICs are identified and quantitated using individual standards. TIC listings are prepared utilizing a computerized library search of electron impact mass spectral data and evaluation of the relevant data by a mass spectral data specialist.

Quantitation is accomplished by relative peak height of the compound compared to that of the nearest internal standard from the total ion chromatogram. TICs are identified and quantitated only if the peak height is equal to or greater than 10% of that of the nearest internal standard. Quantitation provided is an estimate.

Reviewed by: _____

PARADIGM ANALYTICAL LABORATORIES INC.

Results for PCBs
by EPA 8082

Client Sample ID: DP310 - 0.5'
Client Project ID: Kuhlman Electric
Lab Sample ID: 93679
Lab Project ID: G185-78
Matrix: Soil %SOLIDS: 83.7

Date Collected: 8/16/00
Date Received: 8/18/00
Date Analyzed: 8/30/00
Analyzed By: CLP
Dilution: 1

Compound	Quantitation Limit (ug/KG)	Result (ug/KG)
Arochlor-1016	190	BQL
Arochlor-1221	190	BQL
Arochlor-1232	190	BQL
Arochlor-1242	190	BQL
Arochlor-1248	190	BQL
Arochlor-1254	190	BQL
Arochlor-1260	190	BQL
Arochlor-1262	190	BQL

Surrogate Spike Recoveries	Spike Added	Spike Result	Percent Recovered
TCMX	100	71	71

Comments:
BQL = Below Quantitation Limit
NA = Not applicable, surrogate diluted out.

Reviewed By:

PAR[illegible]IGM ANALYTICAL LABORATORI[illegible] INC.

Results for Semivolatiles
by GCMS 8270

Client Sample ID: DP310 - 0.5'
Client Project ID: Kuhlman Electric
Lab Sample ID: 93679
Lab Project ID: G185-78
Matrix: Soil %Solids: 83.7

Date Collected: 8/16/00
Date Received: 8/18/00
Date Analyzed: 8/31/00
Analyzed By: MRC
Dilution: 1

Compound	Quantitation Limit (ug/KG)	Result (ug/KG)
Acenaphthene	370	BQL
Acenaphthylene	370	BQL
Anthracene	370	BQL
Benzo[a]anthracene	370	BQL
Benzo[a]pyrene	370	BQL
Benzo[b]fluoranthene	370	BQL
Benzo[g,h,i]perylene	370	BQL
Benzo[k]fluoranthene	370	BQL
Benzoic Acid	730	BQL
Bis(2-chloroethoxy)methane	370	BQL
Bis(2-chloroethyl)ether	370	BQL
Bis(2-chloroisopropyl)ether	370	BQL
Bis(2-ethylhexyl)phthalate	370	BQL
4-bromophenyl phenyl ether	370	BQL
Butylbenzylphthalate	370	BQL
4-Chloroaniline	370	BQL
4-Chloro-3-methylphenol	370	BQL
2-Chloronaphthalene	370	BQL
2-Chlorophenol	370	BQL
4-Chlorophenyl phenyl ether	370	BQL
Chrysene	370	BQL
Di-n-Butylphthalate	370	BQL
Di-n-octylphthalate	370	BQL
Dibenzo[a,h]anthracene	370	BQL
Dibenzofuran	370	BQL
1,2-Dichlorobenzene	370	BQL
1,3-Dichlorobenzene	370	BQL
1,4-Dichlorobenzene	370	BQL
3,3'-Dichlorobenzidine	730	BQL
2,4-Dichlorophenol	370	BQL
Diethylphthalate	370	BQL
2,4-Dimethylphenol	370	BQL
Dimethylphthalate	370	BQL
4,6-Dinitro-2-methylphenol	1800	BQL
2,4-Dinitrophenol	1800	BQL
2,4-Dinitrotoluene	370	BQL
2,6-Dinitrotoluene	370	BQL
Fluoranthene	370	BQL
Fluorene	370	BQL
Hexachlorobenzene	370	BQL
Hexachlorobutadiene	370	BQL
Hexachlorocyclopentadiene	730	BQL
Hexachloroethane	370	BQL
Indeno(1,2,3-c,d)pyrene	370	BQL
Isophorone	370	BQL

Results for Semivolatiles
by GCMS 8270

Client Sample ID: DP310 - 0.5'
Client Project ID: Kuhlman Electric
Lab Sample ID: 93679
Lab Project ID: G185-78
Matrix: Soil %Solids: 83.7

Date Collected: 8/16/00
Date Received: 8/18/00
Date Analyzed: 8/31/00
Analyzed By: MRC
Dilution: 1

Compound	Quantitation Limit (ug/KG)	Result (ug/KG)
2-Methylnaphthalene	370	BQL
2-Methylphenol	370	BQL
3- & 4-Methylphenol	370	BQL
N-Nitrosodi-n-propylamine	370	BQL
N-Nitrosodiphenylamine	370	BQL
Naphthalene	370	BQL
2-Nitroaniline	370	BQL
3-Nitroaniline	370	BQL
4-Nitroaniline	370	BQL
Nitrobenzene	370	BQL
2-Nitrophenol	370	BQL
4-Nitrophenol	1800	BQL
Pentachlorobenzene	370	BQL
Pentachlorophenol	1800	BQL
Phenanthrene	370	BQL
Phenol	370	BQL
Pyrene	370	BQL
1,2,3,4-Tetrachlorobenzene	370	BQL
1,2,3,5- & 1,2,4,5-Tetrachlorobenzene	370	BQL
1,2,3-Trichlorobenzene	370	BQL
1,2,4-Trichlorobenzene	370	BQL
1,3,5-Trichlorobenzene	370	BQL
2,4,5-Trichlorophenol	370	BQL
2,4,6-Trichlorophenol	370	BQL

Surrogate Spike Recoveries	Spike Added	Spike Result	Percent Recovered
2-Fluorobiphenyl	10	9.5	95
2-Fluorophenol	10	8.2	82
Nitrobenzene-d5	10	9.9	99
Phenol-d6	10	9.3	93
2,4,6-Tribromophenol	10	7.1	71
4-Terphenyl-d14	10	10.3	103

Comments:

Results are corrected for %solids and dilution where applicable.

Flags:

BQL = Below Quantitation Limit.

Reviewed By:

PARA[illegible]GM ANALYTICAL LABORATORIE[illegible]NC.

Results of Library Search for Semivolatile Compounds

by GCMS

Client Sample ID:	DP310 - 0.5'			Date Collected:	8/16/00
Client Project ID:	Kuhlman Electric			Date Received:	8/18/00
Lab Sample ID:	93679			Date Analyzed:	8/31/00
Lab Project ID:	G185-78			Analyzed By:	MRC
Matrix:	Soil	%SOLIDS	83.7	Dilution:	1

Num.	Compound	CAS#	Match Probability	Result (ug/KG)
1	Alkane, Unknown			330
2	Unknown			260
3	Unknown			230
4	Unknown			180
5				
6				
7				
8				
9				
10				

Comment:

Tentatively Identified Compound (TIC) refers to substances which are not present in the list of target compounds. Therefore, not all TICs are identified and quantitated using individual standards. TIC listings are prepared utilizing a computerized library search of electron impact mass spectral data and evaluation of the relevant data by a mass spectral data specialist.

Quantitation is accomplished by relative peak height of the compound compared to that of the nearest internal standard from the total ion chromatogram. TICs are identified and quantitated only if the peak height is equal to or greater than 10% of that of the nearest internal standard. Quantitation provided is an estimate.

Reviewed by: [signature]

PARAGON ANALYTICAL LABORATORIES INC.

Results for PCBs
by EPA 8082

Client Sample ID: DP314 - 0.5'
Client Project ID: Kuhlman Electric
Lab Sample ID: 93680
Lab Project ID: G185-78
Matrix: Soil %SOLIDS: 80.7

Date Collected: 8/16/00
Date Received: 8/18/00
Date Analyzed: 8/30/00
Analyzed By: CLP
Dilution: 1

Compound	Quantitation Limit (ug/KG)	Result (ug/KG)
Arochlor-1016	190	BQL
Arochlor-1221	190	BQL
Arochlor-1232	190	BQL
Arochlor-1242	190	BQL
Arochlor-1248	190	BQL
Arochlor-1254	190	BQL
Arochlor-1260	190	BQL
Arochlor-1262	190	BQL

Surrogate Spike Recoveries	Spike Added	Spike Result	Percent Recovered
TCMX	100	64	64

Comments:
BQL = Below Quantitation Limit
NA = Not applicable, surrogate diluted out.

Reviewed By:

PARAGON ANALYTICAL LABORATORIES, INC.

Results for Semivolatiles
by GCMS 8270

Client Sample ID: DP314 - 0.5'
Client Project ID: Kuhlman Electric
Lab Sample ID: 93680
Lab Project ID: G185-78
Matrix: Soil %Solids: 80.7

Date Collected: 8/16/00
Date Received: 8/18/00
Date Analyzed: 8/31/00
Analyzed By: MRC
Dilution: 1

Compound	Quantitation Limit (ug/KG)	Result (ug/KG)
Acenaphthene	390	BQL
Acenaphthylene	390	BQL
Anthracene	390	BQL
Benzo[a]anthracene	390	BQL
Benzo[a]pyrene	390	BQL
Benzo[b]fluoranthene	390	BQL
Benzo[g,h,i]perylene	390	BQL
Benzo[k]fluoranthene	390	BQL
Benzoic Acid	770	BQL
Bis(2-chloroethoxy)methane	390	BQL
Bis(2-chloroethyl)ether	390	BQL
Bis(2-chloroisopropyl)ether	390	BQL
Bis(2-ethylhexyl)phthalate	390	BQL
4-bromophenyl phenyl ether	390	BQL
Butylbenzylphthalate	390	BQL
4-Chloroaniline	390	BQL
4-Chloro-3-methylphenol	390	BQL
2-Chloronaphthalene	390	BQL
2-Chlorophenol	390	BQL
4-Chlorophenyl phenyl ether	390	BQL
Chrysene	390	BQL
Di-n-Butylphthalate	390	BQL
Di-n-octylphthalate	390	BQL
Dibenzo[a,h]anthracene	390	BQL
Dibenzofuran	390	BQL
1,2-Dichlorobenzene	390	BQL
1,3-Dichlorobenzene	390	BQL
1,4-Dichlorobenzene	390	BQL
3,3'-Dichlorobenzidine	770	BQL
2,4-Dichlorophenol	390	BQL
Diethylphthalate	390	BQL
2,4-Dimethylphenol	390	BQL
Dimethylphthalate	390	BQL
4,6-Dinitro-2-methylphenol	1900	BQL
2,4-Dinitrophenol	1900	BQL
2,4-Dinitrotoluene	390	BQL
2,6-Dinitrotoluene	390	BQL
Fluoranthene	390	BQL
Fluorene	390	BQL
Hexachlorobenzene	390	BQL
Hexachlorobutadiene	390	BQL
Hexachlorocyclopentadiene	770	BQL
Hexachloroethane	390	BQL
Indeno(1,2,3-c,d)pyrene	390	BQL
Isophorone	390	BQL

Results for Semivolatiles
by GCMS 8270

Client Sample ID: DP314 - 0.5'
Client Project ID: Kuhlman Electric
Lab Sample ID: 93680
Lab Project ID: G185-78
Matrix: Soil %Solids: 80.7

Date Collected: 8/16/00
Date Received: 8/18/00
Date Analyzed: 8/31/00
Analyzed By: MRC
Dilution: 1

Compound	Quantitation Limit (ug/KG)	Result (ug/KG)
2-Methylnaphthalene	390	BQL
2-Methylphenol	390	BQL
3- & 4-Methylphenol	390	BQL
N-Nitrosodi-n-propylamine	390	BQL
N-Nitrosodiphenylamine	390	BQL
Naphthalene	390	BQL
2-Nitroaniline	390	BQL
3-Nitroaniline	390	BQL
4-Nitroaniline	390	BQL
Nitrobenzene	390	BQL
2-Nitrophenol	390	BQL
4-Nitrophenol	1900	BQL
Pentachlorobenzene	390	BQL
Pentachlorophenol	1900	BQL
Phenanthrene	390	BQL
Phenol	390	BQL
Pyrene	390	BQL
1,2,3,4-Tetrachlorobenzene	390	BQL
1,2,3,5- & 1,2,4,5-Tetrachlorobenzene	390	BQL
1,2,3-Trichlorobenzene	390	BQL
1,2,4-Trichlorobenzene	390	BQL
1,3,5-Trichlorobenzene	390	BQL
2,4,5-Trichlorophenol	390	BQL
2,4,6-Trichlorophenol	390	BQL

Surrogate Spike Recoveries	Spike Added	Spike Result	Percent Recovered
2-Fluorobiphenyl	10	9.9	99
2-Fluorophenol	10	3.2	32
Nitrobenzene-d5	10	10.1	101
Phenol-d6	10	5.8	58
2,4,6-Tribromophenol	10	1.5	15
4-Terphenyl-d14	10	10.2	102

Comments:

Results are corrected for %solids and dilution where applicable.

Flags:

BQL = Below Quantitation Limit

Reviewed By:

PARAGON ANALYTICAL LABORATORIES, INC.

Results of Library Search for Semivolatile Compounds

by GCMS

Client Sample ID: DP314 - 0.5'
Client Project ID: Kuhlman Electric
Lab Sample ID: 93680
Lab Project ID: G185-78
Matrix: Soil %SOLIDS 80.7

Date Collected: 8/16/00
Date Received: 8/18/00
Date Analyzed: 8/31/00
Analyzed By: MRC
Dilution: 1

Num.	Compound	CAS#	Match Probability	Result (ug/KG)
1	Alkane, Unknown			930
2	Alkane, Unknown			850
3	Unknown			800
4	Alkane, Unknown			650
5	Unknown			540
6	Alkane, Unknown			470
7	Unknown			390
8	Vanillin	000121-33-5	90	320
9	Alkane, Unknown			280
10	Unknown			200

Comment:

Tentatively Identified Compound (TIC) refers to substances which are not present in the list of target compounds. Therefore, not all TICs are identified and quantitated using individual standards. TIC listings are prepared utilizing a computerized library search of electron impact mass spectral data and evaluation of the relevant data by a mass spectral data specialist.

Quantitation is accomplished by relative peak height of the compound compared to that of the nearest internal standard from the total ion chromatogram. TICs are identified and quantitated only if the peak height is equal to or greater than 10% of that of the nearest internal standard. Quantitation provided is an estimate.

Reviewed by: _____

PARAGON ANALYTICAL LABORATORIES, INC.

Results for PCBs
by EPA 8082

Client Sample ID: DP315 - 0.5'
Client Project ID: Kuhlman Electric
Lab Sample ID: 93681
Lab Project ID: G185-78
Matrix: Soil %SOLIDS: 90.8

Date Collected: 8/16/00
Date Received: 8/18/00
Date Analyzed: 8/30/00
Analyzed By: CLP
Dilution: 1

Compound	Quantitation Limit (ug/KG)	Result (ug/KG)
Arochlor-1016	170	BQL
Arochlor-1221	170	BQL
Arochlor-1232	170	BQL
Arochlor-1242	170	BQL
Arochlor-1248	170	BQL
Arochlor-1254	170	BQL
Arochlor-1260	170	BQL
Arochlor-1262	170	BQL

Surrogate Spike Recoveries	Spike Added	Spike Result	Percent Recovered
TCMX	100	74	74

Comments:
BQL = Below Quantitation Limit
NA = Not applicable, surrogate diluted out.

Reviewed By: [signature]

PARAGON ANALYTICAL LABORATORIES, INC.

Results for Semivolatiles
by GCMS 8270

Client Sample ID: DP315 - 0.5'
Client Project ID: Kuhlman Electric
Lab Sample ID: 93681
Lab Project ID: G185-78
Matrix: Soil %Solids: 90.8

Date Collected: 8/16/00
Date Received: 8/18/00
Date Analyzed: 8/31/00
Analyzed By: MRC
Dilution: 1

Compound	Quantitation Limit (ug/KG)	Result (ug/KG)
Acenaphthene	340	BQL
Acenaphthylene	340	BQL
Anthracene	340	BQL
Benzo[a]anthracene	340	BQL
Benzo[a]pyrene	340	BQL
Benzo[b]fluoranthene	340	BQL
Benzo[g,h,i]perylene	340	BQL
Benzo[k]fluoranthene	340	BQL
Benzoic Acid	690	BQL
Bis(2-chloroethoxy)methane	340	BQL
Bis(2-chloroethyl)ether	340	BQL
Bis(2-chloroisopropyl)ether	340	BQL
Bis(2-ethylhexyl)phthalate	340	BQL
4-bromophenyl phenyl ether	340	BQL
Butylbenzylphthalate	340	BQL
4-Chloroaniline	340	BQL
4-Chloro-3-methylphenol	340	BQL
2-Chloronaphthalene	340	BQL
2-Chlorophenol	340	BQL
4-Chlorophenyl phenyl ether	340	BQL
Chrysene	340	BQL
Di-n-Butylphthalate	340	BQL
Di-n-octylphthalate	340	BQL
Dibenzo[a,h]anthracene	340	BQL
Dibenzofuran	340	BQL
1,2-Dichlorobenzene	340	BQL
1,3-Dichlorobenzene	340	BQL
1,4-Dichlorobenzene	340	BQL
3,3'-Dichlorobenzidine	690	BQL
2,4-Dichlorophenol	340	BQL
Diethylphthalate	340	BQL
2,4-Dimethylphenol	340	BQL
Dimethylphthalate	340	BQL
4,6-Dinitro-2-methylphenol	1700	BQL
2,4-Dinitrophenol	1700	BQL
2,4-Dinitrotoluene	340	BQL
2,6-Dinitrotoluene	340	BQL
Fluoranthene	340	BQL
Fluorene	340	BQL
Hexachlorobenzene	340	BQL
Hexachlorobutadiene	340	BQL
Hexachlorocyclopentadiene	690	BQL
Hexachloroethane	340	BQL
Indeno(1,2,3-c,d)pyrene	340	BQL
Isophorone	340	BQL

Results for Semivolatiles
by GCMS 8270

Client Sample ID: DP315 - 0.5'
Client Project ID: Kuhlman Electric
Lab Sample ID: 93681
Lab Project ID: G185-78
Matrix: Soil %Solids: 90.8

Date Collected: 8/16/00
Date Received: 8/18/00
Date Analyzed: 8/31/00
Analyzed By: MRC
Dilution: 1

Compound	Quantitation Limit (ug/KG)	Result (ug/KG)
2-Methylnaphthalene	340	BQL
2-Methylphenol	340	BQL
3- & 4-Methylphenol	340	BQL
N-Nitrosodi-n-propylamine	340	BQL
N-Nitrosodiphenylamine	340	BQL
Naphthalene	340	BQL
2-Nitroaniline	340	BQL
3-Nitroaniline	340	BQL
4-Nitroaniline	340	BQL
Nitrobenzene	340	BQL
2-Nitrophenol	340	BQL
4-Nitrophenol	1700	BQL
Pentachlorobenzene	340	BQL
Pentachlorophenol	1700	BQL
Phenanthrene	340	BQL
Phenol	340	BQL
Pyrene	340	BQL
1,2,3,4-Tetrachlorobenzene	340	BQL
1,2,3,5- & 1,2,4,5-Tetrachlorobenzene	340	BQL
1,2,3-Trichlorobenzene	340	BQL
1,2,4-Trichlorobenzene	340	BQL
1,3,5-Trichlorobenzene	340	BQL
2,4,5-Trichlorophenol	340	BQL
2,4,6-Trichlorophenol	340	BQL

Surrogate Spike Recoveries	Spike Added	Spike Result	Percent Recovered
2-Fluorobiphenyl	10	10.4	104
2-Fluorophenol	10	9	90
Nitrobenzene-d5	10	10.5	105
Phenol-d6	10	9.9	99
2,4,6-Tribromophenol	10	9	90
4-Terphenyl-d14	10	10.9	109

Comments:

Results are corrected for %solids and dilution where applicable.

Flags:

BQL = Below Quantitation Limit.

Reviewed By: MN

PARAGON ANALYTICAL LABORATORIES, INC.

Results of Library Search for Semivolatile Compounds

by GCMS

Client Sample ID: DP315 - 0.5'
Client Project ID: Kuhlman Electric
Lab Sample ID: 93681
Lab Project ID: G185-78
Matrix: Soil %SOLIDS 90.8

Date Collected: 8/16/00
Date Received: 8/18/00
Date Analyzed: 8/31/00
Analyzed By: MRC
Dilution: 1

Num.	Compound	CAS#	Match Probability	Result (ug/KG)
1	Unknown			440
2	Unknown			400
3	Unknown			260
4	Unknown			160
5				
6				
7				
8				
9				
10				

Comment:

Tentatively Identified Compound (TIC) refers to substances which are not present in the list of target compounds. Therefore, not all TICs are identified and quantitated using individual standards. TIC listings are prepared utilizing a computerized library search of electron impact mass spectral data and evaluation of the relevant data by a mass spectral data specialist.

Quantitation is accomplished by relative peak height of the compound compared to that of the nearest internal standard from the total ion chromatogram. TICs are identified and quantitated only if the peak height is equal to or greater than 10% of that of the nearest internal standard. Quantitation provided is an estimate.

Reviewed by: _____

BorgWarner Inc. 200 South Michigan Avenue Chicago Illinois 60604 Telephone 312 322 8500

AH-00-1638

VIA UPS NEXT DAY AIR

BorgWarner

December 20, 2000

Anastasia Hamel
Director, Environmental Programs
BorgWarner Inc.
11955 East Nine Mile Road
Warren, Michigan 48089

Ms. Gretchen Zmitrovich
Mississippi Department of Environmental Quality
Office of Pollution Control
101 West Capitol Street
Jackson, Mississippi 39201

FILE COPY

Re: **Progress Report of Assessment and Remediation Activities**
Kuhlman Electric Corporation and Residential Properties
Crystal Springs, Mississippi

Dear Ms. Zmitrovich:

This is a progress report to summarize the assessment and remediation activities related to PCB contamination at Crystal Springs, Mississippi. BorgWarner's last update was October 31, 2000. As you are aware, pursuant to the indemnity agreement between Kuhlman Electric Corporation (KEC) and BorgWarner Inc., BorgWarner has continued the assessment at the KEC plant and began the assessment of residential properties along a drainage channel downgradient of the plant. BorgWarner has also been actively remediating those properties adjacent to the KEC plant for which access was previously granted and sampling was complete.

BorgWarner, as it stated in its October 31, 2000 letter to the Mississippi Department of Environmental Quality (MDEQ), remains committed to working closely with MDEQ, USEPA, local government and KEC in a cooperative manner to accomplish the tasks necessary for the protection of human health and the environment, to the extent that the circumstances are covered by its contractual indemnity to KEC. BorgWarner will continue to seek MDEQ's guidance and direction in its current and future intended activities and to promptly share information.

ACTIONS TAKEN AND PLANNED

1. Delineation of Residential Properties along Jackson and Lee Avenues

BorgWarner promptly and voluntarily began sampling and delineation activities at the residential and commercial properties, adjoining the KEC plant that appeared to or reportedly have been affected by runoff or by the removal of soil from the KEC plant prior to October 6, 1999.

Under MDEQ's supervision, BorgWarner conducted delineation activities of these properties during the month of August, 2000. A total of eighteen (18) properties were investigated, which were:

1. Perry Smith, 219 North Jackson Street
2. Stringer Funeral Home, 301 North Jackson Street
3. Stringer Rental Property, 303 North Jackson Street
4. Harold and Suzanne Warren, 403 North Jackson Street
5. Elnor Wright, 401 North Jackson Street
6. Sonny Reeves, 405 North Jackson Street
7. Brent Property, 403 Lee Avenue
8. Louie Lang/David Vinson, 407 North Jackson Street
9. Jerry Youngblood, 100 Lamar St.
10. Medical Clinic, Lee Avenue
11. Edwards Property, 406 Lee Avenue
12. Garment Shop, 414 Lee Avenue
13. Frazier Property, 405 Lee Avenue
14. Duplex Property, 408/410 Lee Avenue
15. Kellum Property, 412 Lee Avenue
16. Dabney/Smith Property, 215 North Jackson
17. Cooper Property, 409 North Jackson
18. Larry and Carol Wright, 305 North Jackson

BorgWarner acted under the continuous guidance and direction of the MDEQ with respect to delineation activities at the residential and commercial properties adjoining the KEC plant. Split samples were analyzed and QA/QC procedures were implemented by two laboratories experienced with polychlorinated biphenyl analysis. Samples were frequently split with on-site MDEQ representatives for MDEQ's independent analysis, which to our knowledge consistently correlated with BorgWarner's on-site and off-site laboratory analytical results.

The delineation activities were conducted utilizing the " US EPA, Region IV Environmental Investigations Standard Operating Procedures and Quality Assurance Manual," May 1996 (EISOPQAM), sampling and analytical protocols. A copy of the work plan with procedures used in the field and applicable sections of the EISOPQAM are attached to this report for reference purposes.

Upon completing the delineation activities, BorgWarner compiled and submitted the analytical results on October 2, 2000 to MDEQ and US EPA, Region IV. Subsequently, BorgWarner began to schedule the remediation of residential and commercial properties adjacent to the KEC plant and along Jackson and Lee Avenues for which access was granted with the assistance of MDEQ and City of Crystal Springs Mayor Webb and where an attorney and/or an independent consultant were not involved in performing conflicting sampling activities.

2. Remediation of Residential Properties

On October 16, 2000 BorgWarner initiated remediation activities at the Medical Center and the Dabney/Smith properties, which are adjacent to the KEC plant. Remediation of the Newman Duplex, on Lee Avenue, began on November 30, 2000. Remediation of these properties involved excavation and disposal of all soil containing 1.0 part per million (ppm) or greater of PCBs in accordance with MDEQ's established clean-up criteria for residential properties. All soils containing greater than 1 ppm PCBs but less than 50 ppm PCBs were profiled and disposed of at the BFI's "Little Dixie" Subtitle D Landfill in Madison County, Mississippi after MDEQ and US EPA, Region IV approvals were obtained.

Following excavation, all excavated areas were sampled to confirm that impacted soil had been removed. In correspondence regarding disposal requirements, Craig Brown of US EPA, Region IV, stated that the excavated soils did not meet the definition of "PCB remediation waste." Under this definition, the remediation activities fell under the management criteria and guidelines set by MDEQ. As a result, the remediation and confirmation of clean-up standards established by MDEQ guidance were adopted and implemented in all of BorgWarner's residential remediation activities. A grid with ten-foot (10) sampling point centers was used to confirm that impacted soils had been removed at each site.

The remediation of the Dabney/Smith, the Medical Center and the Newman duplex property resulted in the removal of 1400 tons of soil, which was disposed of at the BFI "Little Dixie" Subtitle D Landfill and replaced with 1500 tons of certified clean soil. During the remediation activities, the on-site laboratory analyzed 324 soil samples in the month of November and the fixed-base laboratory analyzed 32 quality control samples.

Vegetation, such as live oak trees, was treated with specialty equipment for maximum protection and to minimize damage to the root systems. Soil surrounding the live oak tree roots was removed using an "Air Shovel"™, a unique technology adopted specifically for this purpose. The Air Shovel™ uses a pressure spray to dislodge soil from around the roots while a vacuum system removes the soil and water by vacuuming into a tank. This method of soil removal has performed effectively with minimal damage to the tree's root system as was confirmed by the landscaping contractor and arborist. However, this process, regardless of its effectiveness, is very tedious and as a result only the tree on the Dabney/Smith property was completed during the second half of November. One other live oak tree, located on the Medical Center property, remains to be treated in a similar fashion and is scheduled for January 2001.

Landscaping and replacement of structures (sheds, car ports, etc.) on both the Medical Center and the Dabney/Smith properties are continuing and will most likely be completed by the end of December 2000. Both properties have been surveyed and the fence between the Dabney/Smith and Medical Center properties is currently being re-installed. Landscaping has been completed on the Newman duplex property.

Third party independent sampling activities commissioned by the Nutt & Associates Law Firm have interfered with planned remediation activities along Lee Avenue, specifically at the Frazier's, Edward's, and Kellum's properties. The Garment Shop is a more complicated matter for two reasons. First, the impacted soil at the Garment Shop is located at the property line between it and the Kellum residence and second, the Kellum elm tree roots extend to the Garment Shop property itself. BorgWarner has filed a Freedom of Information Act request to MDEQ in an effort to obtain a copy of the recently submitted report generated by these independent parties.

BorgWarner, after its evaluation of the sampling results and data contained within the third party report, will begin discussions with the attorney(s) representing each resident (mentioned above) along Lee Avenue in an attempt to resolve the matter, including confirmation that all sampling results have been disclosed, and whether further sampling is necessary, and confirm access to then remediate those properties. BorgWarner also plans to keep MDEQ appraised of any developments and any progress or if no progress is being made with the attorney(s) involved.

BorgWarner will schedule delineation activities for the Gas Station, which is at the corner of Lee Avenue next to the Garment Shop, Mayor Webb's residence and the drainage pathway to the south. BorgWarner will inform MDEQ of the timing for those activities.

3. Drainage Channel Properties

Beginning on October 30th through the end of November, BorgWarner collected and analyzed soil samples from nine properties situated along the drainage channel leading from the north side of KEC's plant site to Lake Chautauqua. The properties were:

1. Sojourner Property, 111 McPherson Street
2. Weathersby Property, 101 Forest Street
3. Robert Williams Property (Lonnie Williams' residence), 103 Forest Street
4. Flossie McMurray Property (Ralph Williams residence), 104 Forest Street
5. Ralph Williams Rental Property, 107 Forest Street
6. Richard Williams Property, 102 Forest Street
7. Roberta Fitzgerald Estate Property, (R.P Edwards point of contact) 108 Tucker Street Property currently is being rented to the Kendrick family.
8. Welch Property, 501 Camp Street
9. Orister Harris Property, 311 West Railroad Avenue

A total of 650 soil samples was collected from these properties and analyzed by the on-site laboratory. The fixed-base laboratory analyzed an additional 65 samples for confirmation and quality control purposes. These preliminary assessment activities were conducted in the same manner as the Kuhlman plant preliminary site assessment and the KEC plant adjacent residential properties; and utilizing the "EPA, Region IV Environmental Investigations Standard Operating

Procedures and Quality Assurance Manual", May 1996 (EISOPQAM), sampling and analytical protocols.

Preliminary results available at this time indicate that six of the nine properties that were sampled will require certain remediation. Four properties, including the Sojourner, Williams' rental, Harris and Welch properties, will require remediation under the MDEQ guidelines since the highest concentrations detected are less than 50 ppm. Two properties, including the McMurray and R. P. Edwards properties, have soil with PCB concentrations greater than 50 ppm and therefore will require remediation under the TSCA rules. The following is a list of properties where concentrations greater than 1.0 ppm PCB were detected as well as the highest detected concentration on each property:

Property	Highest Detected Concentration
Sojourner	2.6 ppm
Williams rental	30.0 ppm
Harris	1.2 ppm
Welch	8.4 ppm
McMurray	70.0 ppm
R. P. Edwards	51.0 ppm

Data from this sampling event are being evaluated and once quality control measures are completed the data will be tabulated. Site-specific reports containing collected data, maps of sampling locations, and work plans for remediation, if required, for each individual site are also being prepared and will be submitted to MDEQ and US EPA, Region IV by January 12, 2001.

It is anticipated that additional sampling will be required along the drainage channel. Several undeveloped properties, either abutting the drainage channel or through which the drainage channel runs, will be sampled to delineate the extent of possibly impacted soil and determine the potential for future runoff to Lake Chautauqua. The Department will be kept appraised as to the timing for this additional investigation and sampling activity.

4. KEC Plant

After an initial phase of sampling in the areas identified by KEC's construction activities and the related equipment decontamination zone, BorgWarner conducted further, substantial sampling activities in the south and north parking lot areas as well as the former above ground storage tank area. These delineation activities, other than any possible data gaps, have been completed. The results are currently being tabulated and compared for correlation purposes between the on-site and off-site laboratories, prior to being issued to MDEQ. Should any data gaps exist, BorgWarner will conduct further sampling activities.

This additional data will be incorporated as an addendum to the *Preliminary Site Assessment Report,* submitted to MDEQ in July 2000. Comments to the *Preliminary Site Assessment Report* made by MDEQ will also be addressed and included in the addendum submittal. It is anticipated that the addendum report will be submitted to MDEQ by February 12, 2001.

5. Lake Chautauqua

BorgWarner intends to consider delineation of the sediments at Lake Chautauqua, ecological assessment, and surface water sampling, to the extent appropriate after receipt of the pending "Task Force" report. These activities will not begin on any great scale until the Task Force report is evaluated.

6. Groundwater Delineation

BorgWarner intends to delineate the nature and extent of any groundwater contamination relative to the KEC plant. Groundwater delineation will take place at the time that remediation at the KEC plant commences. It is critical that the protective cover at the KEC plant site is not disturbed for the time being and that the groundwater investigation is addressed when BorgWarner is actively remediating on the KEC plant property. This approach will ensure that sediments from the KEC Plant do not travel to the drainage channel and Lake Chautauqua.

BorgWarner remains dedicated to continuing its open communication with MDEQ and US EPA, Region IV and looks forward to the meeting with MDEQ and City of Crystal Springs Mayor Webb and other Crystal Springs representatives on January 17, 2001 (at 8:30 a.m.) to further discuss any of the above and share its plans for future activities.

Should you have any questions or comments, please contact me directly at (810) 497-4503 at your earliest convenience.

Very truly yours,

Anastasia Hamel

Anastasia Hamel
Director, Environmental Programs
BorgWarner Inc.

Attachments:

1. Work Plan – Preliminary Assessment and Remediation
2. Craig Brown, US EPA, Region IV letter to BFI

cc: J. Banks, MDEQ
T. Russell, MDEQ
K. Dowell, Esq., MDEQ
C. Brown, US EPA Region IV
H. Webb, Mayor Crystal Springs
Laurene H. Horiszny, Esq.
Robert Martin, MSGA
Thomas D. Lupo, Esq.
Scott E. Schang, Esq.
Mickey Crockett, KEC
Al Thomas, KEC

WORKPLAN FOR THE PRELIMINARY ASSESSMENT AND REMEDIATION OF PCB CONTAMINATION IN SOIL KUHLMAN ELECTRIC CORPORATION FACILITY AND RESIDENTIAL COMMERCIAL PROPERTIES IN CRYSTAL SPRINGS, MISSISSIPPI

As established by the Mississippi Department of Environmental Quality (MDEQ) guidelines in connection with this project, all work related to the preliminary assessment of the extent of contamination at the Kuhlman Electric Corporation (KEC) facility and work related to the preliminary assessment and confirmation of remedial actions at KEC adjacent residential/commercial properties and residential properties along the drainage channel (leading from the north side of KEC's facility to Lake Chautauqua) has been performed in accordance with the *Environmental Protection Agency (EPA), Region IV "Environmental Investigations, Standard Operating Procedures and Quality Assurance Manual", May 1996 (EISOPQAM).*

Copies of relevant and applicable portions of the EISOPQAM are maintained on site during all field activities and all field personnel are trained in its implementation. Remedial action confirmation sampling grids were established using *MDEQ Guidance Document, Verification of Soil Remediation, Environmental Response Division, Waste Management Division, April 1994, Revision 1.* Specifically, sampling grids were based on Part 2-Medium and Large Site Soil Cleanup Verification, "Establishing Grid Interval."

Field operations were performed under the site-specific Health and Safety Plan guidelines. Modified Level "D" Personal Protective Equipment (PPE) was utilized by all personnel working within the investigative area.

Sampling Objectives

The soil-sampling objective is to establish the vertical and horizontal extent of contamination resulting from historical facility operations. In the KEC facility case, the soil-sampling objective included historical use of polychlorinated biphenyl (PCB). All sampling procedures were conducted in accordance with the US EPA, Region IV EISOPQAM. Sampling procedures included the collection of soil samples on a twenty foot triangular grid, where possible, at discreet depth intervals. Surface and subsurface soil samples were collected using GeoProbe® MacroProbe™ direct push sampling equipment. The GeoProbe® system uses a hydraulically driven hammer to advance a hollow, split-barrel sampler to the desired depth. The sampler contains an acetate liner in which a sample of the cored soil is retained. The MacroProbe™ corer retains a 1.25-inch diameter continuous 4 feet in length core sample. Once sampling is completed, the direct-push boring holes are backfilled with bentonite chips in unpaved areas, and with grout in parking lots and other paved areas.

Throughout the delineation activities each direct-push boring was sampled at 0.5-3.0 feet below ground surface (bgs) and at 3.0-6.0 feet bgs. Selected borings were completed to depths varying from 8-12 feet bgs and sampled in these deeper intervals to evaluate the vertical distribution of contaminants.

Additional sampling of dust, stream and drainage ditch sediments, surface water and ground water were collected, as warranted, in accordance with applicable EISOPQAM guidelines.

Analytical Methods

Samples that were collected were analyzed for PCBs by the on-site mobile laboratory, Environmental Chemistry Consulting Services (ECCS) of Madison, Wisconsin. Initially soil samples were also analyzed for chlorinated benzenes until data confirmed that chlorinated benzene contamination is not at issue in samples with low concentrations of PCBs (generally <20 ppm). At least 10% of all samples were split and sent to a fixed-base laboratory, Paradigm Analytical Laboratories, Inc. (PAL) of Wilmington, North Carolina for analysis of the same parameters as for the on-site mobile laboratory to corroborate the results of laboratory analyses for quality control and quality assurance measures. Both the on-site and fixed-base laboratories used the same standard EPA approved analytical methods. PCBs were analyzed by Modified Environmental Protection Agency (EPA) Method 8080/81 and chlorinated benzene compounds were analyzed by EPA Method 8270. Volatile organic compounds (VOCs) were analyzed by EPA Method 8260 for samples suspected of being impacted by other industrial processes solvents unrelated to PCBs. Select soil samples were also analyzed for silver, by EPA Method 6010B, and cyanide, by EPA Method 9012A.

Surface water samples were analyzed by PAL for PCBs using EPA Method 8080/81. Semivolatile organic compounds (SVOCs) were analyzed by EPA Method 8270, Volatile Organic Compounds (VOCs) were analyzed by EPA Method 8260, silver by EPA Method 6010B, and cyanide using Standard Method 4500 Cn-E. Perched ground water was analyzed for PCBs, SVOCs, and VOCs by the same methods as indicated above for surface water.

Quality Control

The following is the list of key personnel dedicated to this project:

Project Manager:	Mr. Robert Martin, Martin & Slagle GeoEnvironmental Associates, LLC
Duties:	Responsible for management of project including all field coordination efforts.
Field Sample Custodian:	Mr. Robert Martin, Christine Slagle, Martin & Slagle GeoEnvironmental Associates, LLC
Duties:	Maintaining custody of samples, completing sample labels, Chain-of-Custody record.
Field Team Leader:	Mr. Robert Martin, Martin & Slagle GeoEnvironmental Associates, LLC
Duties:	Responsible for all activities related to the collection of samples.
Samplers:	Tim Fitzpatrick, Christine Slagle, Robert Martin
Duties:	Individuals responsible for the actual collection of samples.
Laboratory Sample Custodian:	Mr. Michael Linskens, ECCS Mr. Nicolas Schertz, ECCS Ms. Erin Staagard, PAL
Duties:	Individuals responsible for accepting custody of samples from the field sample custodian.

Quality Assurance Objectives for Data

Data for this project is being generated by two separate entities. The on-site data is generated by ECCS in their mobile laboratory. The fixed-base laboratory, PAL in Wilmington, North Carolina, generates the analytical results for the split samples.

The data quality objectives are pre-defined for the ECCS data in that Mississippi considers all mobile lab data screening level data. ECCS uses the same equipment and methodology as the fixed-base laboratories with the exception of the mini-extraction modification. Mobile laboratory data is validated by comparison of a minimum of 10% split samples with PAL. Following this procedure, the data qualifies as screening data with definitive confirmation under US EPA, Region IV EISOPQAM guidelines.

All samples sent to PAL were collected as follows: The sample was transferred from the GeoProbe® clean, unused, acetate sample liner into the labeled 4 ounce (oz) amber glass soil jar. The sample jar was then transferred to the mobile lab where ECCS personnel homogenized the sample prior to taking an aliquot for analysis. Due to the limited sample volume required by the ECCS mini-extraction and the low volatility of the chemicals of concern, the initial sampling jar was resealed (after ECCS personnel removed the amount of sample needed for their analysis), refrigerated and then sent to PAL; meaning PAL analyzed the sample from the exact same sample jar as ECCS.

Equipment rinsate samples were collected for evaluation of cross-contamination potential from ineffective decontamination procedures. These were prepared by pouring distilled water over the sampling equipment after decontamination and collecting and preserving the rinsate that was generated. Equipment rinseate samples were collected in accordance with the EPA, Region IV EISOPQAM guidelines.

Field blank samples were collected by filling sampling containers that were kept in the transition zone with distilled water. Field blanks determine the presence of ambient contaminants that may not be directly related to concentrations of contaminants in the sample media.

Blind duplicate soil samples were collected for analysis and sent to both laboratories. Blind duplicates were collected by homogenizing an aliquot of sample in a disposable plastic container and splitting the homogenized sample into two containers. After ECCS took their aliquot of these samples, the remainder of the sample was sent to PAL for analysis.

SAMPLE CONTROL AND FIELD RECORDS

Sample Identification

All samples sent to PAL for analysis conform to the labeling requirements under section 3.2.1 of the EISOPQAM.

8.3.1 Chain of Custody Procedures

Samples were logged as they were collected from the geoprobe liners. Date, time and sample litholgy were recorded on each log. Samples were then transferred to 4 oz amber glass jars and the jars transferred to a small sample cooler, which was taken to the mobile lab by field personnel in charge of sample handling. Sample identification (ID), date and time sampling occurred were recorded in the field logbook before transferring the samples to the mobile lab. Upon arrival at the mobile lab, the samples were transferred to the ECCS sample custodian who logged each sample on ECCS chain of custody forms. Each sample was assigned a unique ECCS internal ID number for tracking purposes. After analysis, the samples were transferred to either a sample refrigerator in the mobile lab or stored in coolers with ice until they were either shipped to PAL for confirmation analysis or readied for disposal. For samples sent to PAL, a new chain of custody form was completed by field personnel in charge of sample handling.

8.3.2 Field Records

Field records were kept in accordance with procedures and guidelines specified in section 3.5 of EISOPQAM.

8.4 Analytical Procedures

For analysis of samples in the field, ECCS used EPA Method 8082m, modified for quantitation of chlorinated benzenes and the mini extraction procedure.

PAL used EPA Method 8082 for quantitation of PCBs. For chlorinated benzenes, it used EPA Method 8270. While Method 8270 does not cover all the chlorinated benzenes, it provides confirmation of the ones it does detect and has the added benefit of supplying an analysis of a broad range of other semivolatile organic compounds.

For the analysis of cyanide EPA Method 9012A was employed and for silver EPA Method 6010B.

Selected samples were analyzed by EPA Method 8260, primarily to confirm that volatile organic compounds were not present in the samples or part of the site contaminants.

8.5 Laboratory Quality Assurance/Quality Control (QA/QC)

QA/QC procedures for both labs were found to be virtually identical. Summaries of each laboratory procedures follow.

ECCS:

- Continuous calibration standards analyzed every ten samples or less and at the end of a run.
- Blank samples and laboratory control samples (LCS) analyzed every twenty samples or less with a minimum of one per day.
- Matrix Spike/Matrix Spike Duplicate (MS/MSD) samples analyzed every twenty samples or less with a minimum of one per day.

PAL:

- Continuous calibration standards analyzed at least once every 12 hour shift plus a minimum of every 20 samples gas chromatography/mass spectroscopy (GC/MS) criteria follows method specific tuning requirements per EPA Method 8270.
- Blank and LCS samples analyzed every 20 samples or less with a minimum of one per day.
- MS/MSD samples analyzed every 20 samples or less with a minimum of one per day.

8.6 Data Validation and Reporting

As discussed in section 8.2, the primary validation of the ECCS data was accomplished through comparison with the data from PAL.

Since Hexachlorobenzene and 1,2,4-Trichlorobenzene are the only chlorinated benzenes on the standard Method 8270 list, these two compounds and total PCBs were the parameters tracked for the data validation procedure.

Overall, the correlation to this point of the investigation and remediation activities has been excellent with the majority of sample splits showing Relative Percent Differences (RPDs) of less than 100. Considering the inherent variability of soil as a matrix, achieving 93% acceptable split data spanning several orders of magnitude of concentration serves to justify the use of the on-site data as definitive quality.

FILE COPY

19 pages t/l/cover

TO:
Gretchen Zmitrovich
MDEQ

From:
Tim Fitzpatrick
Ogden Environmental

Gretchen: Following are my field maps - I hope you can read them! Data will follow shortly.

Please call after you receive this fax.

Thanks,

Tim

OGDEN

Job Name: Crystal Springs -
Job Number:
Title: Sonny Reeves backyard 405 Jackson
Computed by: Checked by:
Date: 8/16/2000 Sheet: 1 Of: 11

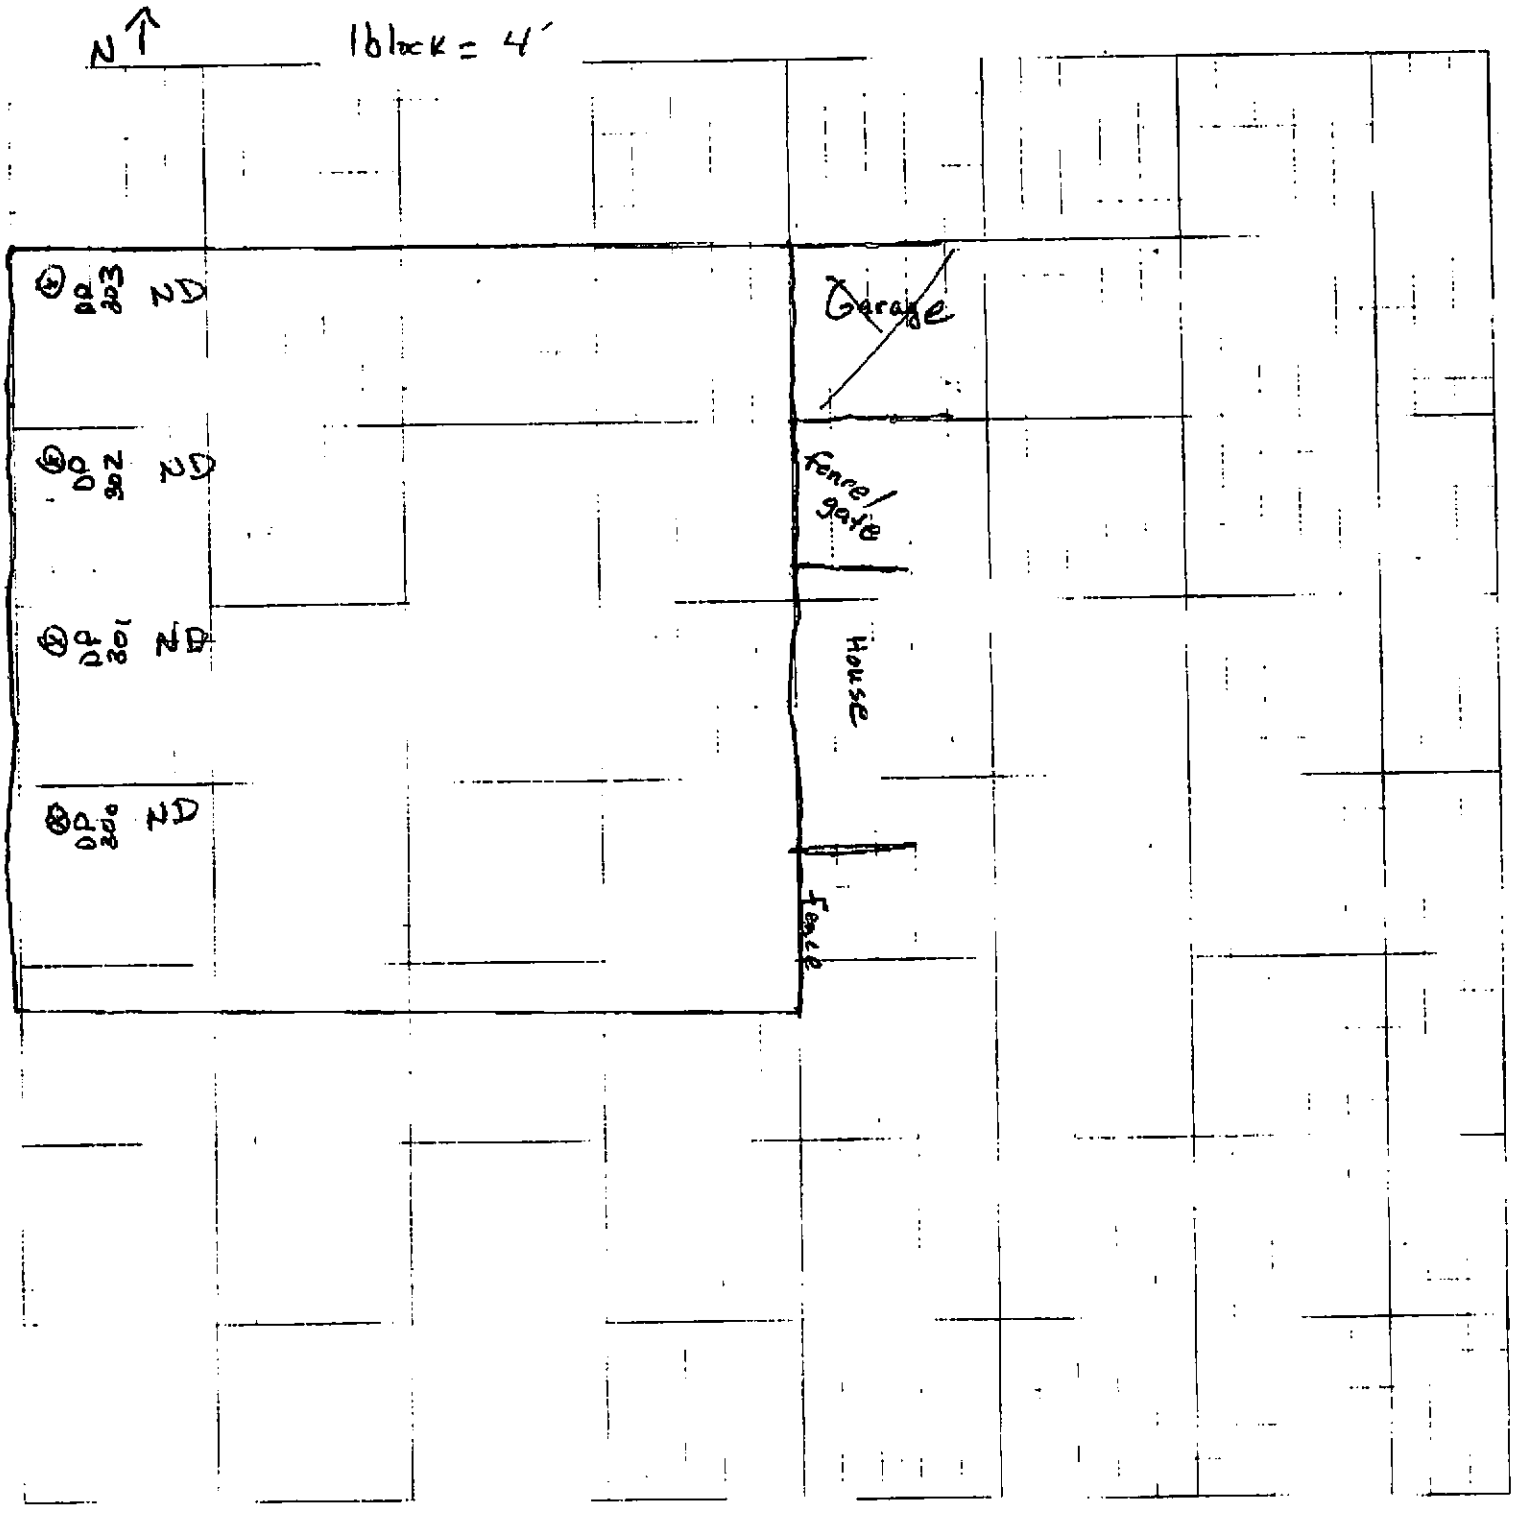

OGDEN

Job Name: Crystal Springs
Job Number:
Title: Stringer Funeral Home
Computed by: Checked by:
Date: 8-16-2000 Sheet: 2 of 11

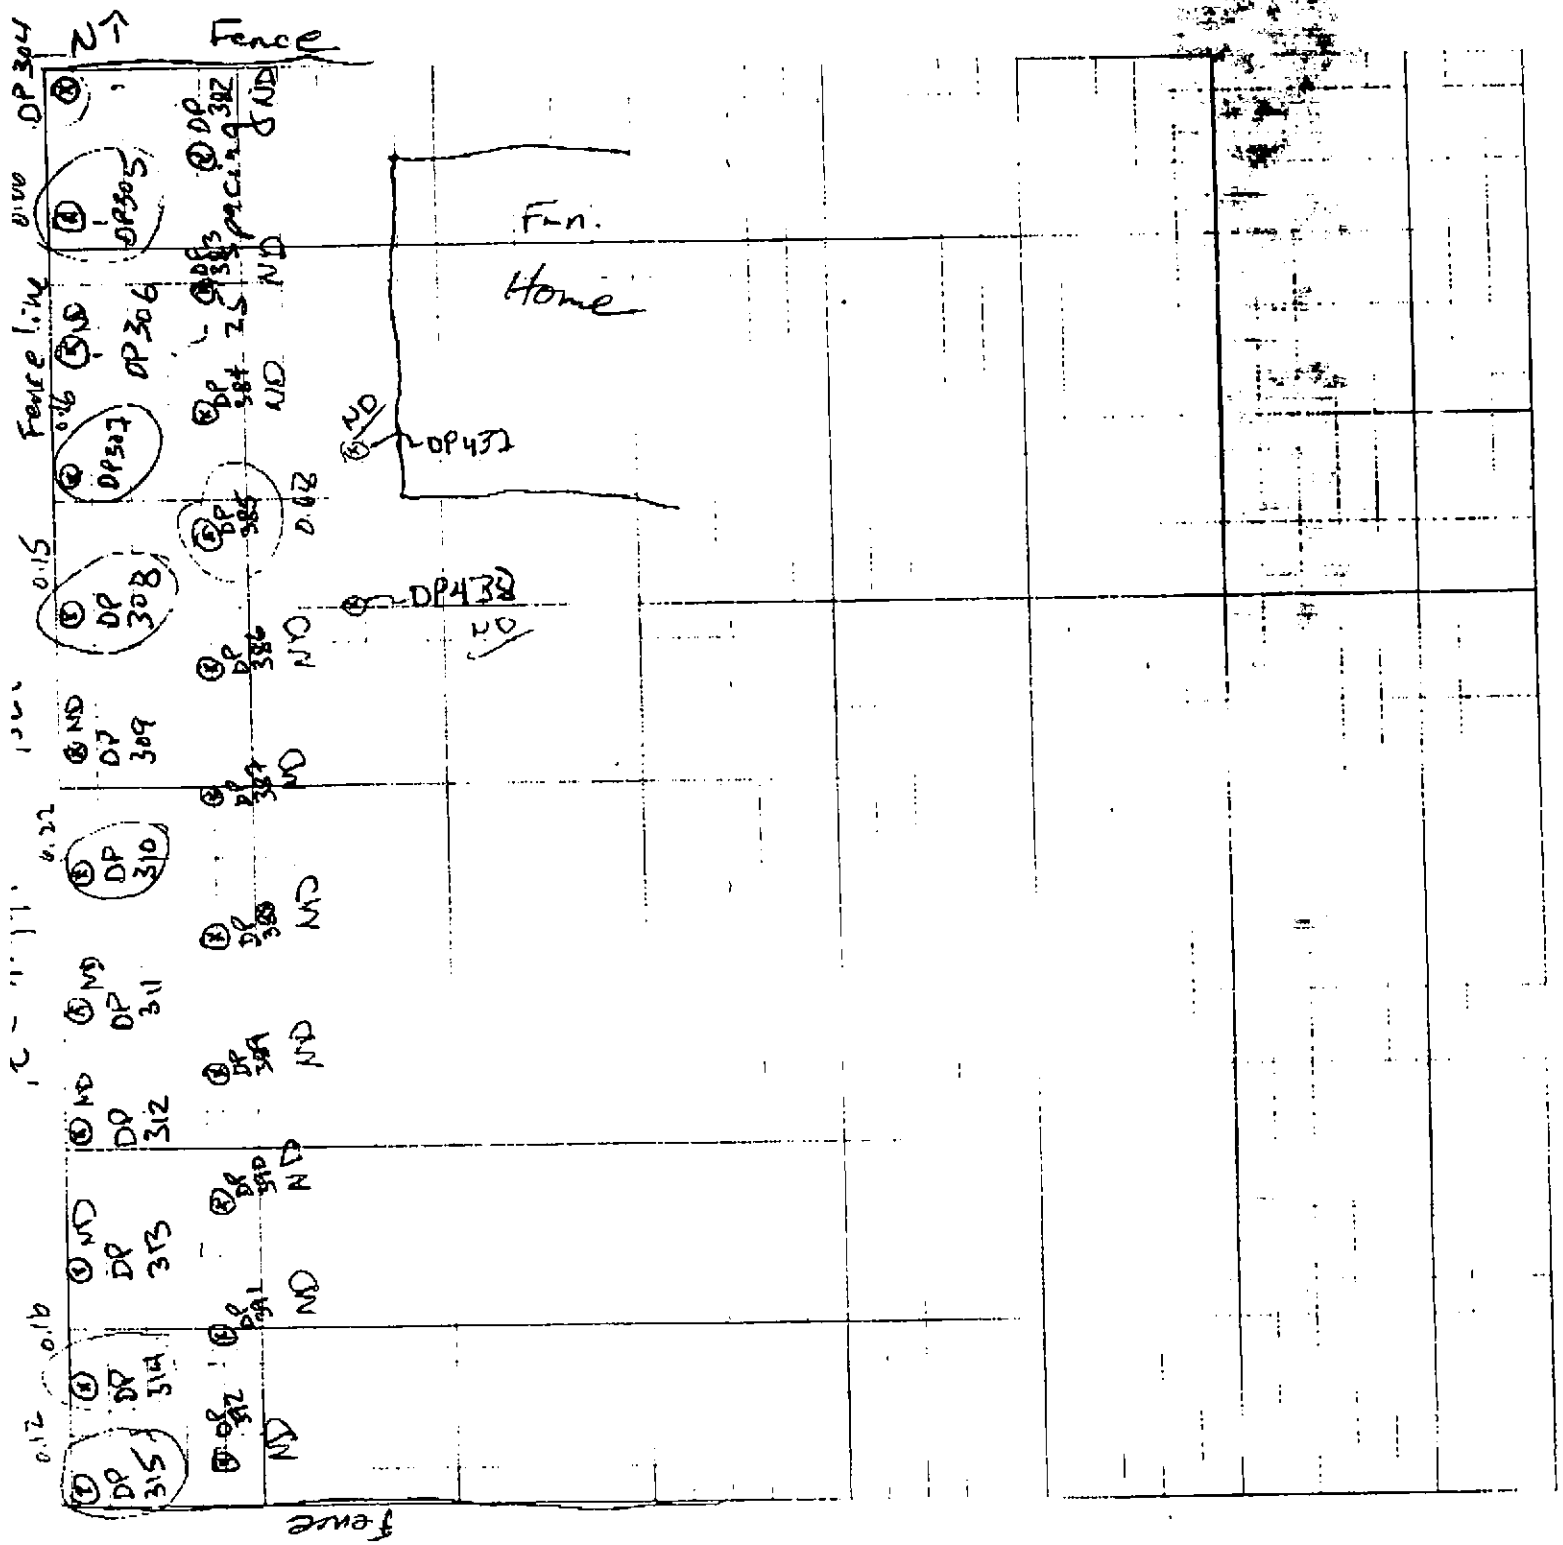

OGDEN

Job Name: Crystal Springs
Job Number:
Title: 401 N. Jackson Elnor Wright
Computed by: Checked by:
Date: 8-16-2000 Sheet: 3 Of: 11

1 block = 4'

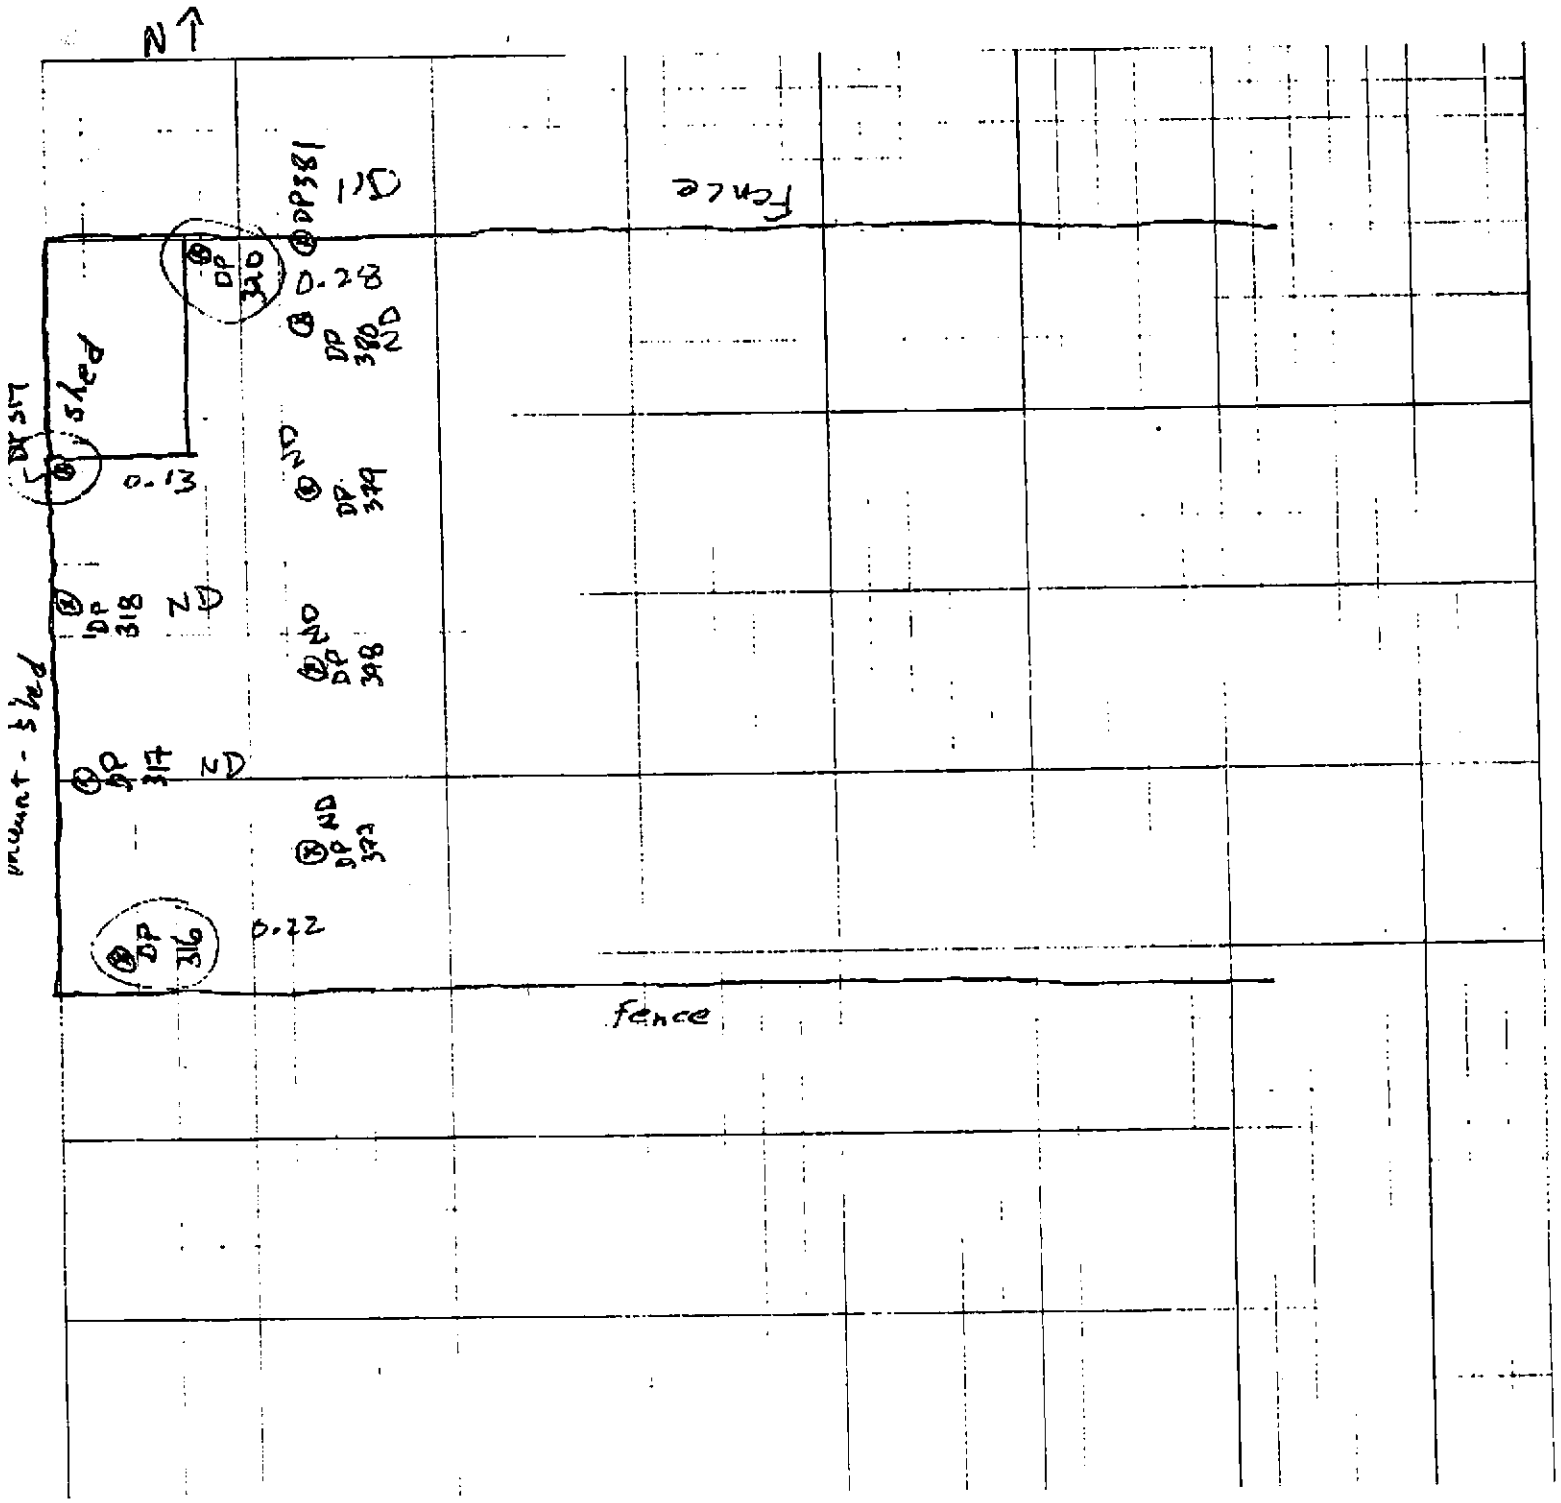

OGDEN

Job Name: Crystal Springs
Job Number:
Title: 407 N. Jackson Lower Lang
Computed by: Checked by:
Date: 8-16-00 Sheet: 4? OF 11

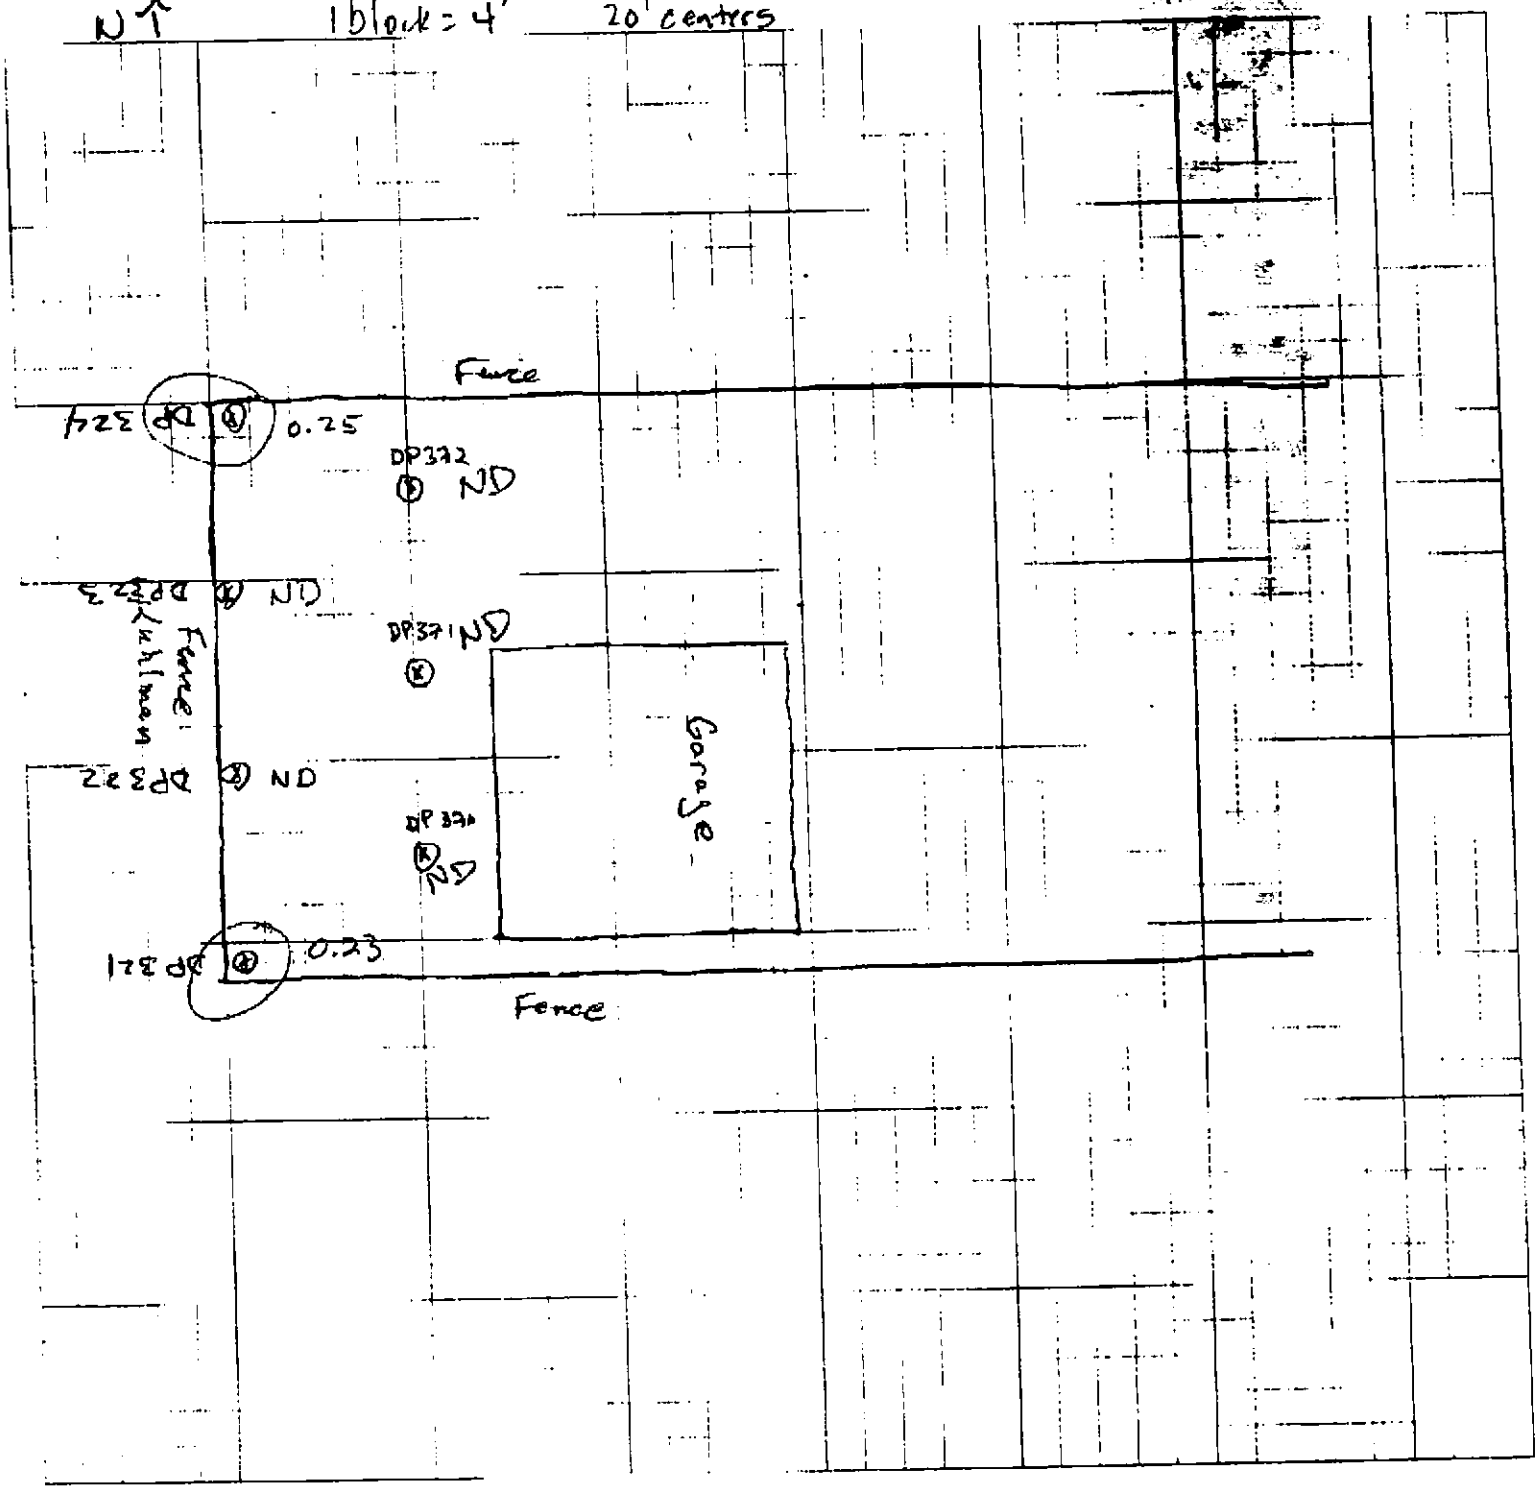

OGDEN

Job Name: Crystal Springs
Job Number:
Title: Lee St. Medical
Computed by: Checked by:
Date: 8/17/00 Sheet: 5 Of: 11

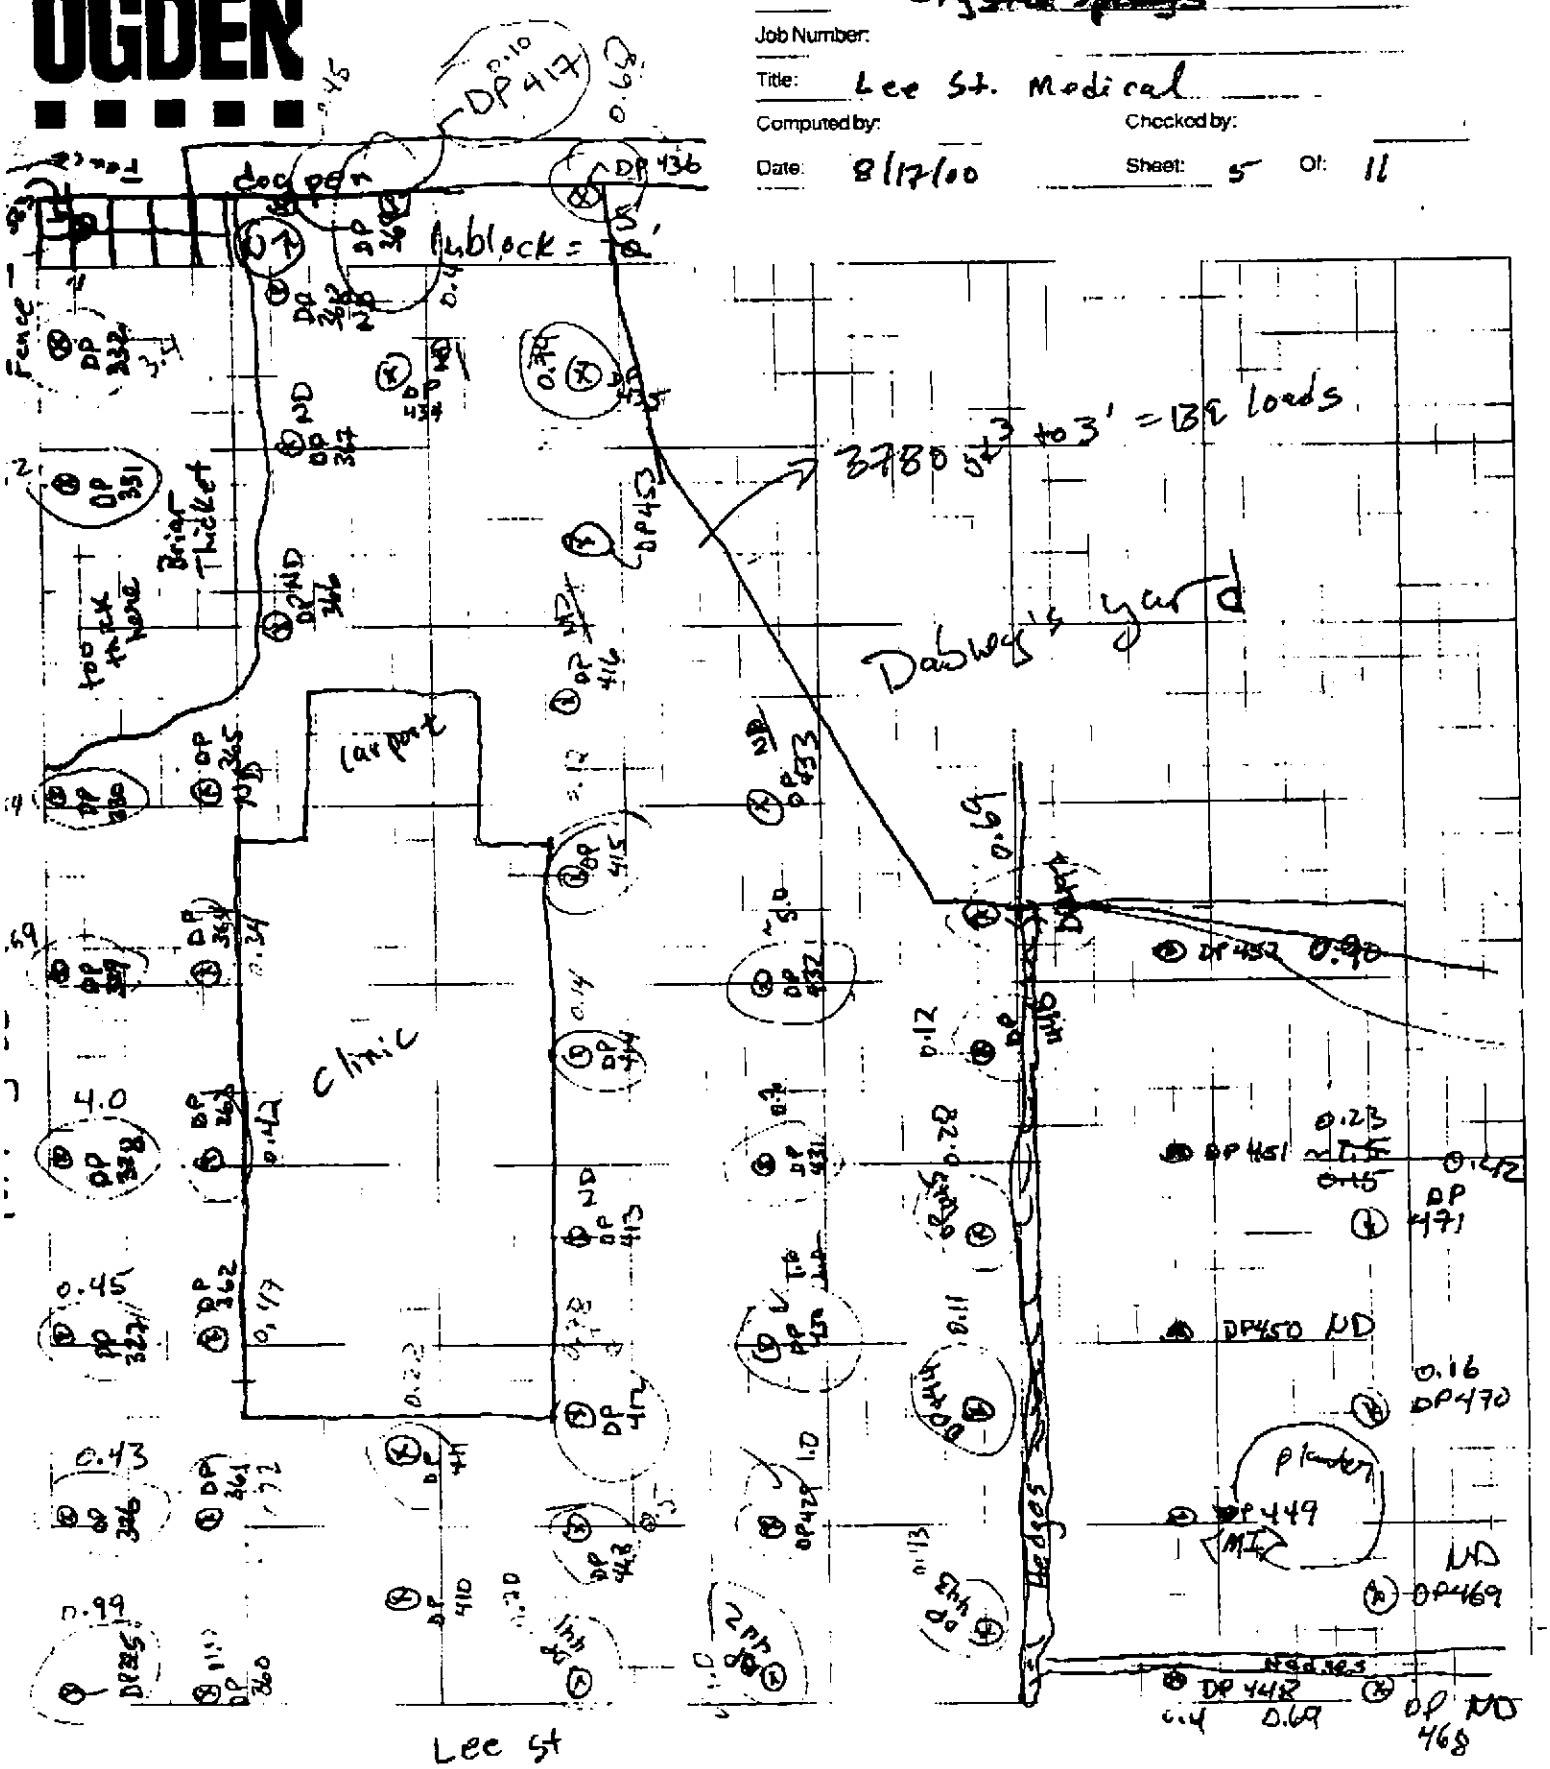

OGDEN

Job Name: Crystal Springs
Job Number:
Title: 303 N. Jackson (Stringer)
Computed by: Checked by:
Date: 8-17-00 Sheet: 16 of 11

NT↑ 1 block = 5'

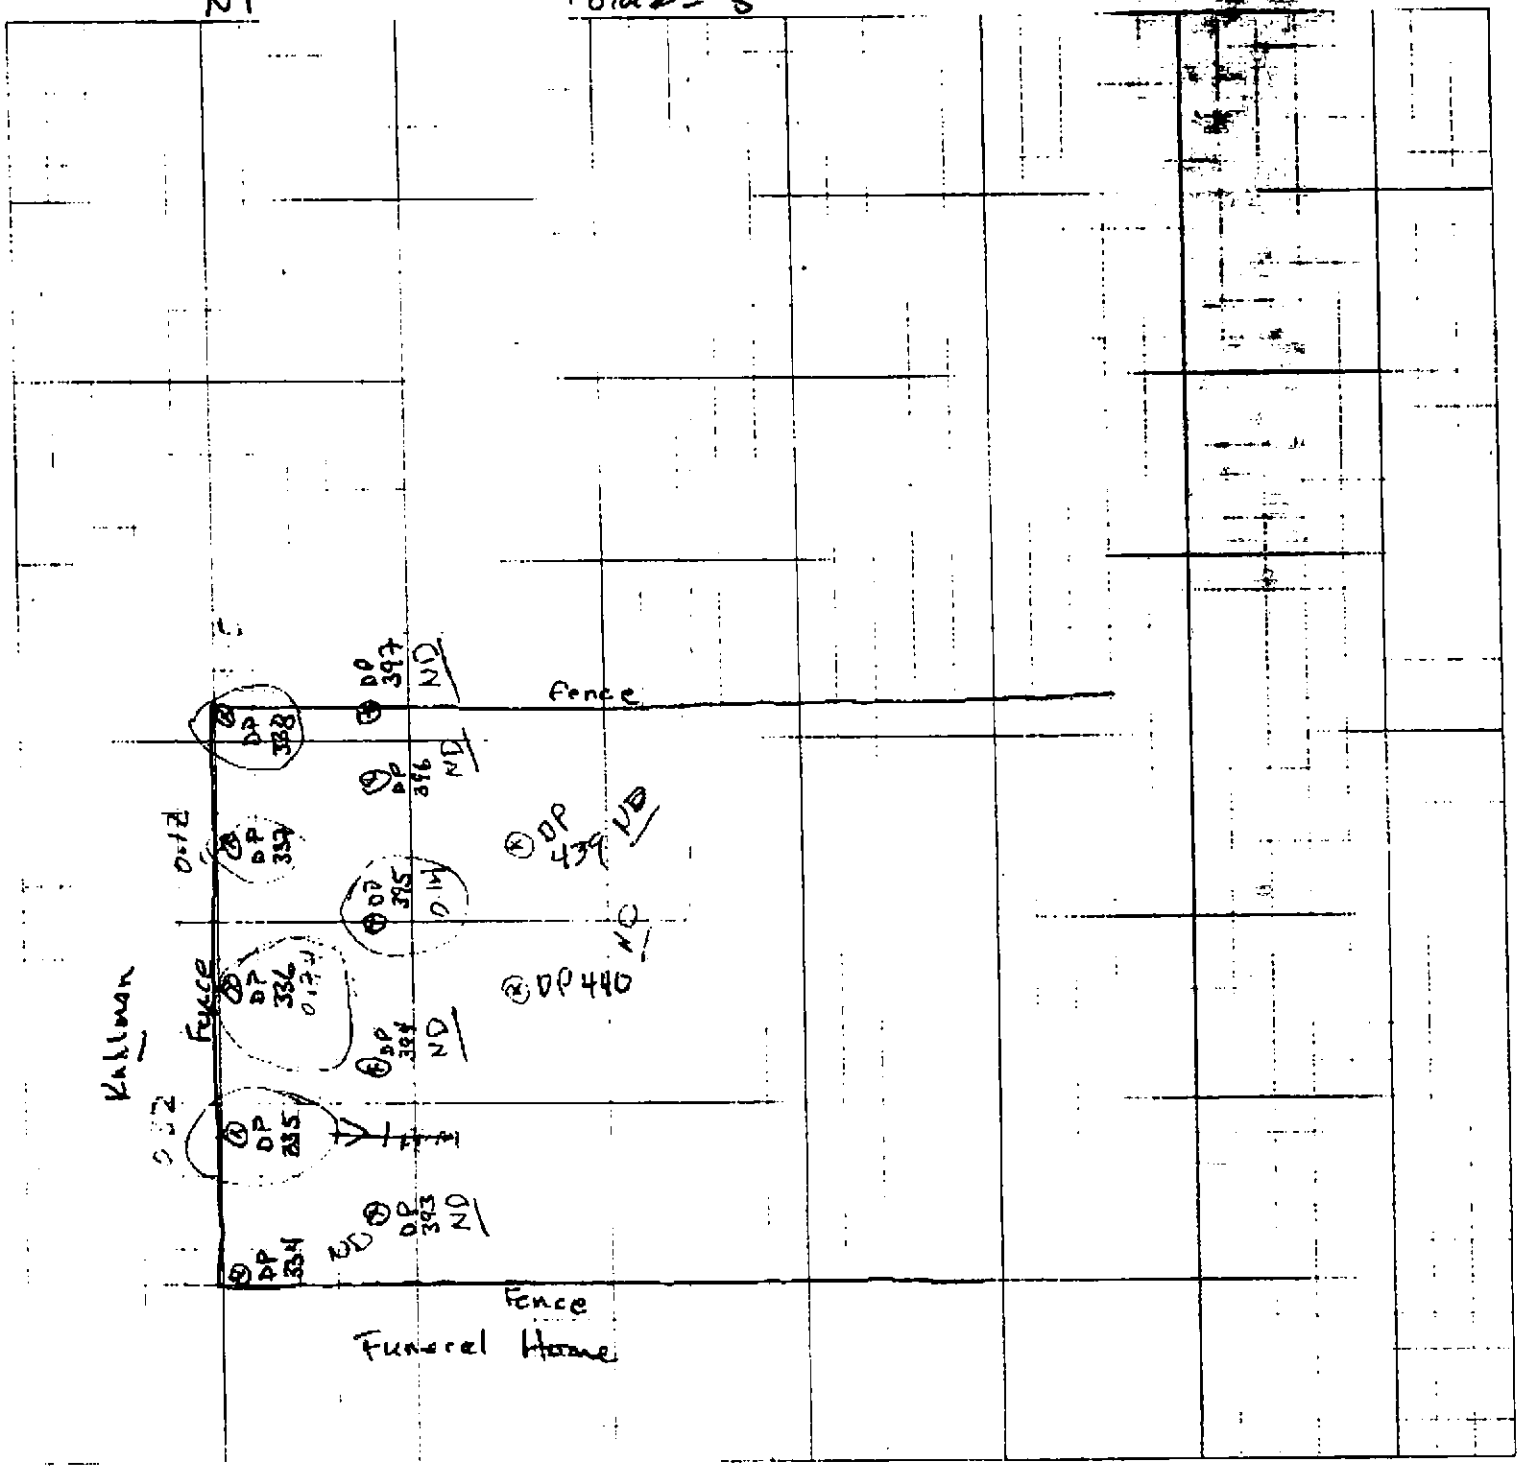

OGDEN

Job Name: Crystal Springs
Job Number:
Title: 219 N. Jackson - Perry Smith
Computed by: TJF Checked by:
Date 8-17-00 Sheet: 7 Of: 11

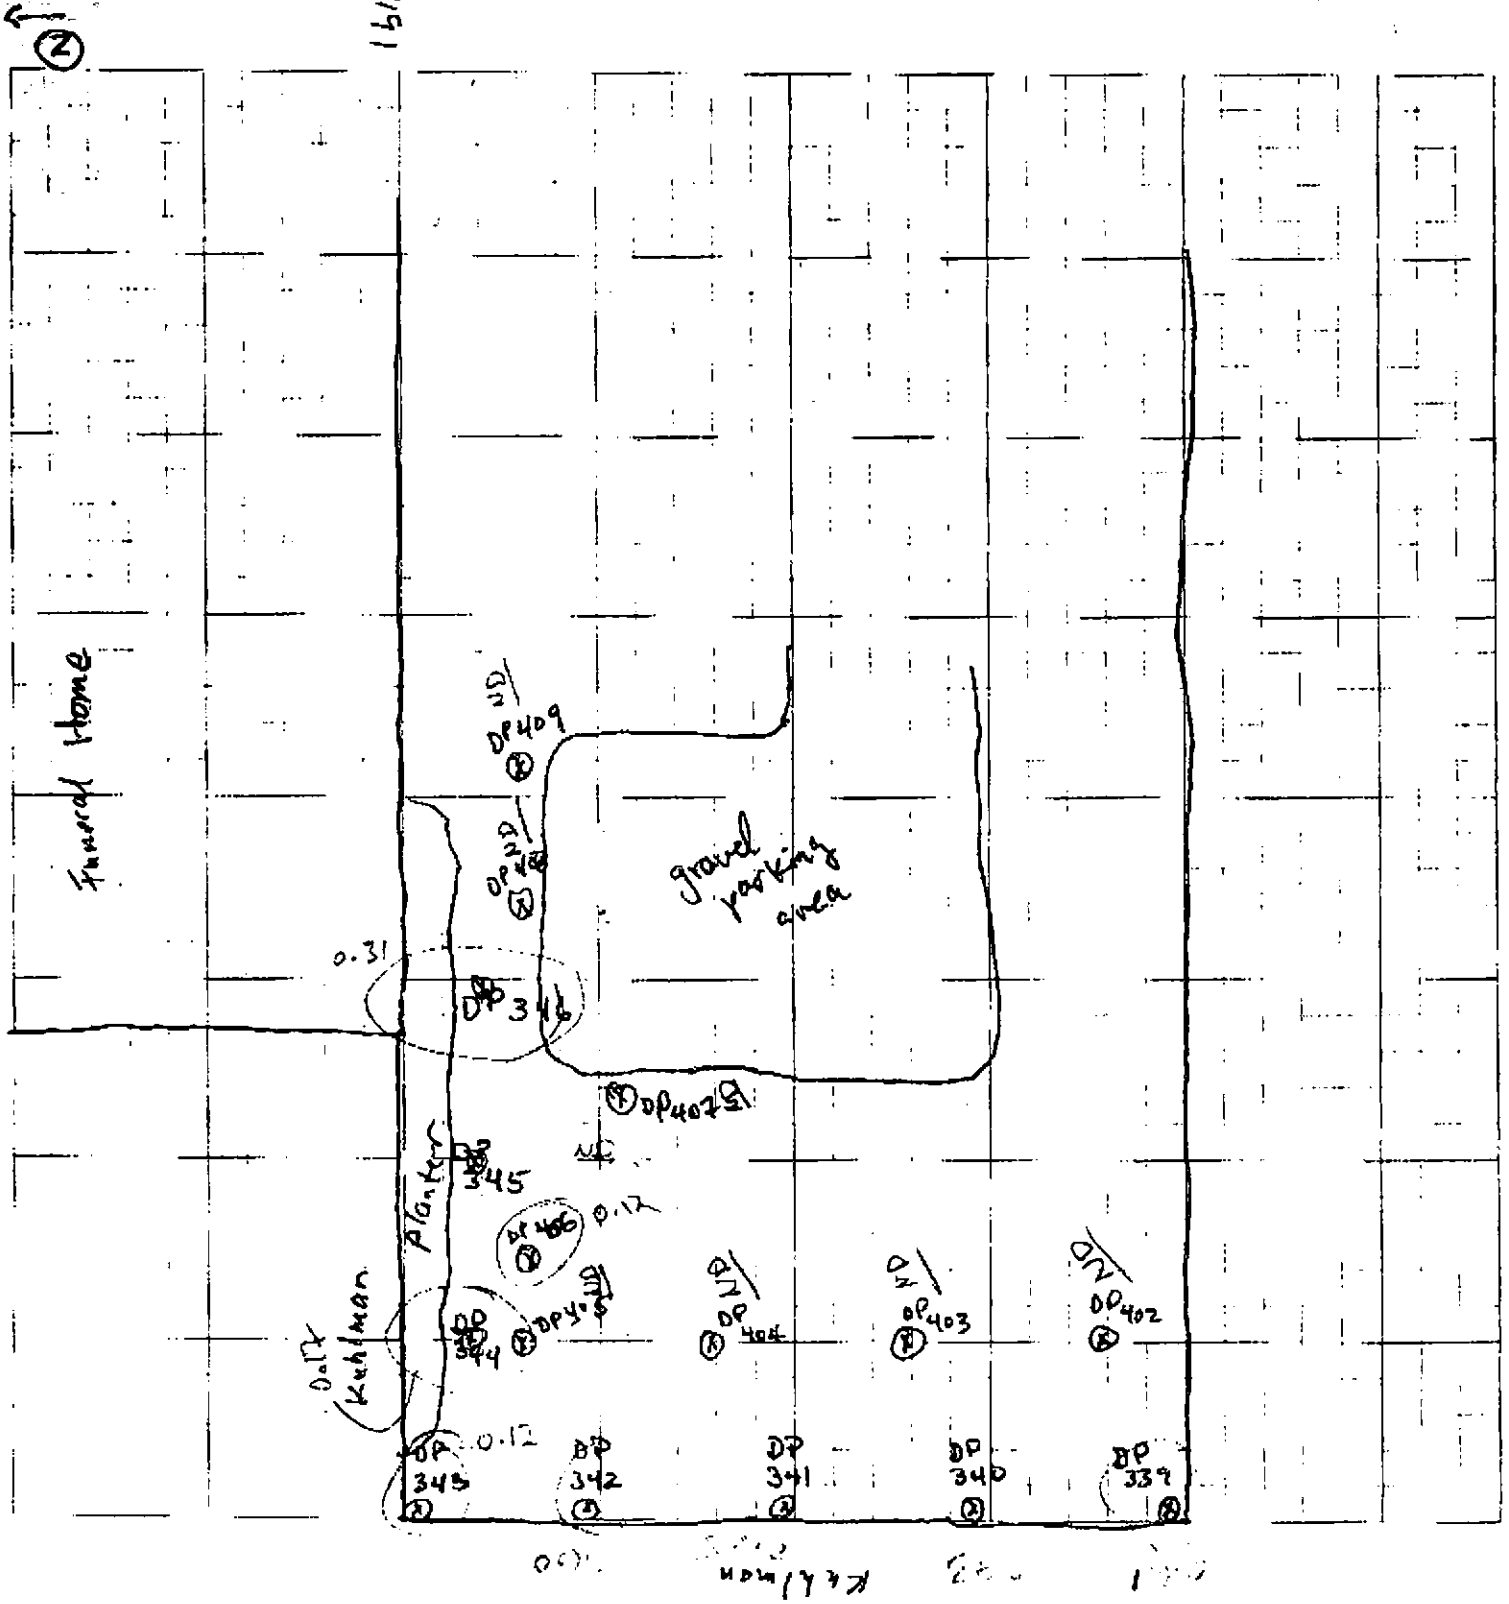

OGDEN

Job Name: Crystal Springs
Job Number
Title: 409 N. Jackson (Ann Cooper)
Computed by: DF Checked by:
Date: 8-17-00 Sheet: 2 of 11

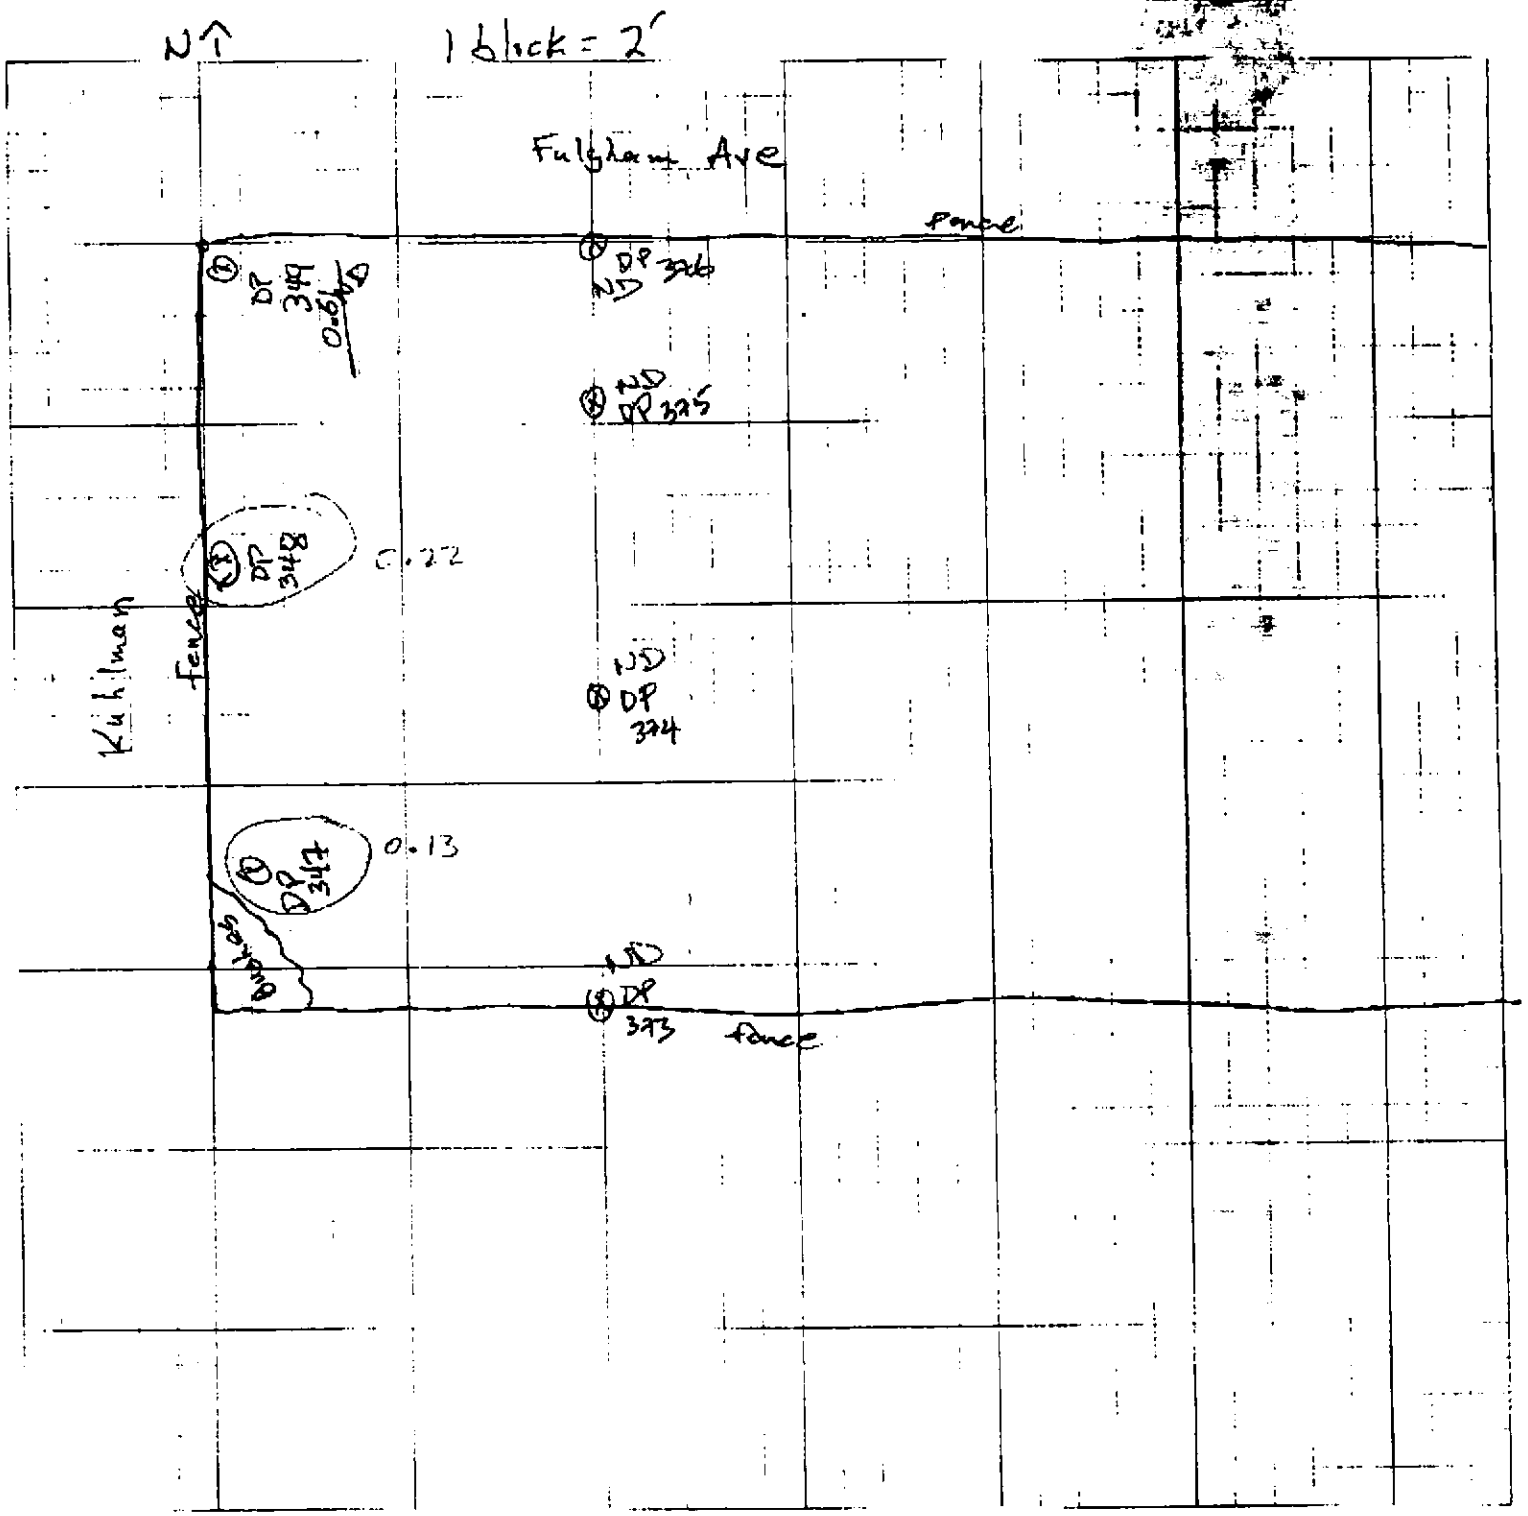

OGDEN

Job Name: Crystal Springs
Job Number:
Title: Dabney Home
Computed by: TJF Checked by:
Date: 8-17-00 Sheet: 9 Of: 11

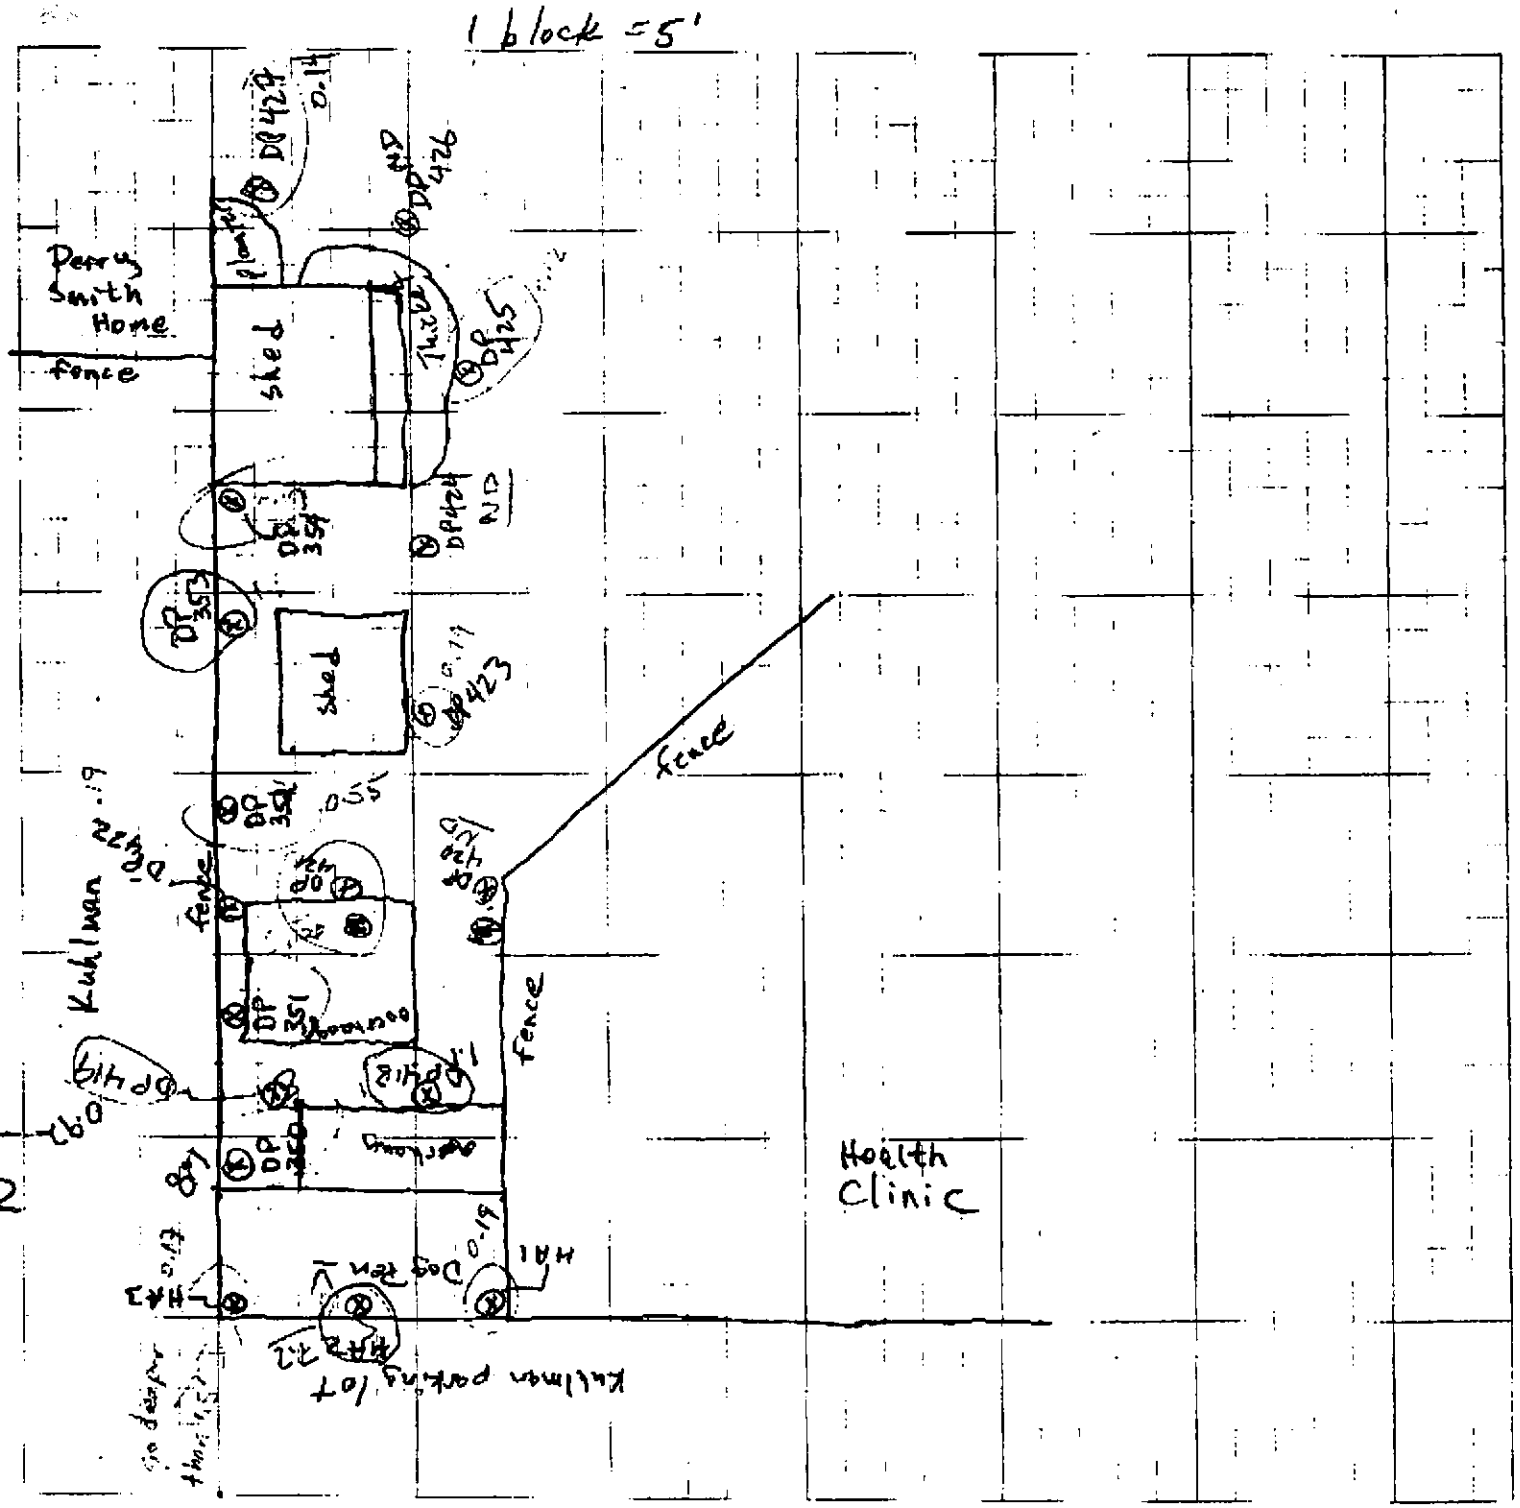

OGDEN

Job Name: Crystal Springs
Job Number:
Title: Wright House
Computed by: Checked by:
Date: 8-18-00 Sheet: 10 of 11

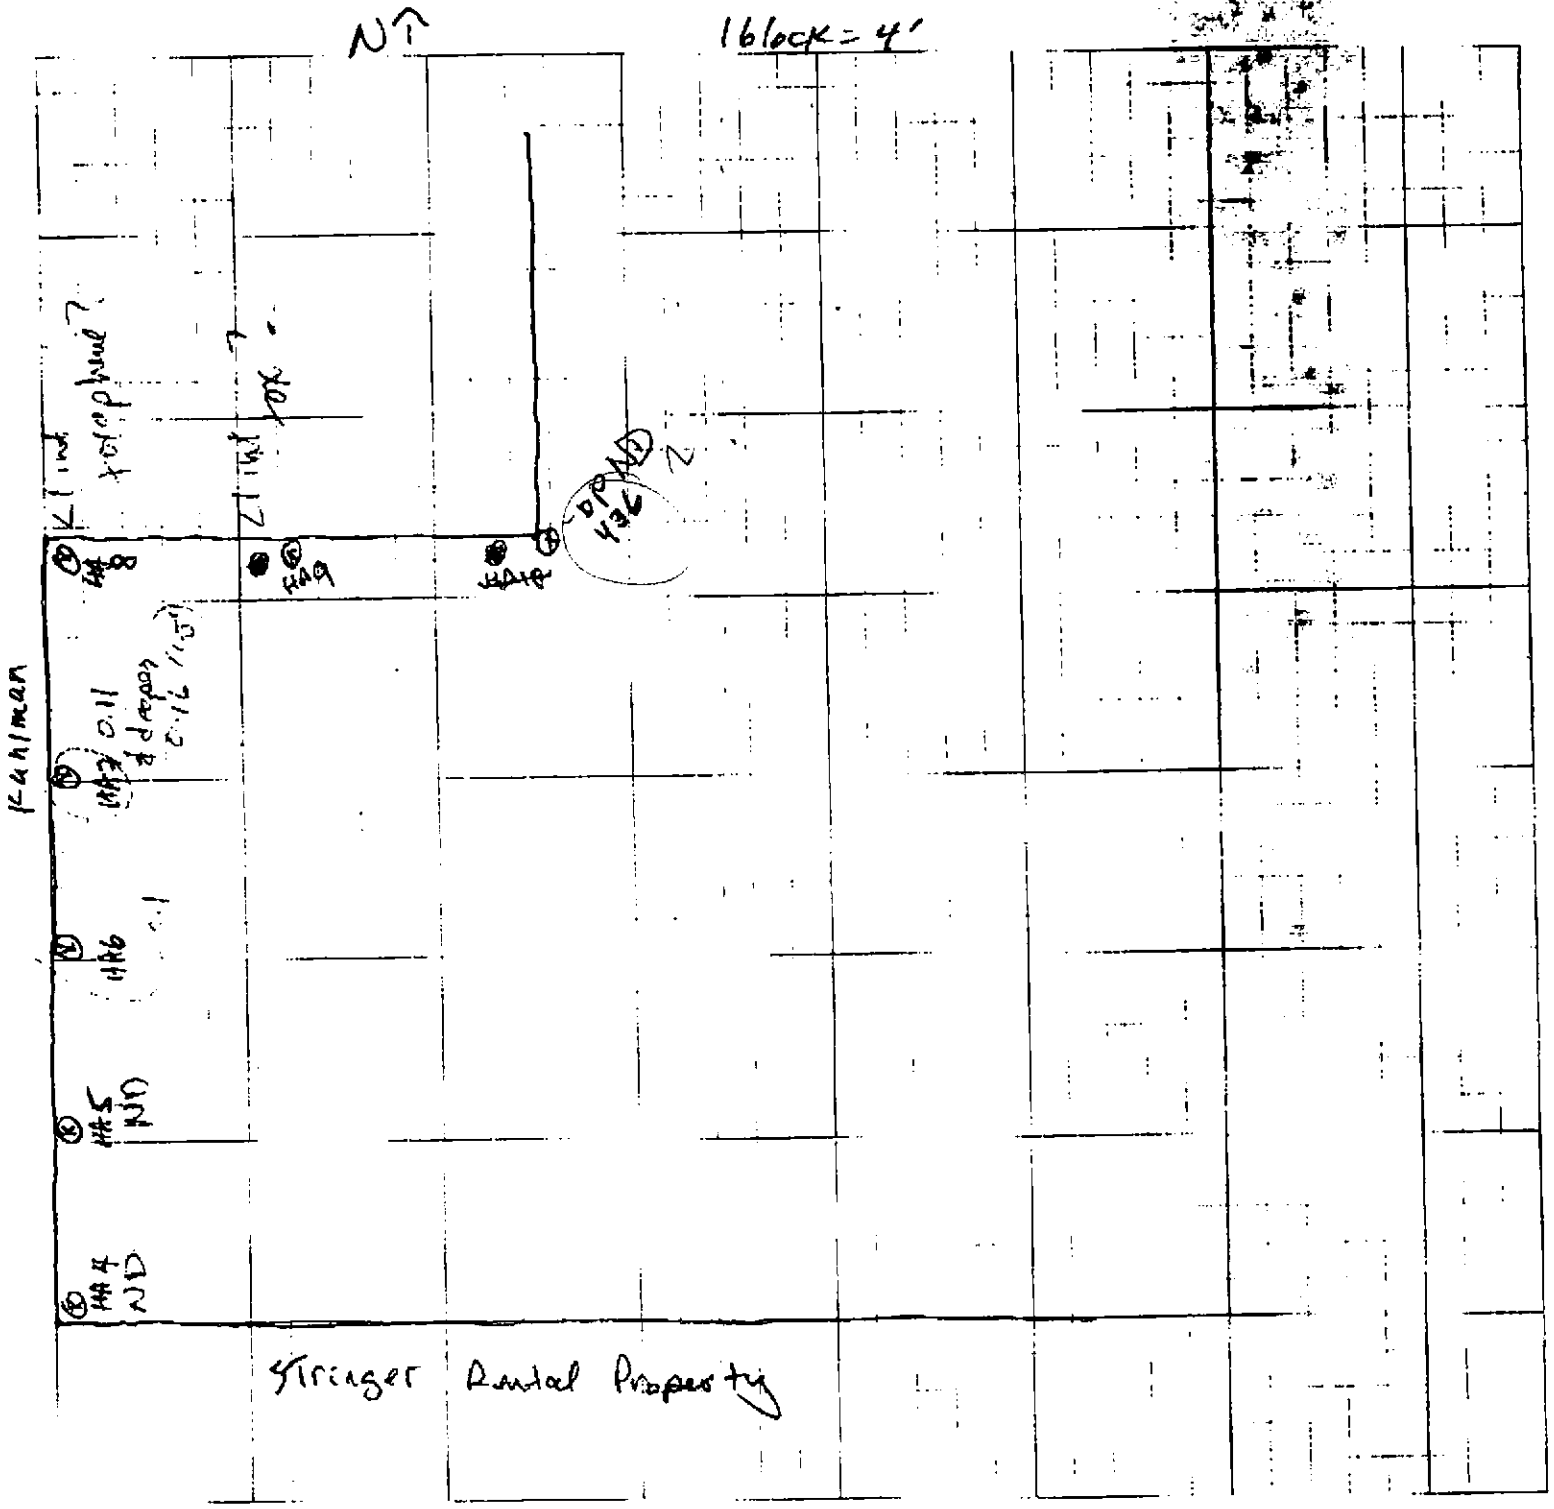

OGDEN

Job Name: Crystal Springs
Job Number:
Title: Harold & Suzanne Wasden
Computed by: TJF Checked by:
Date: 8-18-00 Sheet: 11 Of: 12

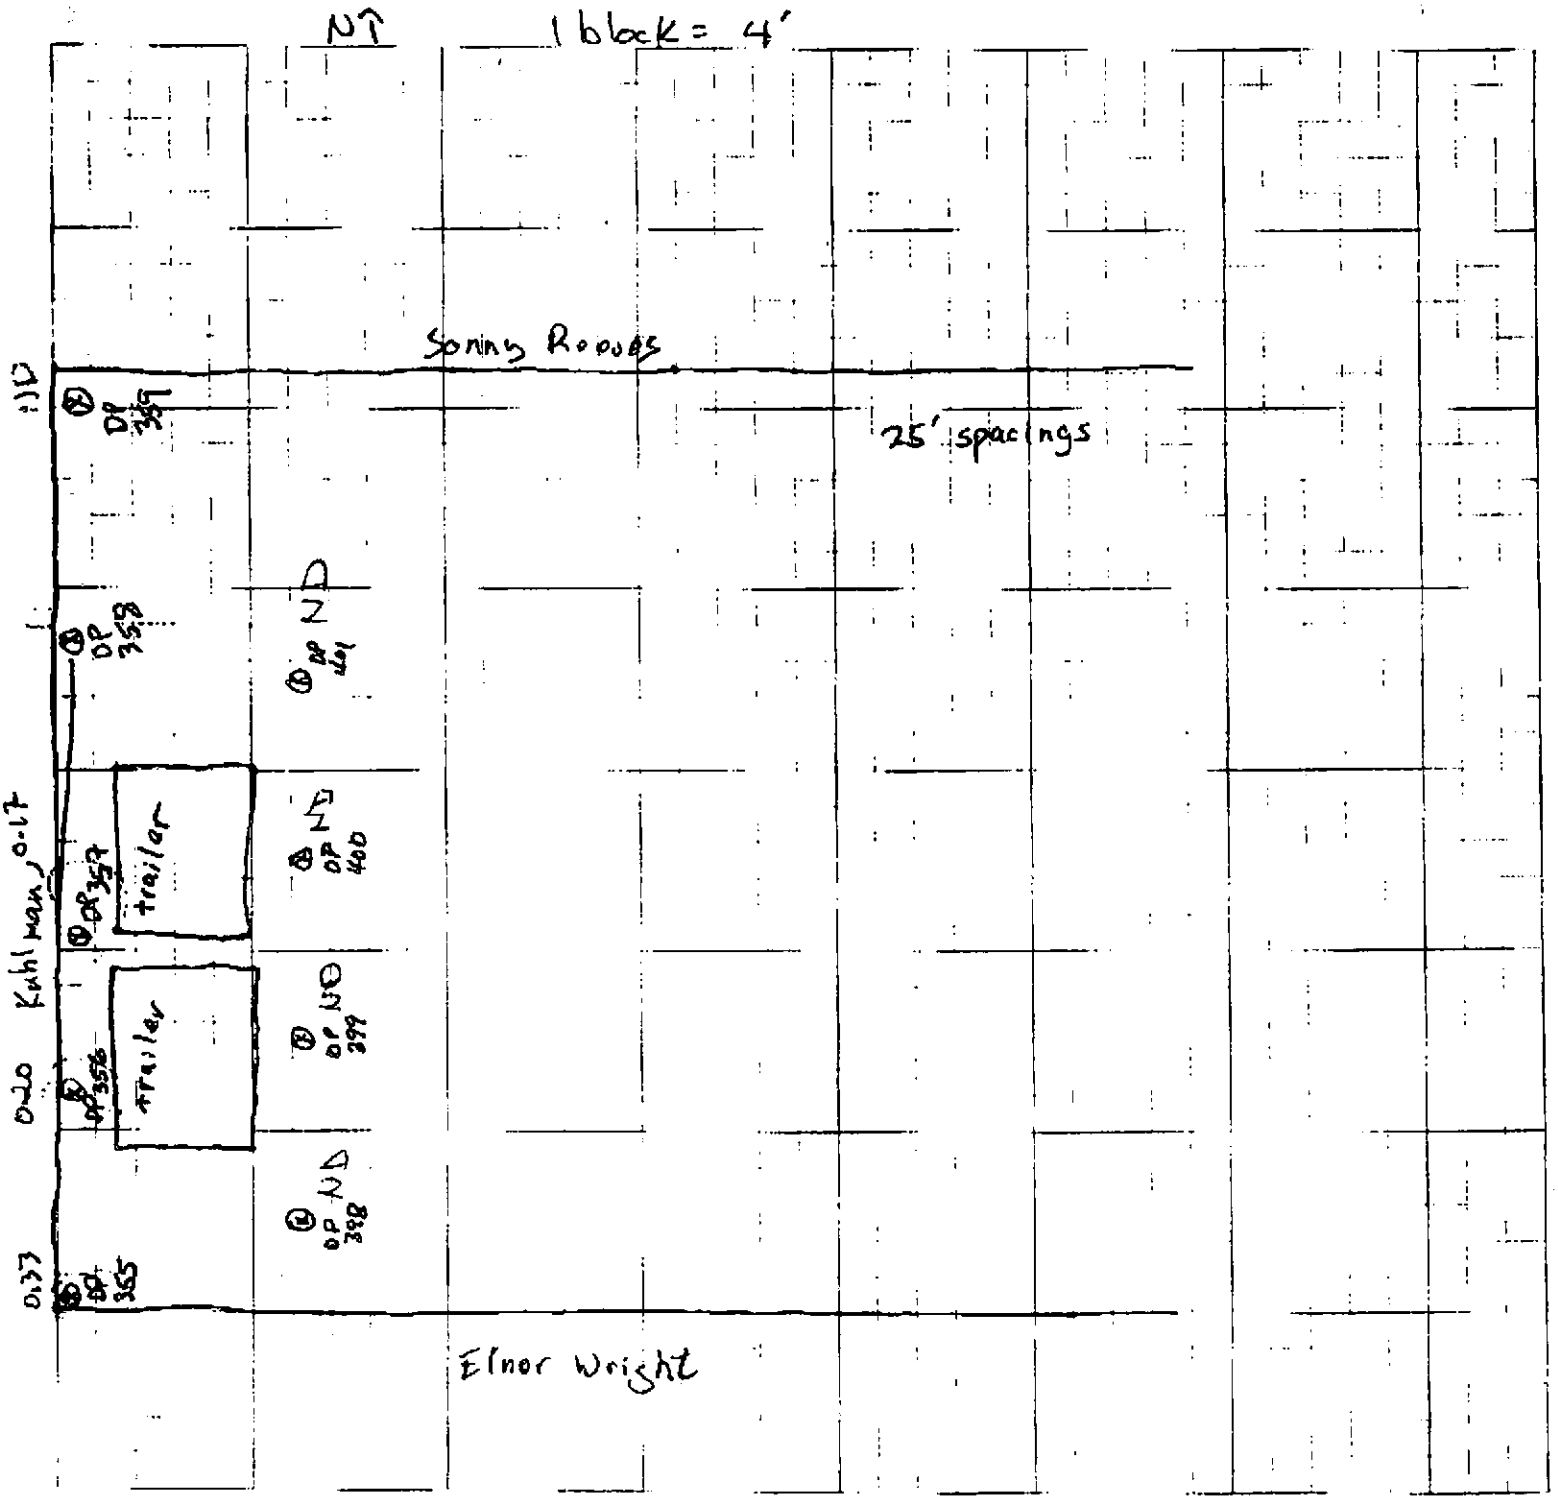

OGDEN

Job Name:
Job Number:
Title: Dabney yard - South side
Computed by:
Checked by:
Date: 8/23/00
Sheet: 12 of 21

1 block = 5'

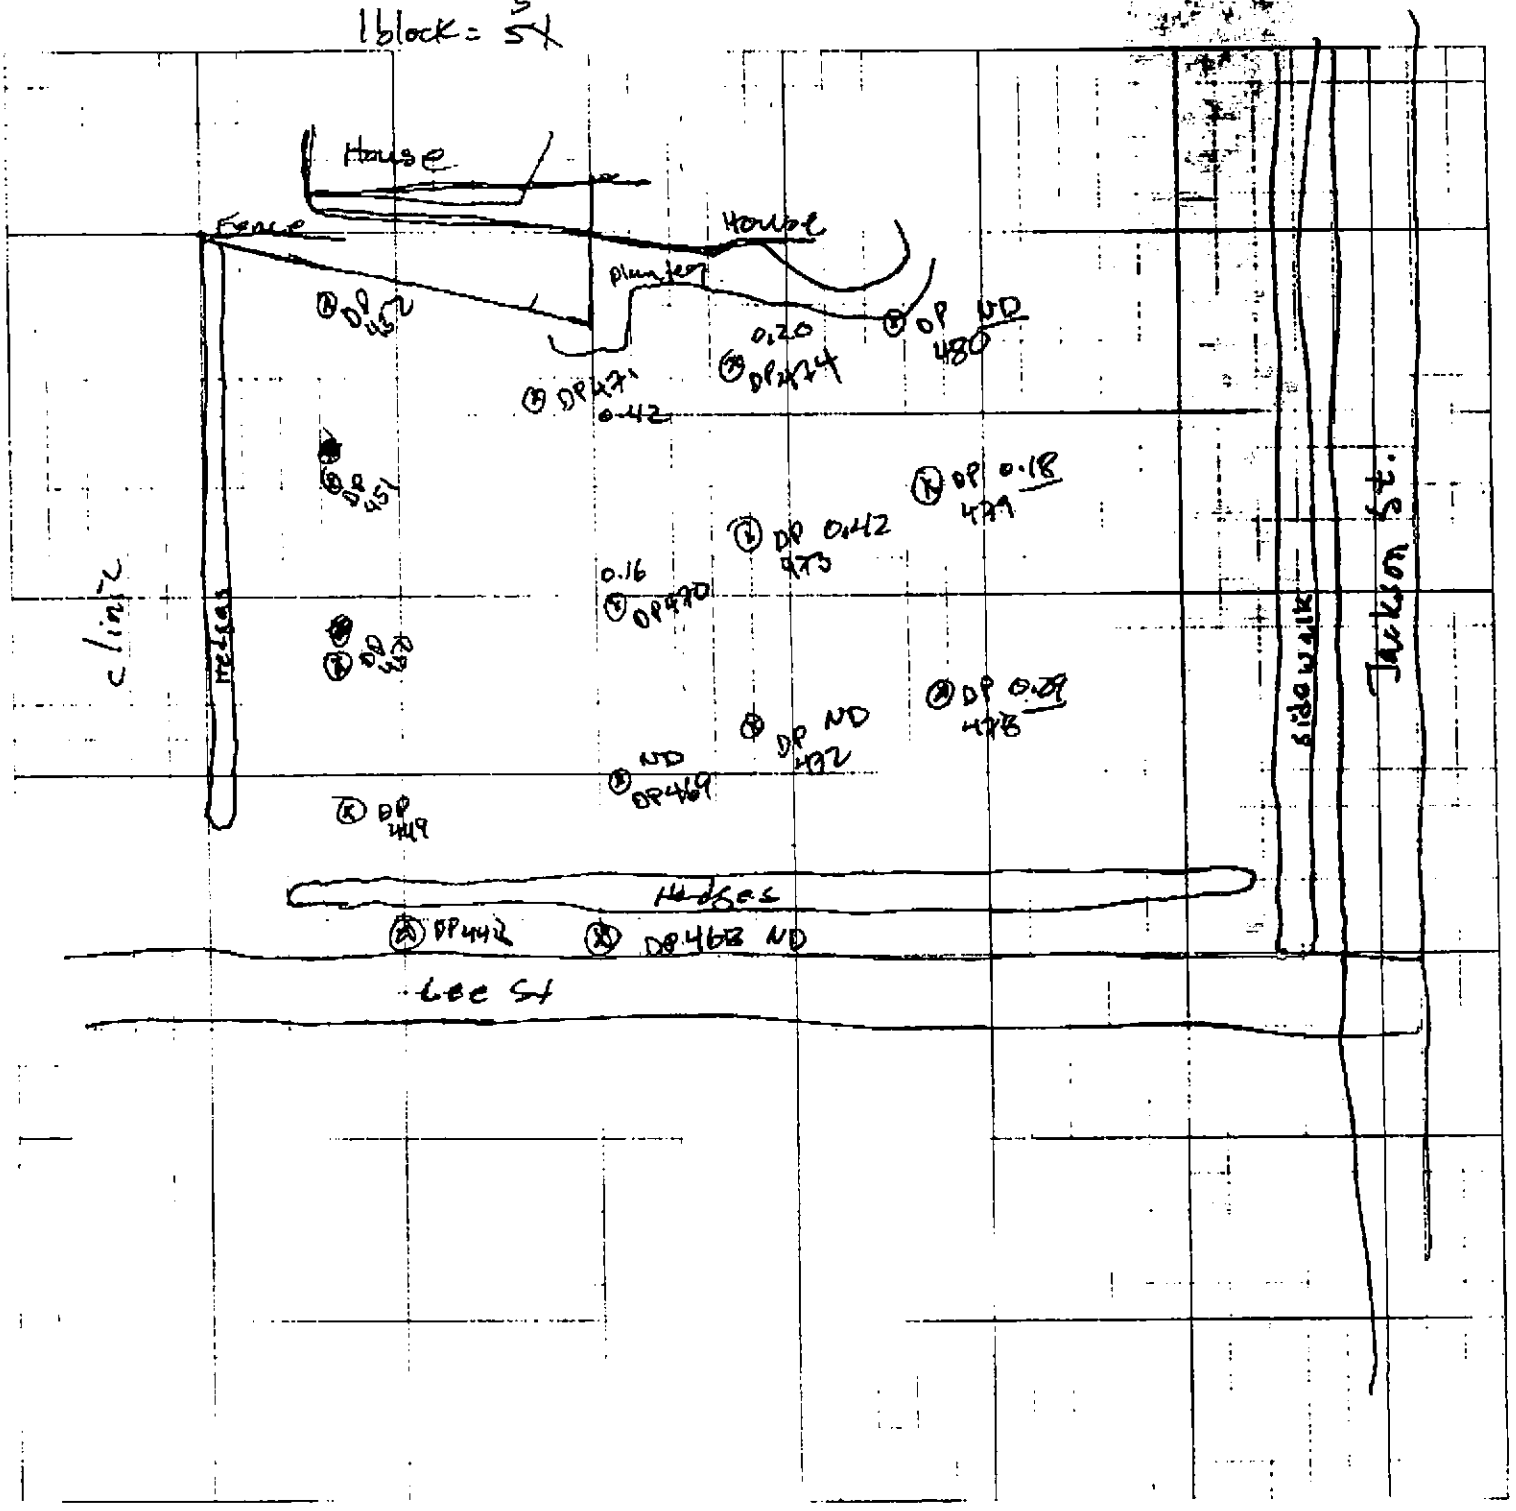

OGDEN

Job Name:

Job Number:

Title: Fulgham Ave

Computed by: Checked by:

Date: Sheet: 13 Of:

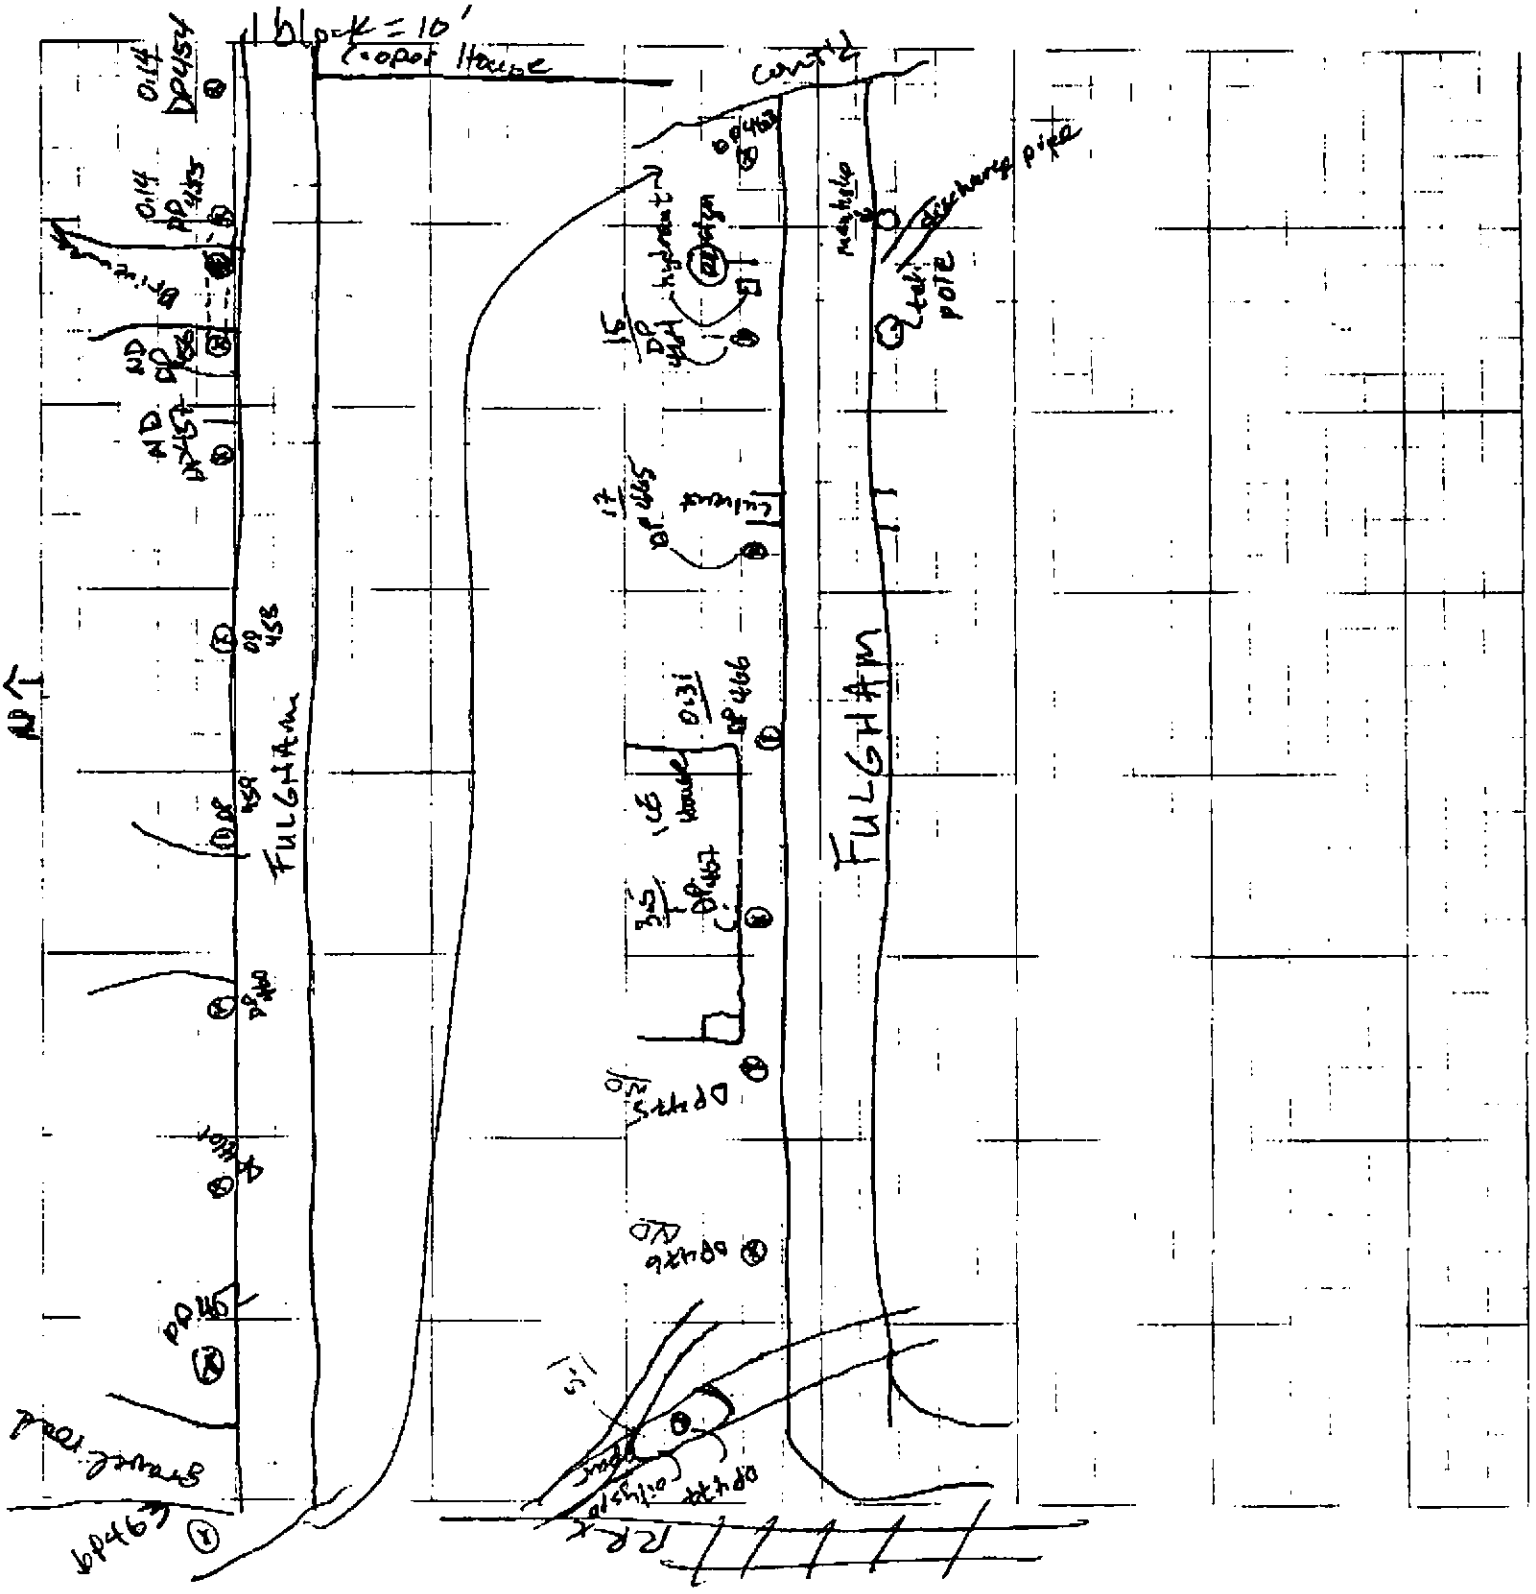

OGDEN

Job Name:

Job Number:

Title: Edwards property split

Computed by: TJF Checked by:

Date: 8/24/00 Sheet: 14 of

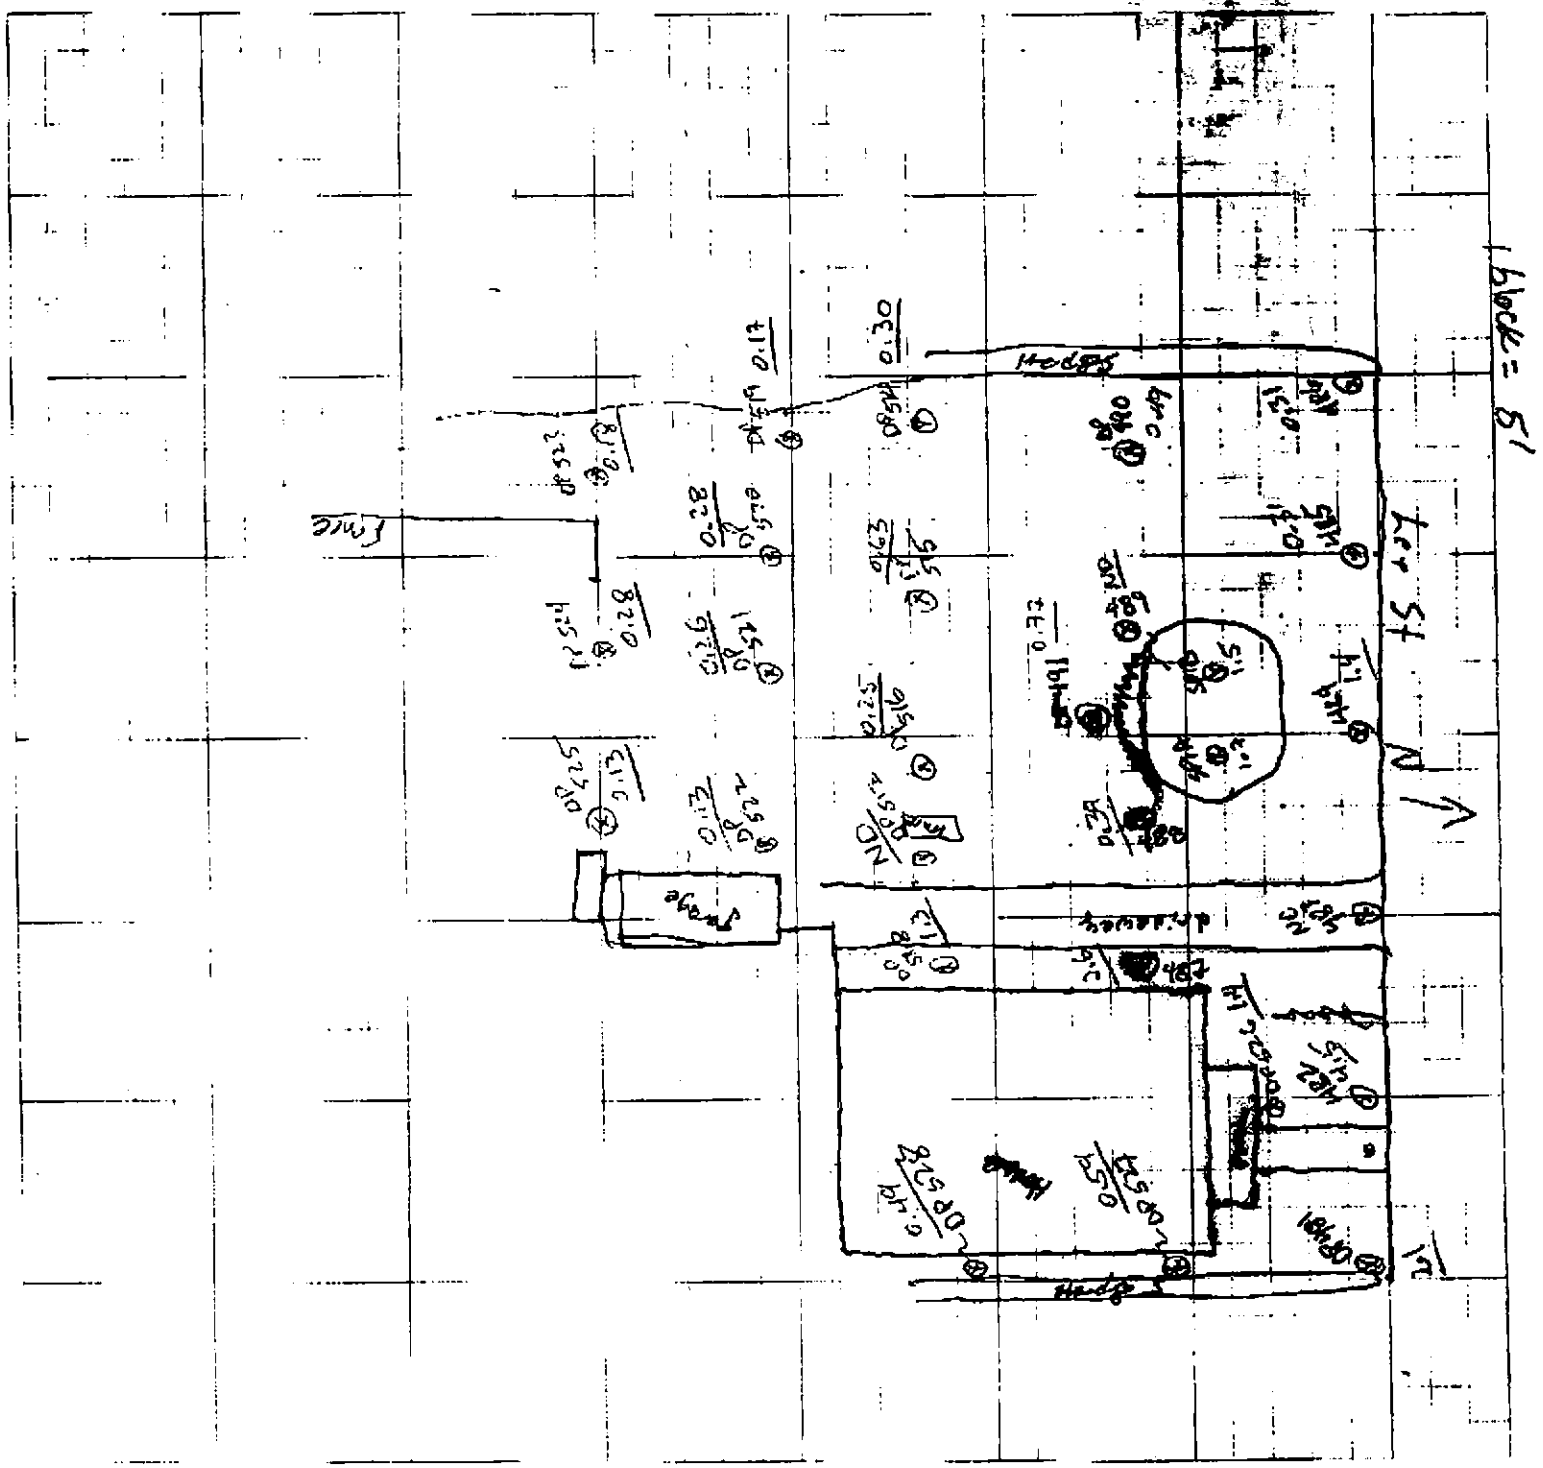

OGDEN

Job Name:
Job Number:
Title: 408/410 Lee St.
Computed by: TDF Checked by:
Date: 8/24/00 Sheet: 15 Of:

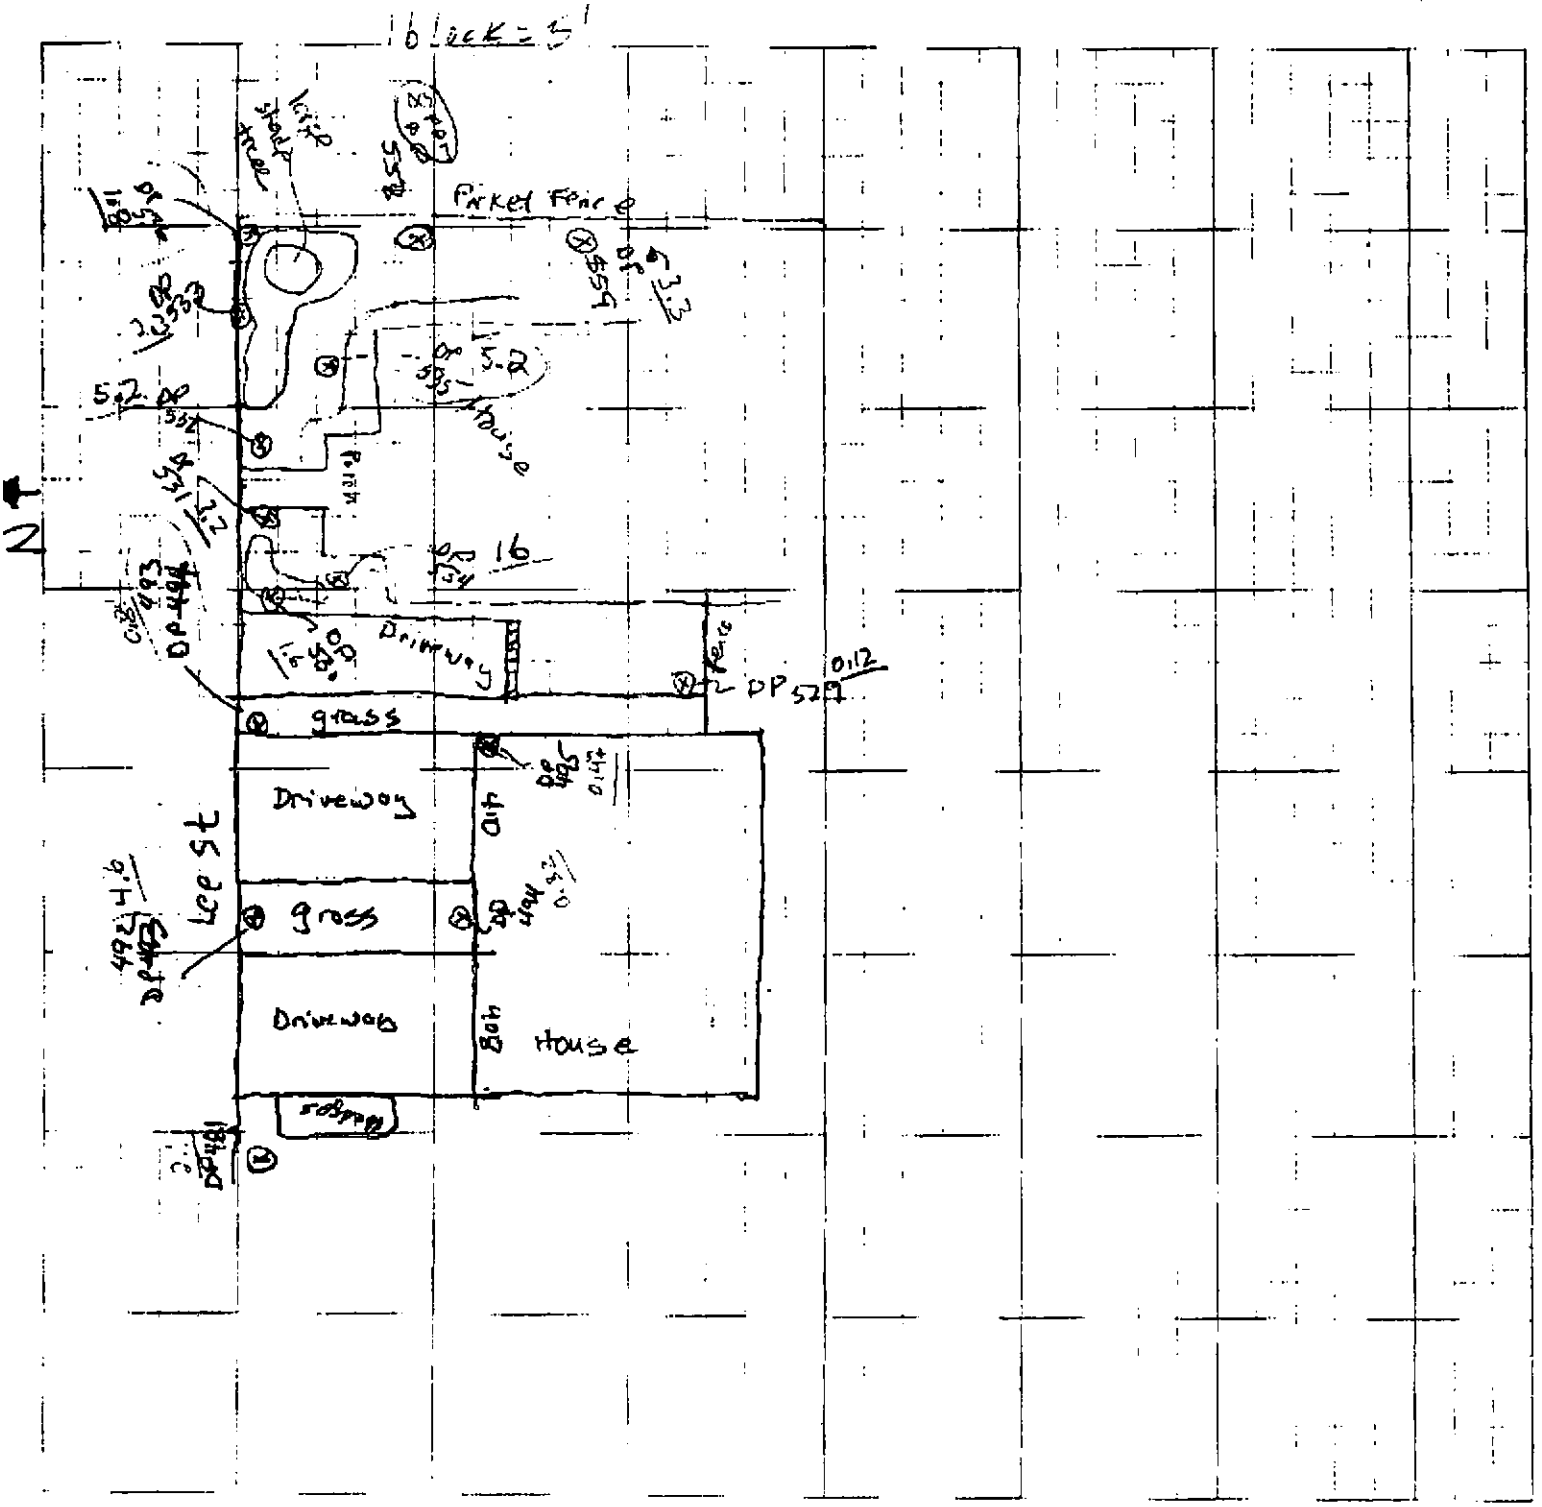

OGDEN

Job Name:

Job Number:

Title: Brent Property Leo St.

Computed by: TJF Checked by:

Date: 8/24/00 Sheet: 16 of

1 block = 2'

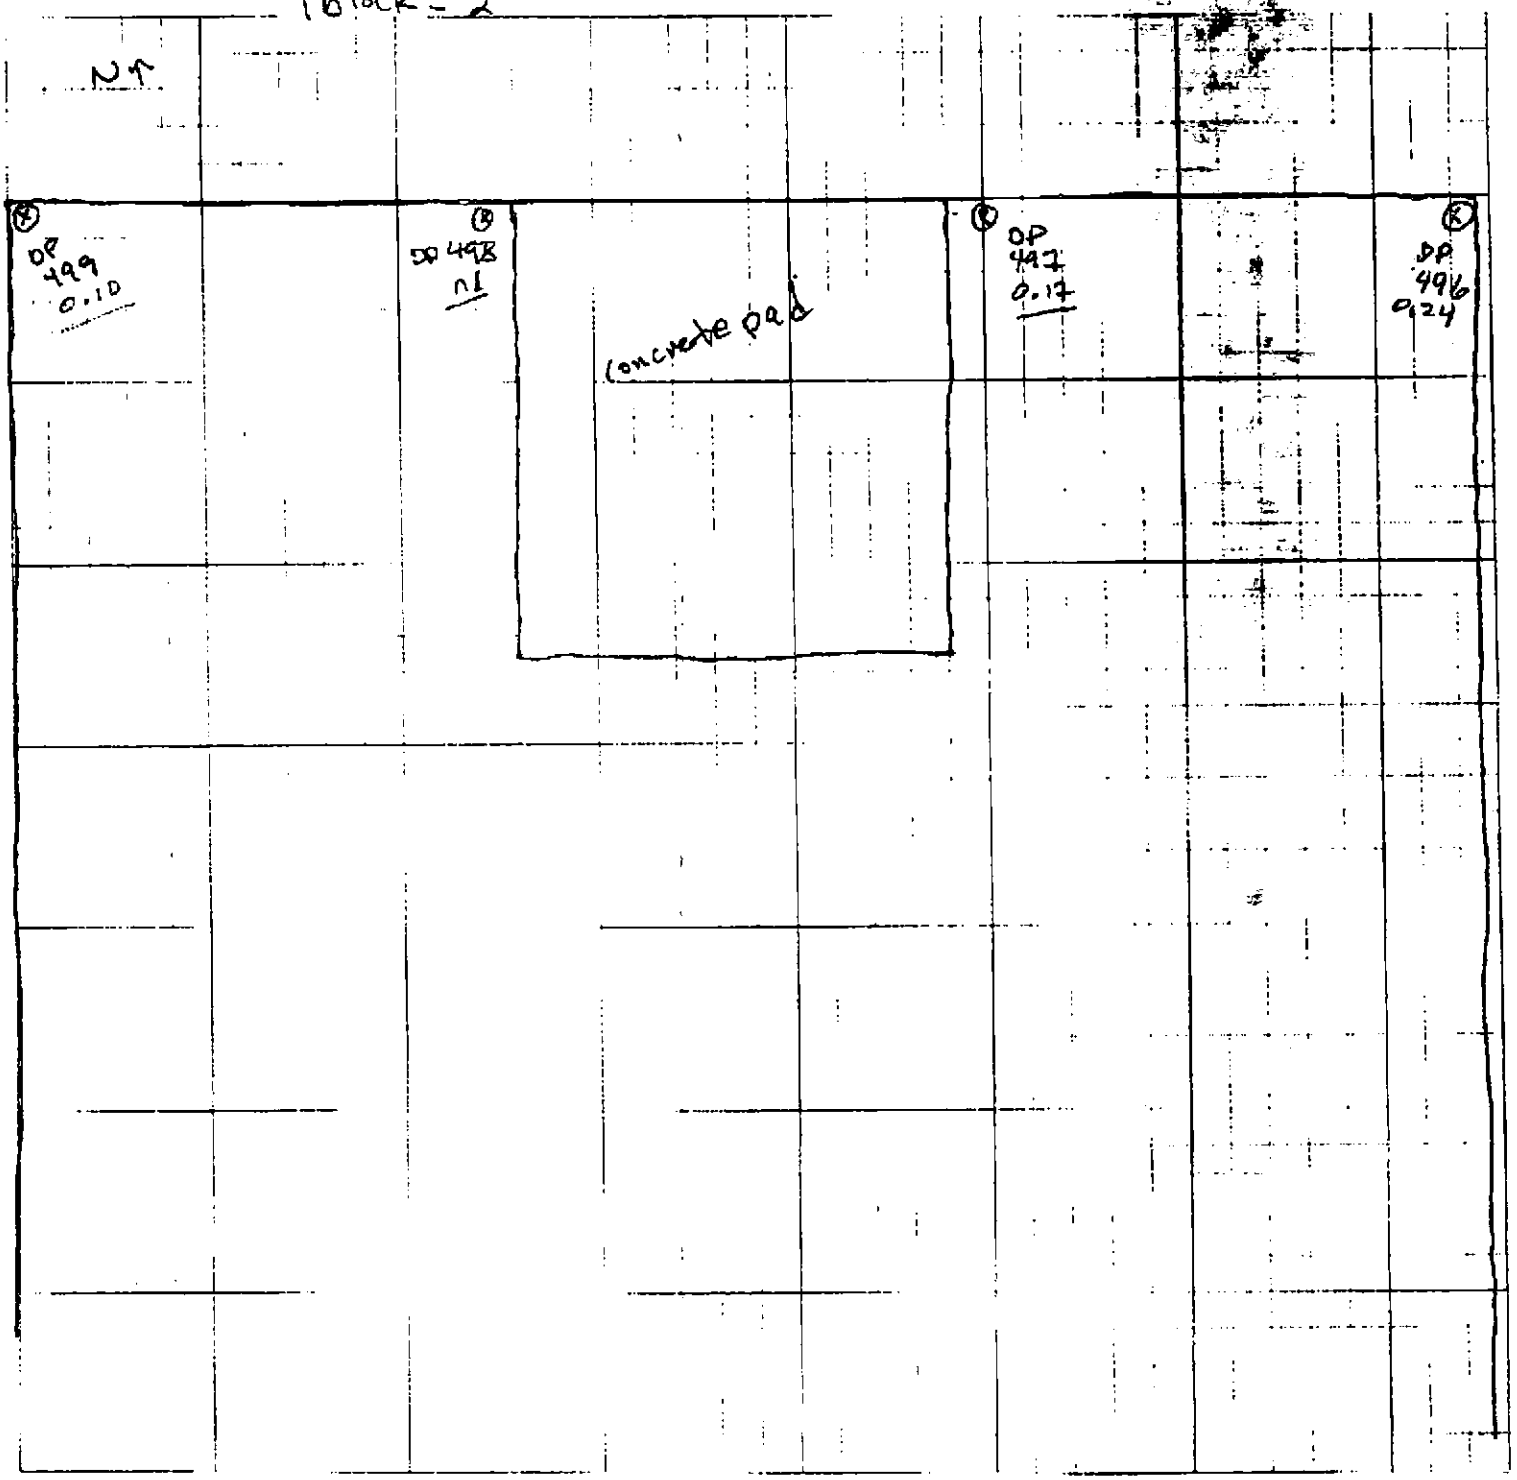

601 8926496

JGDEN

Job Name:

Job Number:

Title: Frazier Property

Computed by: TJF Checked by:

Date: 8/25/00 Sheet: 17 Of:

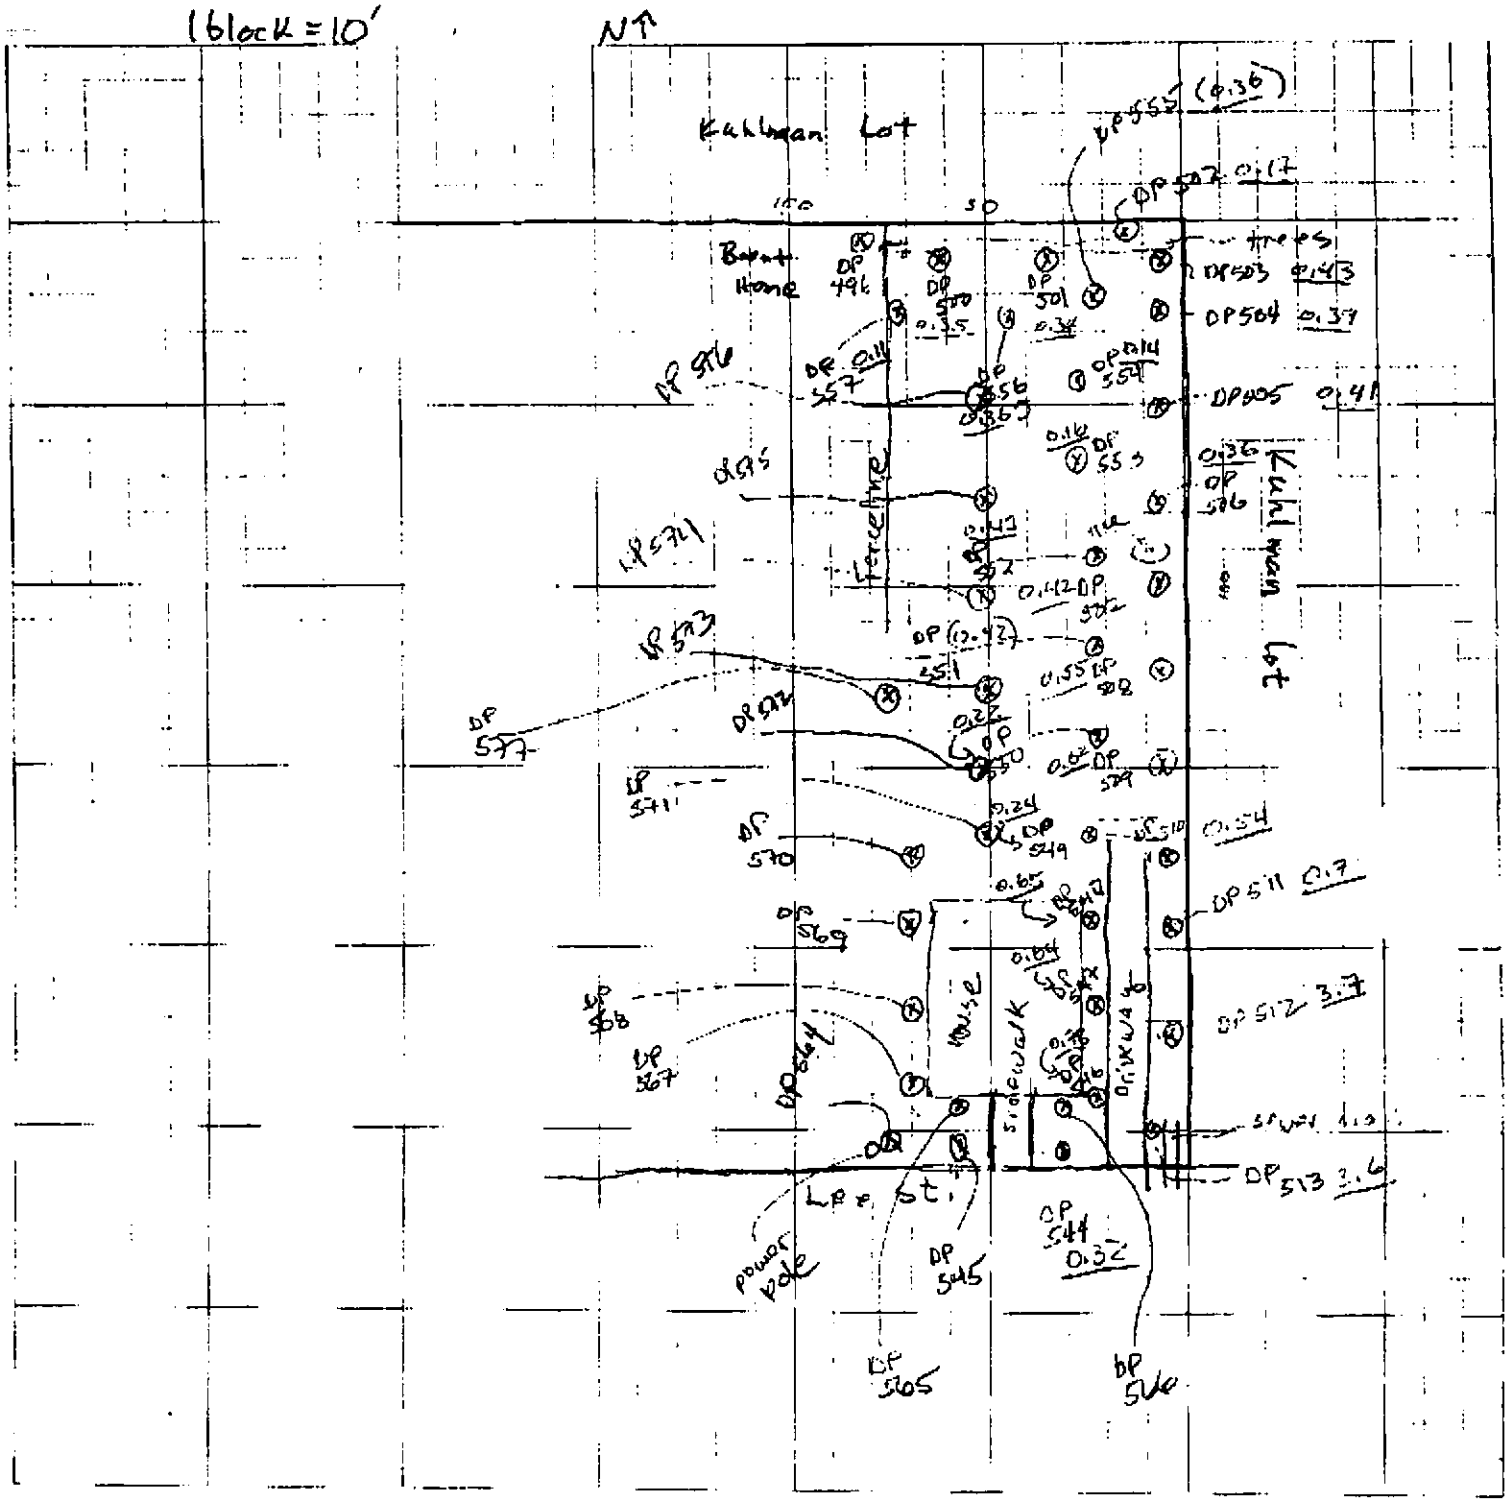

OGDEN

Job Name:

Job Number:

Title: Kuhlman South Parking Lot

Computed by: Checked by:

Date: 8/26/2000 Sheet 1B of

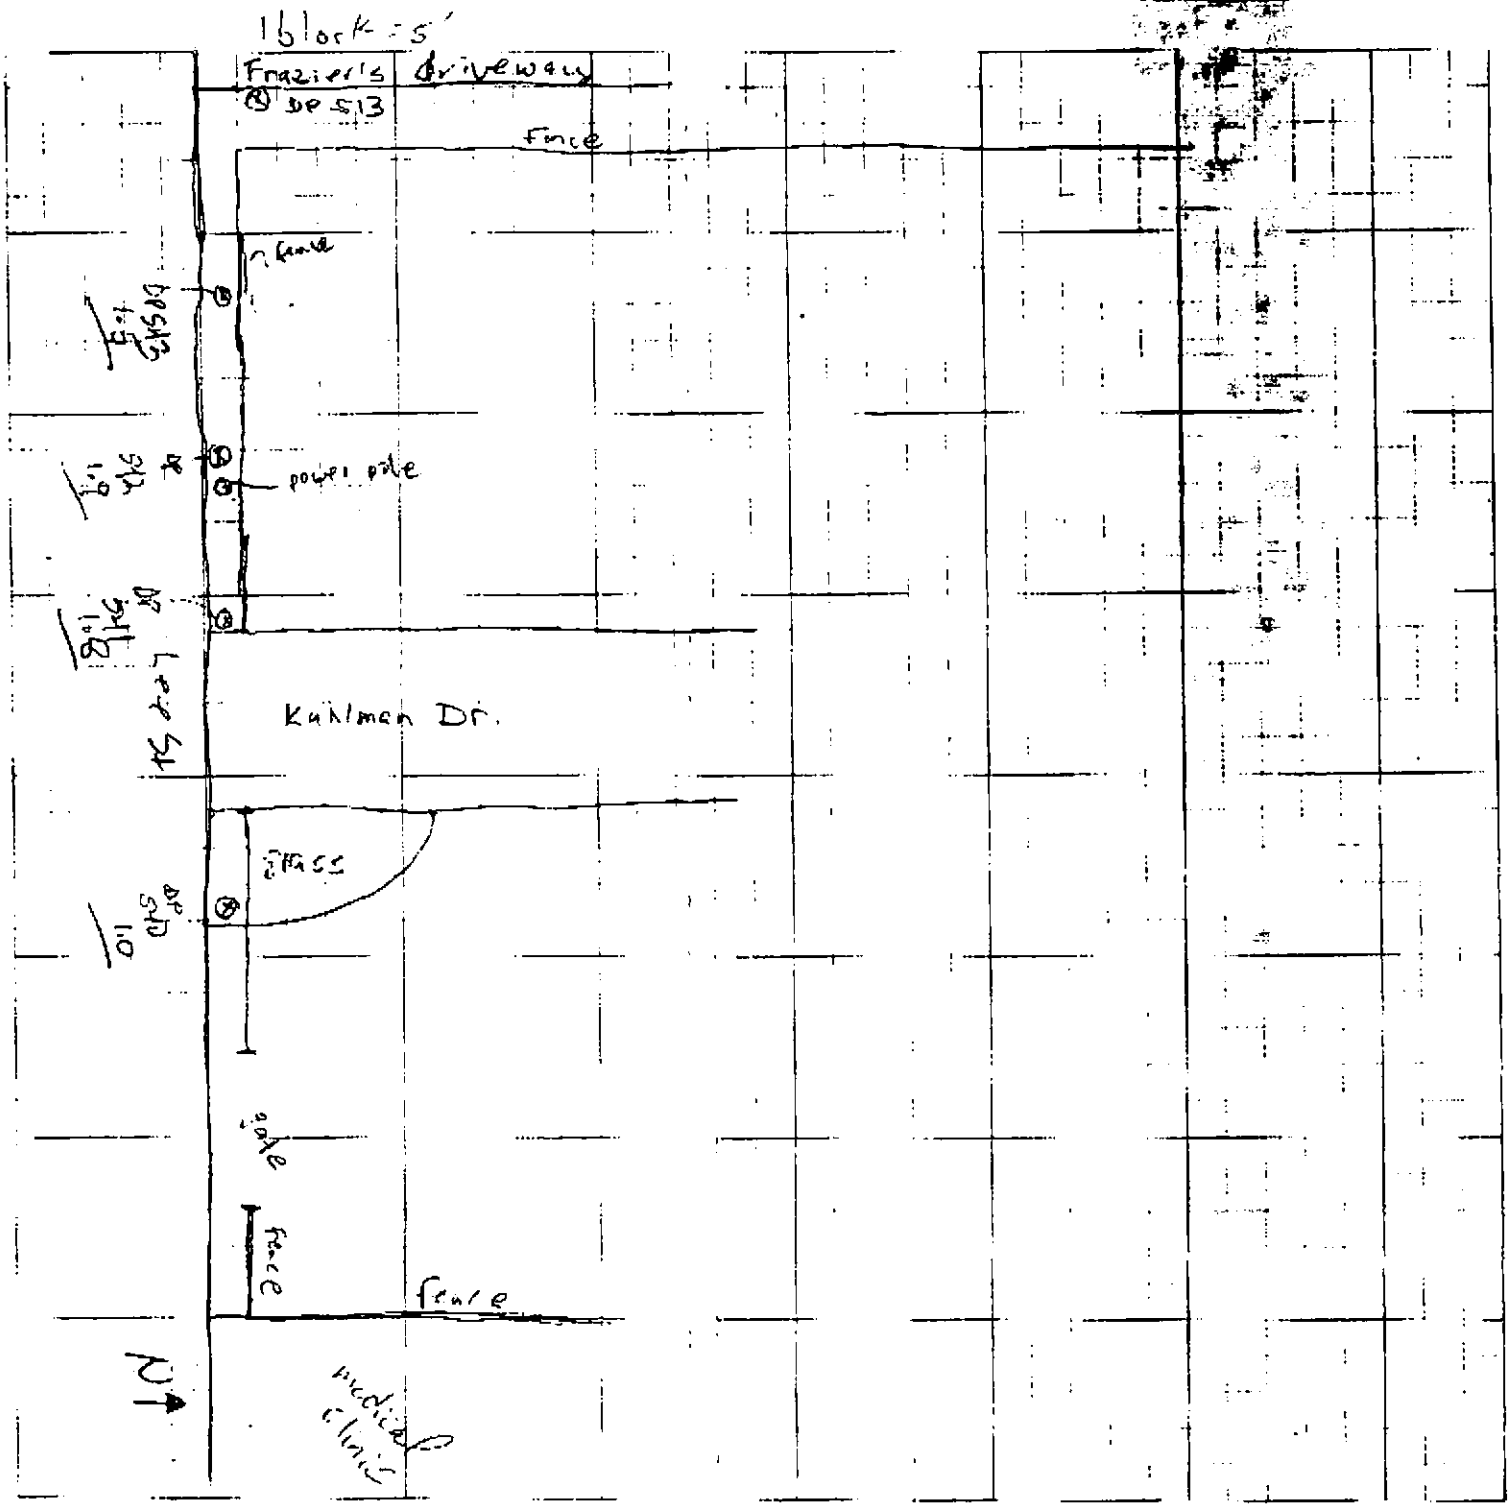

OGDEN

Job Name:
Job Number:
Title: 414 Lee St (Garment shop)
Computed by: JDF Checked by:
Date: 8/26/2000 Sheet: 19 Of:

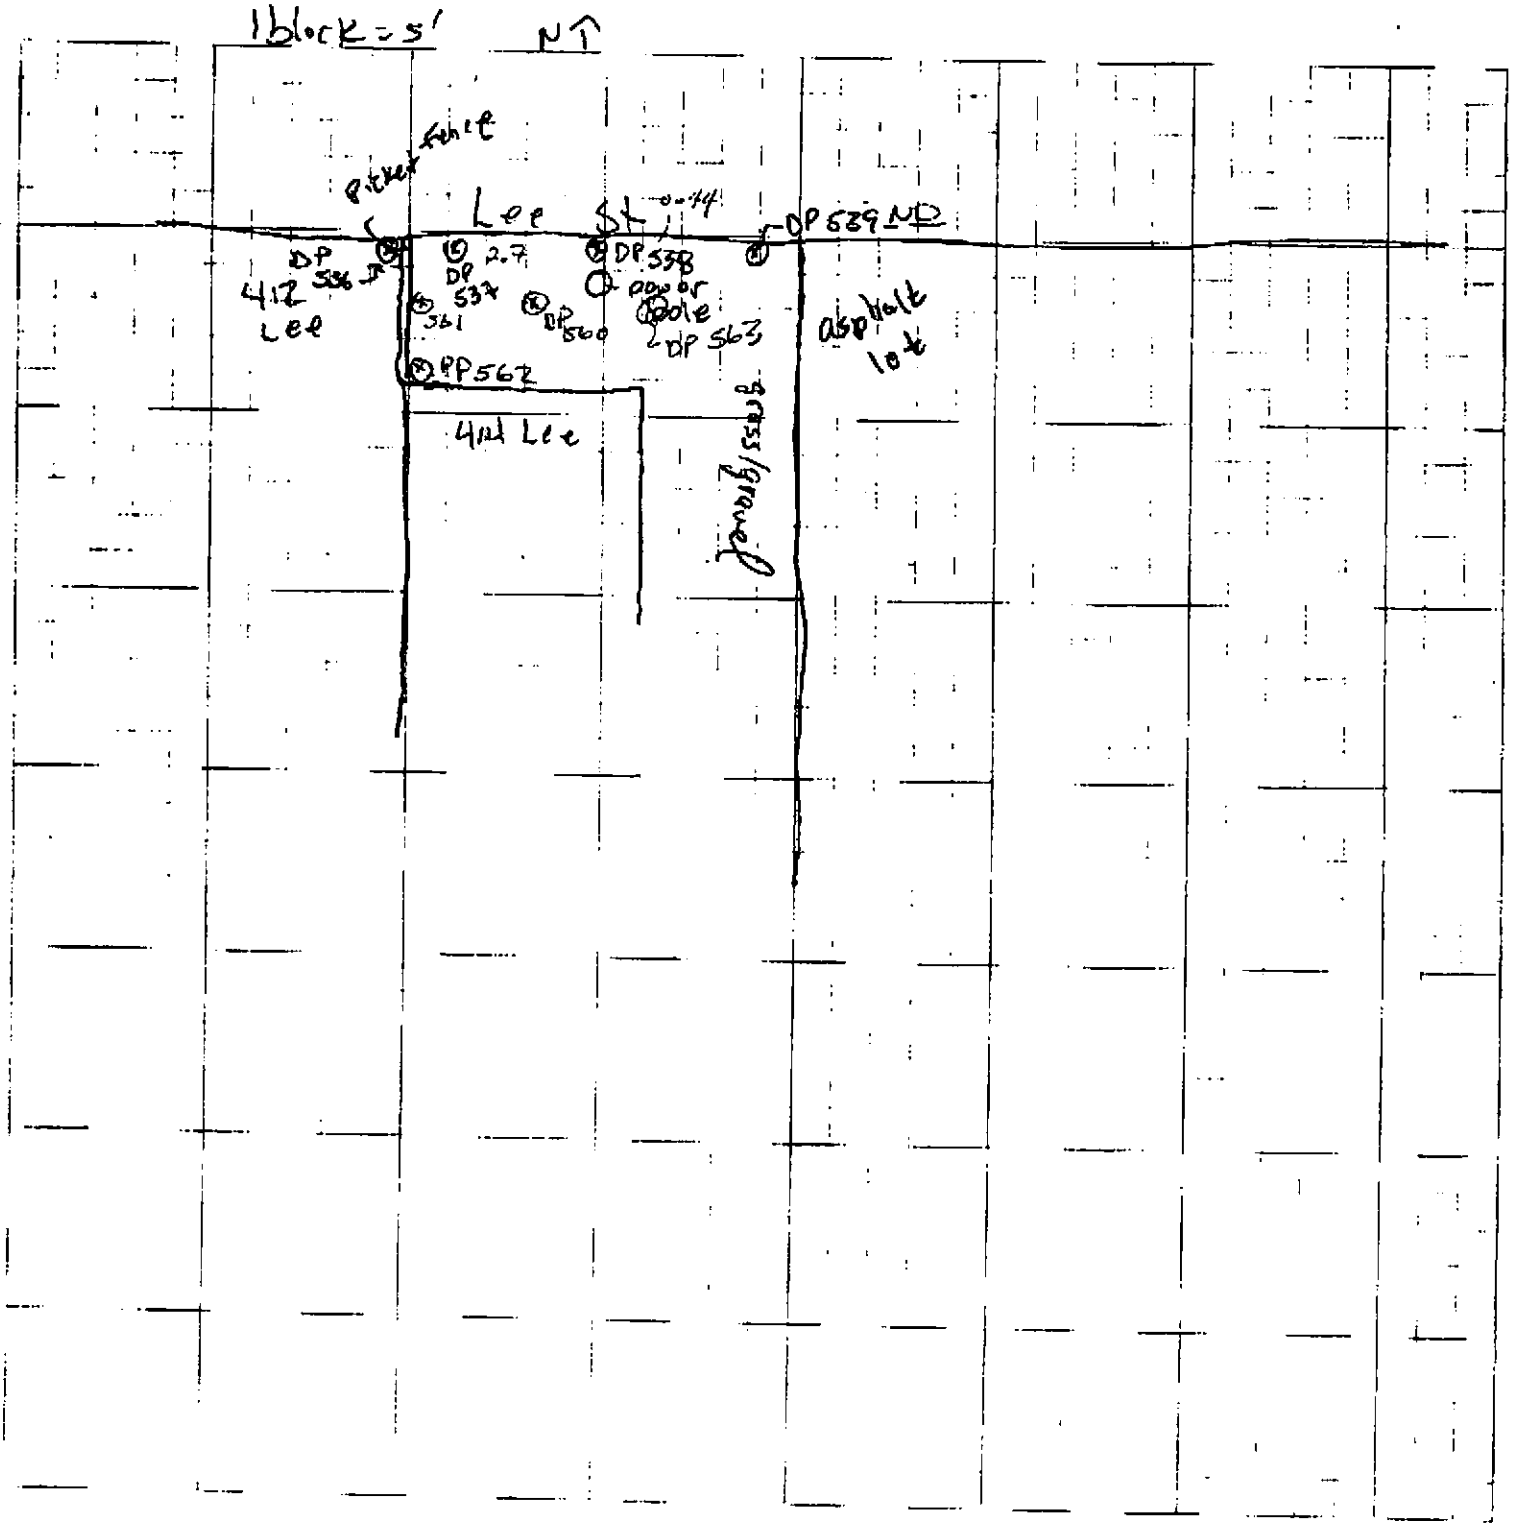

OGDEN

Job Name:
Job Number:
Title:
Computed by:
Date:

FILE COPY

Checked by:
Sheet: of:

To: Gretchin Zmitrovich
From Tim Fitzpatrick
RE: Crystal Springs
31 pages total

Ms. Zmitrovich:

Following ~~are~~ are data & maps from our investigation. We are complete at this time. Please forward the data to Mr. Robert Martin & Ms. Anastasia Hanel as well. Thank you

Tim Fitzpatrick
764 2363496 (cell)

Sample Tracking Form

Date: 15 Aug 00

Target Analyte	Sample Description 1	2	3	Blank #1	LCS #1	MS #3	MSD #3
1,3,5-TriCB	<0.10	<0.10	<0.20	<0.01	101	<0.20	<0.20
1,2,4-TriCB					105		
1,2,3-TriCB					102		
1,2,3,5&1,2,4,5					104		
1,2,3,4-TeCB					104		
Penta-CB					106		
Hexa-CB	↓	↓	↓	↓	111	↓	↓
PCB as 1260	10.0	10.5	6.2	<0.10	106	5.1	4.7
						109	
Surrogate TCMX	116	114	110	103	109	152	109
DCBP	125	111	120	118	109		142
	COMPANIES						
	1254	1254					
	VS 1260	VS 1260					
	WT:5	WT:5					
INT Data	15	15	15	15	15	15	15

J = Estimated
E = Exceeds calibration range

Sample Tracking Form

Date: 16AUG00

Target Analyte	Sample Description: ACID		ACID		ACID		ACID		ACID		ACID		ACID		ACID		ACID		ACID		Blank	LCS	8 MS	8 MSD
	DP300 0.5	DP300 4	DP301 0.5	DP301 4	DP302 0.5	DP302 4	DP303 0.5	DP303 4.0	DP304 0.5	DP304 4	DP305 0.5	DP305 4	DP306 0.5	DP306 4	DP307 0.5	DP307 4	DP308 0.5	DP308 4	DP309 0.5	DP309 4				
	4	5	6	7	8	9	10	11	12	13	14	15	16	17	18	19	20	21	22	23	#2	#2	#	#
1,3,5-TriCB	<0.01	<0.01	<0.01	<0.01	<0.01	<0.01	<0.01	<0.01	<0.01	<0.01	<0.01	<0.01	<0.01	<0.01	<0.01	<0.01	<0.01	<0.01	<0.01	<0.01	<0.01	99	145	146
1,2,4-TriCB																						99	141	142
1,2,3-TriCB																						99	140	141
1,2,3,5&1,2,4,5																						102	141	143
1,2,3,4-TeCB																						102	139	141
Penta-CB																						106	138	140
Hexa-CB	↓	↓	↓	↓	↓	↓	↓	↓	↓	↓	↓	↓	↓	↓	↓	↓	↓	↓	↓	↓	↓	107	135	136
PCB as 1260	<0.10	<0.10	<0.10	<0.10	<0.10	<0.10	<0.10	<0.10	0.29	<0.10	0.66	<0.10	<0.10	<0.10	0.16	<0.10	9.15	<0.10	<0.10	<0.10	<0.10	103	131	136
Surrogate TCMX	99.6	105	129	104	135	106	137	111	102	85.1	131	97.0	104	98.8	139	118	137	108	137	104	111	104	135	136
DCBP	89.5	100	96.9	101	125	115	130	109	87.9	83.9	129	99.4	101	95.0	140	116	133	107	132	103	111	107	120	130
						3																		
	THREE 1260					OVERS by TENS					TWO OFF SCALE UP PEAKS AFTER HCB LOOKS LIKE 1248 1260 17		THREE 1260						THREE 1260					
INJ Date	16	16	16	16	16	16	16	16	17	17	17	17	17	17	17	16	18	16	16	16	16	16	16	16
	AUGUST																							

J = Estimated
E = Exceeds calibration range

Sample Tracking Form

Date: Aug 16, 2000

DP310

Target Analyte	~~AP310~~ 05 24	PP310 4 25	DP311 0.5 26	311 4 27	312 0.5 28	312 4 29	313 0.5 30	313 4 31	314 0.5 32	314 4 33	315 0.5 34	315 4 35	316 0.5 36	316 4 37	317 0.5 38	317 4 39	318 0.5 40	318 4 41	319 0.5 42	319 4 43	~~30~~ Blank #3	~~30~~ LCS #3	MS # 30	MSD # 30
1,3,5-TriCB	<0.01	<0.01	<0.01	<0.01	<0.01	<0.01	<0.01	<0.01	<0.01	<0.01	<0.01	<0.01	<0.01	<0.01	<0.01	<0.01	<0.01	<0.01	<0.01	<0.01	<0.01	97.4	100	104
1,2,4-TriCB																						98.0	101	105
1,2,3-TriCB																						97.0	100	105
1,2,3,5&1,2,4,5																						99.5	103	107
1,2,3,4-TeCB																						99.4	103	107
Penta-CB																						101	106	108
Hexa-CB	↓	↓	↓	↓	↓	↓	↓	↓	↓	↓	↓	↓	↓	↓	↓	↓	↓	↓	↓	↓	↓	103	108	109
PCB as 1260	0.22	<0.10	<0.10	<0.10	<0.10	<0.10	<0.10	<0.10	0.16	<0.10	~~0.33~~ 0.12	<0.10	0.22	<0.10	<0.10	<0.10	<0.10	<0.10	0.13	<0.10	<0.10	100	112	107
Surrogate recov TCMX	101	83.8	96	74	111	93	110	107	112	99	134	107	127	98.0	107	103	109	102	106	112	104	100	103	107
DCBP	115	102	91	79	103	106	109	114	112	105	128	112	129	101	106	107	104	111	108	120	112	107	109	107
			~~TRACE~~ 1260		~~TRACE~~ 1260										~~TRACE~~ 1248 or 1254		~~TRACE~~ 1260							
INJ Date	16	17	17	17	17	17	17	17	17	17	17	17	17	17	17	17	17	17	17	17	17	17	17	17

AUG057

J = Estimated

E = Exceeds calibration range

Sample Tracking Form

Date: 16 AUG 2000

Target Analyte	ACID 320 0.5 44	ACID 320 4 45	321 0.5 46	321 2 47	321 4 48	322 0.5 49	322 4 50	323 0.5 51	323 4 52	324 0.5 53	324 4 54	Blank #4	LCS #4	MS #44	MSD #44
1,3,5-TriCB	<0.01	<0.01	<0.01	<0.01	<0.01	<0.01	<0.01	<0.01	<0.01	<0.01	<0.01	<0.01	104	150	147
1,2,4-TriCB													104	147	145
1,2,3-TriCB													104	145	143
1,2,3,5&1,2,4,5													103	147	145
1,2,3,4-TeCB													104	143	141
Penta-CB													105	143	141
Hexa-CB	↓	↓	↓	↓	↓	↓	↓	↓	↓	↓	↓	↓	102	140	138
PCB as 1260	0.28	<0.10	0.23	<0.10	<0.10	<0.10	<0.10	<0.10	<0.10	0.25	<0.10	<0.10	102	161	137
Surrogate TCMX	141	112	134	107	93.7	103	105	106	104	99.6	107	111	101	139	133
DiBP	155	117	137	111	105	110	116	109	113	104	107	122	104	147	149
			OC PEAK BY UNKNOWN					TRACE 1260							
IS Data	17	17	17	17	17	17	17	17	17	17	17	17	17	17	17

AVG057 00

J = Estimated

E = Exceeds calibration range

Sample Tracking Form

PAGE 1-2 PIL 1-5

Page 1 of 2

Date: August 17, 2000

Target Analyte	Sample Description																							
	ACID				ACID		ACID								ACID		ACID						ACID	ACID
	325 05 55	325 4 56	326 0.5 57	326 4 58	327 05 59	327 4 60	328 05 61	328 4 62	329 05 63	329 4 64	330 05 65	330 4 66	331 0.5 67	331 4 68	332 0.5 69	332 4 70	333 0.5 71	333 4 72	334 0.5 73	334 4 74	Blank #5	LCS #5	MS #61	MSD #61
1,3,5-TriCB	<0.01	<0.01	<0.01	<0.01	<0.01	<0.01	<0.01	<0.01	<0.01	<0.01	<0.01	<0.01	<0.01	<0.01	<0.01	<0.01	<0.01	<0.01	<0.01	<0.01	<0.01	99.8	149	152
1,2,4-TriCB																						99.4	149	150
1,2,3-TriCB																						98.4	147	148
1,2,3,5&1,2,4,5																						98.4	149	150
1,2,3,4-TeCB																						97.0	148	148
Penta-CB																						98.4	147	147
Hexa-CB	↓	↓	↓	↓	↓	↓	↓	↓	↓	↓	↓	↓	↓	↓	↓	↓	↓	↓	↓	↓	↓	96.8	141	141
PCB as 1260	0.99	<0.10	0.43	<0.10	0.45	<0.10	4.0	<0.10	0.69	<0.10	0.34	<0.10	0.52	<0.10	3.4	<0.10	6.1	<0.10	<0.10	<0.10	<0.10	108	120	122
Surrogate TCMX	143	103	108	104	109	109	145	104	103	108	107	107	132	104	133	100	137	103	104	105	103	97.4	147	143
DCBP	132	103	107	117	113	115	156	107	103	110	105	110	134	110	140	108	127	113	110	114	116	128	152	132
					07																			
		TRACE			Peak						07					TRACE			1.00					
		1260			AT						PEAK					1260			1260					
					2789						AT													
											7.782													

J = Estimated

E = Exceeds calibration range

Sample Tracking Form

Page 1 of 2

Date: August 11, 2000

Target Analyte	Sample Description																							
	ACID 335 0.5 75	335 4 76	336 ~~0.5~~ 4 78 ~~77~~	336 ~~4~~ 0.5 77 ~~78~~	337 0.5 79	337 4 80	ACID 338 0.5 81	338 4 82	ACID 339 0.5 83	339 4 84	340 0.5 85	340 4 86	341 0.5 87	341 4 88	ACID 342 0.5 89	342 4 90	343 0.5 91	343 4 92	344 0.5 93	344 4 94	Blank # 16	LCS # 16	1-20 0.5 MS # 75	MSD # 75
1,3,5-TriCB	<0.01	<0.01	<0.01	<0.01	<0.01	<0.01	<0.01	<0.01	<0.01	<0.01	<0.01	<0.01	<0.01	<0.01	<0.01	<0.01	<0.01	<0.01	<0.01	<0.01	<0.01	976	148	146
1,2,4-TriCB																						986	146	145
1,2,3-TriCB																						982	144	143
1,2,3,5&1,2,4,5																						979	146	144
1,2,3,4-TeCB																						976	144	142
Penta-CB																						986	144	142
Hexa-CB																						978	139	138
PCB as 1260	0.32	<0.10	<0.10	0.74	0.12	<0.10	0.25	<0.10	0.96	<0.10	0.73	<0.01	0.25	<0.01	0.60	<0.01	0.12	<0.10	0.17	<0.10	<0.10	970		134
Surrogate TCMX	128	107	105	111	110	103	139	110	143	102	105	106	135	98	133	96	102	993	104	103	100	982	141	140
DCBP	142	117	115	112	123	109	162	117	153	112	115	116	146	108	139	101	102	114	108	110	130	110	162	158
																							29	
LOS Data	18	18	18	18	18	18	18	18	18	18	18	18	18	18	18	18	18	18	18	18	18	18	18	18

J = Estimated
E = Exceeds calibration range

Sample Tracking Form

Page 2 of 4[illegible]

Date: 17 AUG 00

Target Analyte	345 0.5 95	345 4 96	346 0.5 97	346 4 98	347 0.5 99	347 4 100	348 0.5 101	348 4 102	349 0.5 103	349 4 104	Smpl 1.5 105	Smpl 555 106	350 0.5 107	350 4 108	351 0.5 109	351 4 110	352 0.5 111	352 4 112	353 0.5 113	353 4 114	Blank #7	LCS #7	MS #95	MSD #95
1,3,5-TriCB	<0.01	<0.01	<0.01	<0.01	<0.01	<0.01	<0.01	<0.01	<0.01	<0.01	<0.01	<0.01									<0.01	98.2	88.8	96.6
1,2,4-TriCB																						98.4	88.8	96.2
1,2,3-TriCB																						97.2	87.6	96.0
1,2,3,5&1,2,4,5																						99.0	92.1	97.3
1,2,3,4-TeCB																						96.5	91.0	94.8
Penta-CB																						97.5	98.2	97.6
Hexa-CB																								
																						100	101	101
PCB as 1260	<0.10	<0.10	0.31	<0.10	0.13	<0.10	0.22	<0.10	0.61	<0.10	0.29	<0.10									<0.10	104	110	98.9
Surrogate TCMX	106	99.9	99.3	98.7	98.7	99.6	94.5	95.4	122	90.0	105	89.8									114	98.3	94.9	99.8
DCBP	108	108	100	112	107	111	104	107	137	106	121	113									128	114	103	90.9
	[illegible] 1260							[illegible]	02 PEAK AFTER [illegible]		MIX of 1260/ 1254 W/81													
Ins Date	18	18	18	18	18	18	18	18	18	18	18	18									18 17	18	18	18

J = Estimated AUGUST 00

E = Exceeds calibration range

Sample Tracking Form

Date: 18 Aug 00

Target Analyte	Sample Description																							
	350 0.5 107	350 4 108	351 0.5 109	351 4 110	352 0.5 111	352 4 112	353 0.5 113	353 4 114	354 0.5 115	354 4 116	HA-1 0.5 117	1 4 118	2 0.5 119	2 4 120	3 0.5 121	3 1.5 122	4 0.5 123	4 2.5 124	5 0.5 125	5 2.5 126	Blank # 8	LCS # 8	MS # 107	MSD # 107
1,3,5-TriCB	<0.01	<0.01	<0.01	<0.01	<0.01	<0.01	<0.01	<0.01	<0.01	<0.01	<0.01	<0.01	<0.01	<0.01	<0.01	<0.01	<0.01	<0.01	<0.01	<0.01	<0.01	86.6	140	137
1,2,4-TriCB																						79.9	135	135
1,2,3-TriCB																						79.3	133	131
1,2,3,5&1,2,4,5																						150	133	131
1,2,3,4-TeCB																						149	126	124
Penta-CB																						57.3	124	121
Hexa-CB																						61.0	124	122
PCB as 1260	1.8	<0.10	0.33	<0.10	0.55	<0.10	1.6	<0.10	0.19	<0.10	0.19	<0.10	7.2	<0.10	0.17	0.31	<0.10	<0.10	<0.10	<0.10	<0.10	65.6	121	117
Surrogate TCMX	104	100	96.1	96.4	101	90.0	114	87.7	114	87.3	90.7	90.6	118	86.7	90.6	87.1	87.3	77.0	82.8	82.9	109	65.7	124	117
DCBP	116	114	108	116	114	105	138	112	135	109	101	113	136	114	106	105	104	110	102	104	98.7	92.6	138	129
(NJ Det	18	18	18	18	18	18	18	18	18	18	18	8	18	18	18	18	18	18	18	18	19	19	18	18

J = Estimated
E = Exceeds calibration range

Sample Tracking Form

Date: 18 Aug 00

Target Analyte	HA-6 0.5 127	6 2.5 128	7 0.5 129	7 1.5 130	355 0.5 131	355 4 132	356 0.5 133	356 4 134	357 0.5 135	357 4 136	358 0.5 137	358 4 138	359 0.5 139	359 4 140	360 0.5 141	360 4 142	361 0.5 143	361 4 144	362 0.5 145	362 4 146	Blank #9	LCS #9	MS #128	MSD #128
1,3,5-TriCB	<0.01	<0.01	<0.01	<0.01	<0.01	<0.01	<0.01	<0.01	<0.01	<0.01	<0.01	<0.01	<0.01	<0.01	<0.01		<0.01	<0.01	<0.01	<0.01	<0.01	95.6	87.4	89.4
1,2,4-TriCB																						89.6	83.6	84.8
1,2,3-TriCB																						88.8	82.2	83.2
1,2,3,5&1,2,4,5																						104	78.3	80.2
1,2,3,4-TeCB																						73.5	70.2	71.6
Penta-CB																						66.3	63.8	64.8
Hexa-CB																						77.9	67.8	68.4
PCB as 1260	0.10	<0.10	0.11	0.16	0.33	<0.10	0.20	<0.10	0.17	<0.10	<0.10	<0.10	<0.10	<0.10	<0.10		0.22	<0.10	0.47	<0.10	<0.10	77.1	73.7	72.3
Surrogate TCMX	107	75.3	103	98.2	130	64.3	120	62.5	96.1	65.4	64.9	62.2	59.2	60.5	93		96	103	123	94.6	117	72.4	71.0	72.0
DCBP	129	97.7	130	123	73.8	99.4	281	106	180	96.6	94.4	97.8	107	92.6	101		108	106	135	96.6	129		91.7	96.2
																					73.1	71.7		
																					98.4	100		
				MIX																				
				1254																				
				1260																				
				Nil																				
INJ Date	18	19	19	19	19	19	19	19	19	19	19	19	19	19	18		18	19	18	19	19	19	19	19

J = Estimated
E = Exceeds calibration range

Page _____ of _____

Sample Tracking Form

Date: 18 Aug 00

Target Analyte	Acid 363 0.5 #147	363 4 #148	Acid 364 05 #149	364 4 #150	Acid 365 05 #151	365 4 #152	366 05 #153	366 4 #154	367 05 #155	367 4 #156	368 05 #157	368 4 #158	Acid 369 05 #159	369 4 #160	AcID 370 05 #161	370 4 #162	371 05 #163	371 4 #164	372 05 #165	372 4 #166	Blank # 10	LCS # 10	Acid MS # 147	Acid MSD # 147
1,3,5-TriCB	<0.01	<0.01	<0.01	<0.01	<0.01		<0.01		<0.01		<0.01		<0.01	<0.01	<0.01		<0.01		<0.01		<0.01	92	125	127
1,2,4-TriCB																						91	125	126
1,2,3-TriCB																						91	122	124
1,2,3,5&1,2,4,5																						177	246	250
1,2,3,4-TeCB																						85	118	121
Penta-CB																						81	116	117
Hexa-CB	↓	↓	↓	↓	↓		↓		↓		↓		↓	↓	↓		↓		↓		↓	80	114	115
PCB as 1260	0.42	<0.10	0.34	<0.10	<1.0 ~~0.075~~ ~~0.03~~		~~0.040~~ <0.10		~~0.09~~ <0.10		~~0.07~~ <0.10		0.45	<0.10	~~0.05~~ <0.10		~~0.03~~ <0.10		~~0.04~~ ~~0.95~~ <0.10		<0.01	81	136	136
Surrogate TCMX	112	92.6	119	89.1	120		87		90		88		115	90.3	116		85		~~98~~ 84		89	74	121	120
DCBP	129	99.9	129	91.0	120		103		102		102		124	92.4	130		102		~~110~~ 100		107	91	137	132
	18	19	19		19		19		19		19		19		19		19		19		19	19	18	18

J = Estimated
E = Exceeds calibration range

Sample Tracking Form

Date: 18 Aug 00

Target Analyte	Sample Description																				Blank	LCS	MS	MSD
	373 0.5	373 4	374 0.5	374 4	375 0.5	375 4	376 0.5	376 4	377 0.5	377 4	378 0.5	378 4	379 0.5	379 4	380 0.5	380 4	381 0.5	381 4			#	#	#	#
	1167	1168	1169	1170	171	172	173	174	175	176	177	178	179	180	181	182	183	184			11	11	167	167
1,3,5-TriCB	<0.01		<0.01		<0.01		<0.01		<0.01		<0.01		<0.01		<0.01		<0.01				<0.01	91	87	88
1,2,4-TriCB																						90	86	86
1,2,3-TriCB																						89	86	86
1,2,3,5&1,2,4,5																						196	188	188
1,2,3,4-TeCB																						88	80	80
Penta-CB																						79	76	76
Hexa-CB																						79	77	77
PCB as 1260	0.05		0.08		0.07		0.09		0.01		0.02		0.01		0.02		<0.10				<0.01	85	84	88
	<0.10		<0.10		<0.10		<0.10		<0.10		<0.10		<0.10		<0.10									
Surrogate TCMX	82		113		110		117		80		81		77		79		85.7				91	82	79	80
DCBP	99		124		120		138		96		99		90		99		108				111	101	97	93
	19		19		19		19		19		19		19		19		19				19	19	19	19

J = Estimated

E = Exceeds calibration range

Sample Tracking Form

Date: 19AU00

Target Analyte	Acid		Acid		Acid		Acid		Acid		Acid (Sample Description)		Acid		Acid								Acid	Acid
	382 0.5 185	382 4 186	383 0.5 187	383 4 188	384 0.5 189	384 4 190	385 0.5 191	385 4 192	386 0.5 193	386 4 194	387 0.5 195	387 4 196	388 0.5 197	388 4 198	389 0.5 199	389 4 200	390 0.5 201	390 4 202	391 0.5 203	391 4 204	Blank #12	LCS #12	MS # 199	MSD # 199
1,3,5-TriCB	<0.01		<0.01		<0.01		<0.01	<0.01	<0.01		<0.01		<0.01		<0.01		<0.01		<0.01		<0.01	91.9	136	132
1,2,4-TriCB																						91.7	136	133
1,2,3-TriCB																						92.2	133	129
1,2,3,5&1,2,4,5																						18.6	137	132
1,2,3,4-TeCB																						92.9	138	132
Penta-CB																						95.7	140	135
Hexa-CB																						95.7	140	134
PCB as 1260	<0.10		<0.10		<0.10		0.08	<0.10	<0.10		<0.10		<0.10		<0.10		<0.10		<0.10		<0.10	94.1	~~144~~ 135	130
Surrogate TCMX	133		139		136		140	116	139		97.7		138		137		103		103		106	94.0	144	139
DCBP	111		126		115		117	82.2	97.1		93.2		111		122		96.9		105		98.9	90.9	121	120
	UI		BLANKS																					
	PEAK		UI PEAKS																					
	START		START OF				1254						TRACE		TRACE									
	1260		1260				1260				TRACE		1260		1260									
											1260													
	TRACE		TRACE		TRACE		N/12		1260															
	1260		1260		1260				JUST															
									UNDER															
			UI						LIMIT															
			off scale																					
INS Date	19		19		19		19	19	19		19		19		19		19		19		19	19	19	19

J = Estimated
E = Exceeds calibration range

Sample Tracking Form

Page ___ of ___

Date: 19-Aug-00

Target Analyte	392 0.5 205	392 4 206	393 0.5 207	393 4 208	394 0.5 209	394 4 210	395 0.5 211	395 4 212	396 0.5 213	396 4 214	397 0.5 215	397 4 216	398 0.5 217	398 4 218	399 0.5 219	399 4 220	400 0.5 221	400 4 222	401 0.5 223	401 4 224	Blank #13	LCS #13	MS #205	MSD #205
1,3,5-TriCB	<0.01		<0.01		<0.01		<0.01	<0.01	<0.01		<0.01		<0.01		<0.01		<0.01		<0.01		<0.01	88.9	90.5	92.0
1,2,4-TriCB																						87.[illegible]	90.5	92.0
1,2,3-TriCB																						87.5	90.4	92.0
1,2,3,5&1,2,4,5																						175	199	187
1,2,3,4-TeCB																						86.8	92.6	93.5
Penta-CB																						86.3	94.7	95.5
Hexa-CB																						87.1	94.1	98.[illegible]
PCB as 1260	<0.10		<0.10		<0.10		0.14	<0.10	<0.10		<0.10		<0.10		<0.10		<0.10		<0.10		<0.10	87.1	93.2	94.5
Surrogate TCMX	103		102	~~99.6~~	99.6		95.6	77.1	92.9		96.9		97.6		93.0		96.0		92.3		97.6	88.4	97.4	98.4
DCBP	95.9		90.8	~~90.5~~	91.5		96.5	82.0	96.0		97.7		130		98.9		98.0		83.1		101	96.3	86.9	92.6
									[illegible]															
INT Date	19		19		19		19		19		19		19		19		19		19		19	19	19	19

J = Estimated

E = Exceeds calibration range

Sample Tracking Form

Date: 19 Aug 20

Target Analyte	Sample Description																							
	402 0.5 225	402 4 226	403 0.5 227	403 4 228	404 0.5 229	404 4 230	405 0.5 231	405 4 232	406 0.5 233	406 4 234	407 0.5 235	407 4 236	408 0.5 237	408 4 238	409 0.5 239	409 4 240	410 0.5 241	410 4 242	411 0.5 243	411 4 244	Blank # 14	LCS # 14	MS # 225	MSD # 225
1,3,5-TriCB	4.01		40.01		40.01		40.01	40.01	40.01	40.01	40.01		40.01		40.01		40.01		001	40.01	40.01	94.6	92.9	90.2
1,2,4-TriCB	↓		↓		↓		↓	↓	↓	↓	↓		↓		↓		↓		↓	↓	↓	92.8	91.2	88.2
1,2,3-TriCB																						92.8	91.5	88.2
1,2,3,5&1,2,4,5																						92.2	183	88.9
1,2,3,4-TeCB																						91.2	90.6	88.0
Penta-CB																						89.4	89.9	87.6
Hexa-CB	↓		↓		↓		↓	↓	↓	↓	↓		↓		↓		↓		↓	↓	↓	90.8	90.4	88.4
PCB as 1260	<0.10		<0.10		0.10		<0.10	0.12	0.12	<0.10	<0.10		<0.10		<0.10		<0.10		0.28	<0.10	<0.10	86.8	93.6	88.8
Surrogate TCMX	93.2		93.7		94.0		95.8		95.4	92.3	94.9		92.2		95.6		92.3		123	93.8	92.9	92.1	89.6	89.5
DCBP	95.3		94.7		93.5		95.0		91.8	98.1	93.1		95.2		91.4		91.2		119	95.5	92.9	92.6	92.4	89.9
INJ Date	19		19		19		19		19	20	19		19		20		19		19	20	20	20	19	19

J = Estimated

E = Exceeds calibration range

Sample Tracking Form

Date: 19 Aug 00

Target Analyte	Sample Description																							
	412 0.5 245	412 4 246	413 0.5 247	413 4 248	414 0.5 249	414 4 250	415 0.5 251	415 4 252	416 0.5 253	416 4 254	417 0.5 255	417 4 256	418 0.5 257	418 4 258	419 0.5 259	419 4 260	420 0.5 261	420 4 262	421 0.5 263	421 4 264	Blank # 15	LCS # 15	MS # 249	MSD # 249
1,3,5-TriCB	<0.01	<0.01	<0.01		<0.01	<0.01	<0.01	<0.01	<0.01		<0.01	<0.01	<0.01	<0.01	<0.01	<0.01	<0.01		<0.01	<0.01	<0.01	89.1	88.6	86.0
1,2,4-TriCB																						88.9	88.3	85.1
1,2,3-TriCB																						89.0	88.2	84.8
1,2,3,5&1,2,4,5																						17.9	17.7	17.1
1,2,3,4-TeCB																						88.6	86.8	83.4
Penta-CB																						89.3	86.7	83.4
Hexa-CB																						89.6	87.9	84.8
PCB as 1260	0.78	<0.10	<0.10		0.14	<0.10	<0.10	<0.10	<0.10		<0.05 0.10	<0.10	1.1	<0.10	0.92	<0.10	<0.10		0.55	<0.10	<0.10	86.4	94.6	95.5
Surrogate TCMX	126	82.3	91.4		92.1	87.4	78.2	78.5	92.4		94.6	84.6	121	80.3	87.4	88.3	84.1		85.5	77.0	98.4	89.9	93.6	87.9
DCBP	111	91.5	84.1		72.7	95.2	51.7	86.4	89.9		91.8	87.5	107	87.8	85.1	95.6	85.0		85.5	86.4	91.8	85.7	71.0	73.2
							<0.01																	
							0.12																	
							85.6																	
							86.2																	
# Dets	19	20	19		19	20	20		20		20	20	20		20	20	20		20	20	19	19	19	20

J = Estimated
E = Exceeds calibration range

Sample Tracking Form

Date: 19 Aug 00

ACD

Target Analyte	Sample Description												Blank #	LCS #	MS #	M #
	422 0.5 265	422 4 266	423 0.5 267	423 4 268	424 0.5 269	424 4 270	425 0.5 271	425 4 272	426 0.5 273	426 4 274	427 0.5 275	427 4 276				
1,3,5-TriCB	<0.01	<0.01	<0.01	<0.01	<0.01		<0.01	<0.01	<0.01		<0.01	<0.01				
1,2,4-TriCB																
1,2,3-TriCB																
1,2,3,5&1,2,4,5																
1,2,3,4-TeCB																
Penta-CB																
Hexa-CB																
PCB as 1260	0.19	<0.10	0.19	<0.10	<0.10		0.12	<0.10	<0.10		0.14	<0.10				
Surrogate TCMX	119	70.3	115	75.0	88.6		84.2	75.6	83.7		86.4	75.7				
DCBP	115	81.9	119	86.6	85.2		83.3	79.7	88.6		94.1	85.1				
IDS Date	20	20	20	20	20		20	20	20		20	20				

See Previous page

J = Estimated
E = Exceeds calibration range

Sample Tracking Form

Date: 20 Aug. 00

Target Analyte	428 0.5 277	428 4 276	429 0.5 279	429 4 280	430 0.5 281	430 4 282	431 0.5 285	431 4 284	432 0.5 285	432 4 286	433 0.5 287	433 4 288	434 0.5 289	434 4 290	435 0.5 291	435 4 292	436 0.5 293	436 4 294	HA-7 2.25 295	HA-8 0.5 296	Blank # 116	LCS # 116	MS # 279	M # 2
Sample Description			Acid		Acid		Acid		Acid								Aq			Aq				
1,3,5-TriCB	<0.01		<0.01	<0.01	<0.01	<0.01	<0.01	<0.01	<0.01	<0.01	<0.01		<0.01		<0.01	<0.01	<0.01	<0.01	<0.01	<0.01	<0.01		89.8	9
1,2,4-TriCB																							87.0	8
1,2,3-TriCB																							88.3	8
1,2,3,5&1,2,4,5																							173	17
1,2,3,4-TeCB																							85.1	8
Penta-CB																							80.4	
Hexa-CB																							80.7	
PCB as 1260	0.44		0.89	<0.10	1.6	<0.10	0.70	<0.10	5.1	<0.10	<0.10		<0.10		0.24	1.00	0.68	<0.10	<0.10	<2.0	<0.10		110	
Surrogate TMX	90.3	87	117	73.4	121	61.4	120	68.3	126	85.5	83.6		86.2		85.7	77.6	130	84	85.9	127	87.7		85.2	
DCB	91.4	120	120	88.2	123	87.4	118	85.7	123	99.2	86.1		89.9		89.4	93.3	105	90.4	94.6	125	91.6		94.4	
		<0.9																						
		<0.10																						
		20.5																						
		85.2																						
INJ Date	20	20	20	20	20	20	20	20	20	20	20		20		20	20	20	20	20	20				

J = Estimated

E = Exceeds calibration range

Sample Tracking Form

Date: 20 Aug 00

Target Analyte	HA 8 2.25 297 (TOX)	HA 9 0.5 298 (TOX, Acid)	HA 9 2.5 299 (TOX, Acid)	DP 437 0.5 300	437 4 301	438 0.5 302	438 4 303	439 0.5 304	439 4 305	440 0.5 306	440 4 307	441 0.5 308 (Acid)	441 4 309	442 0.5 310 (Acid)	442 4 311	443 0.5 312 (Acid)	443 4 313	444 0.5 314 (Acid)	448 4 315	445 0.5 316 (Acid)	Blank # 17	LCS # 17	MS # 304	MSD # 304
1,3,5-TriCB	<0.01	<0.01	<0.01	<0.01		<0.01		<0.01		<0.01		<0.01		<0.01		<0.01		<0.01		<0.01	<0.01	91.0		
1,2,4-TriCB	↓	↓	↓	↓		↓		↓		↓		↓		↓		↓		↓		↓	↓	87.3		
1,2,3-TriCB	↓	↓	↓	↓		↓		↓		↓		↓		↓		↓		↓		↓	↓	88.4		
1,2,3,5&1,2,4,5	↓	↓	↓	↓		↓		↓		↓		↓		↓		↓		↓		↓	↓	174		
1,2,3,4-TeCB	↓	↓	↓	↓		↓		↓		↓		↓		↓		↓		↓		↓	↓	83.7		
Penta-CB	↓	↓	↓	↓		↓		↓		↓		↓		↓		↓		↓		↓	↓	81.0		
Hexa-CB	↓	↓	↓	↓		↓		↓		↓		↓		↓		↓		↓		↓	↓	80.9		
PCB as 1260	<0.50 (J)	<1.0 (J)	<0.50 (J)	<0.10		<0.10		<0.10		<0.10		0.70		1.0		0.43		0.11		0.28	<0.10	78.4		
Surrogate TCMX	88.7	110	111	127		108		85.3		90.2		114		112		112		117		110	90.1	86.1		
DCBP	92.4	146	119	109		117		93.7		97.3		117		98.8		110		119		108	97.4	95.1		
	(circled) [illegible] LY TOX- [illegible]																							
	Raise limit 70 0.5	Also limit 70 1.0 (circled)	Raise limit 70 0.5 (circled)																					
INS Date	20	20	20	20		20		20		20		20		20		20		20		20	20	20		

J = Estimated
E = Exceeds calibration range

(circled) 2 large UI peaks one by ACB one by TCMX

Sample Tracking Form

Date: 20 Aug 00

Target Analyte	445 L 317	Aug 446 CS 318	446 L 319	Aug 447 OS 320	447 L 321	Blank #	LCS #	MS #	MSD #
1,3,5-TriCB		<0.01		<0.01					
1,2,4-TriCB									
1,2,3-TriCB									
1,2,3,5&1,2,4,5									
1,2,3,4-TeCB									
Penta-CB									
Hexa-CB									
PCB as 1260		0.12		0.18					
Surrogate TCMX		112		106					
DCBP		112		98.1					
Inst Date		20		20					

Sample Description: NO LCS/MS/MSD Blank

J = Estimated
E = Exceeds calibration range

OGDEN

Job Name: Crystal Springs
Job Number:
Title: Sonny Reeves backyard 405 Jackson
Computed by: Checked by:
Date: 8/16/2000 Sheet 1 Of 11

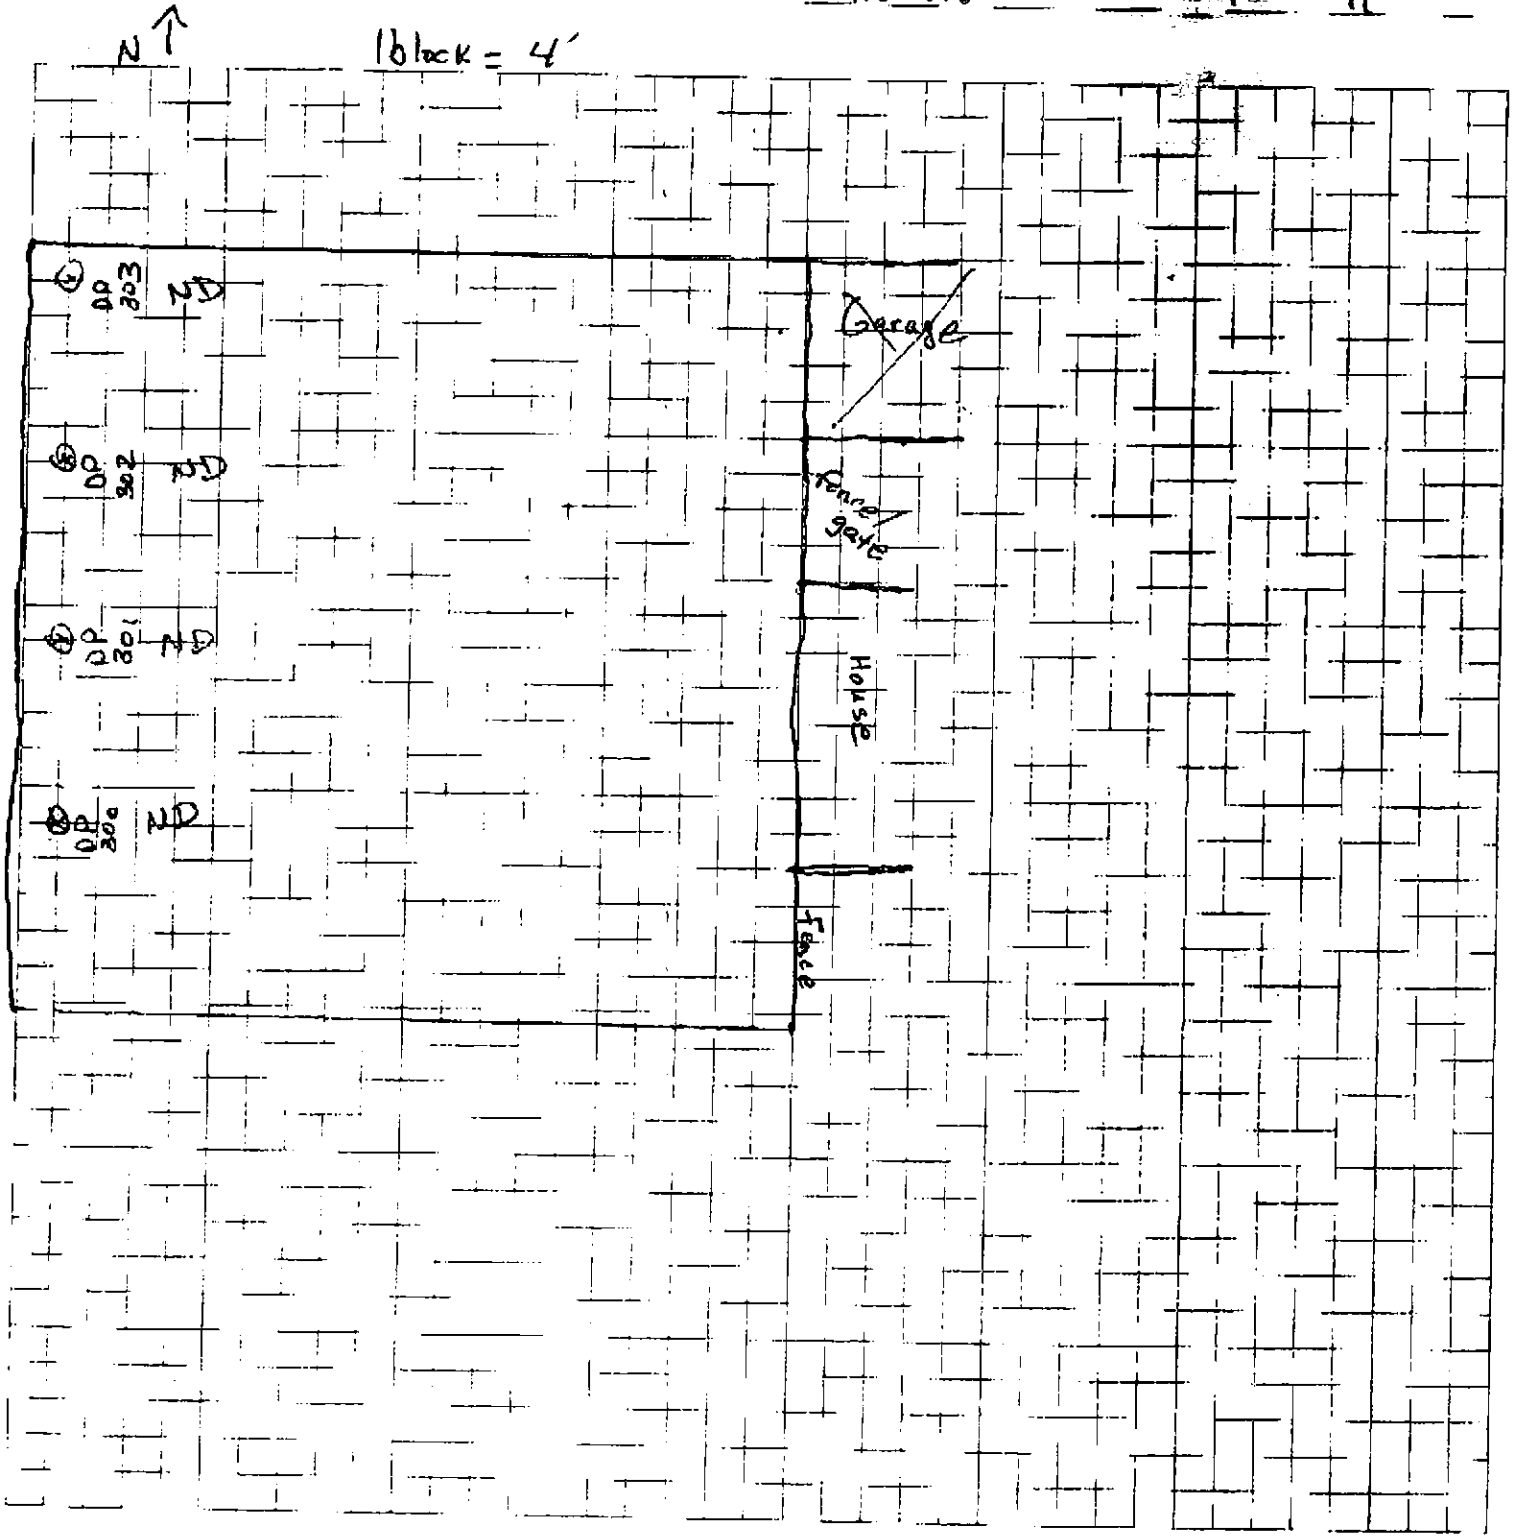

OGDEN

Job Name: Crystal Springs
Job Number:
Title: Stringer Funeral Home
Computed by: Checked by:
Date: 8-16-2000 Sheet: 2 Of: 11

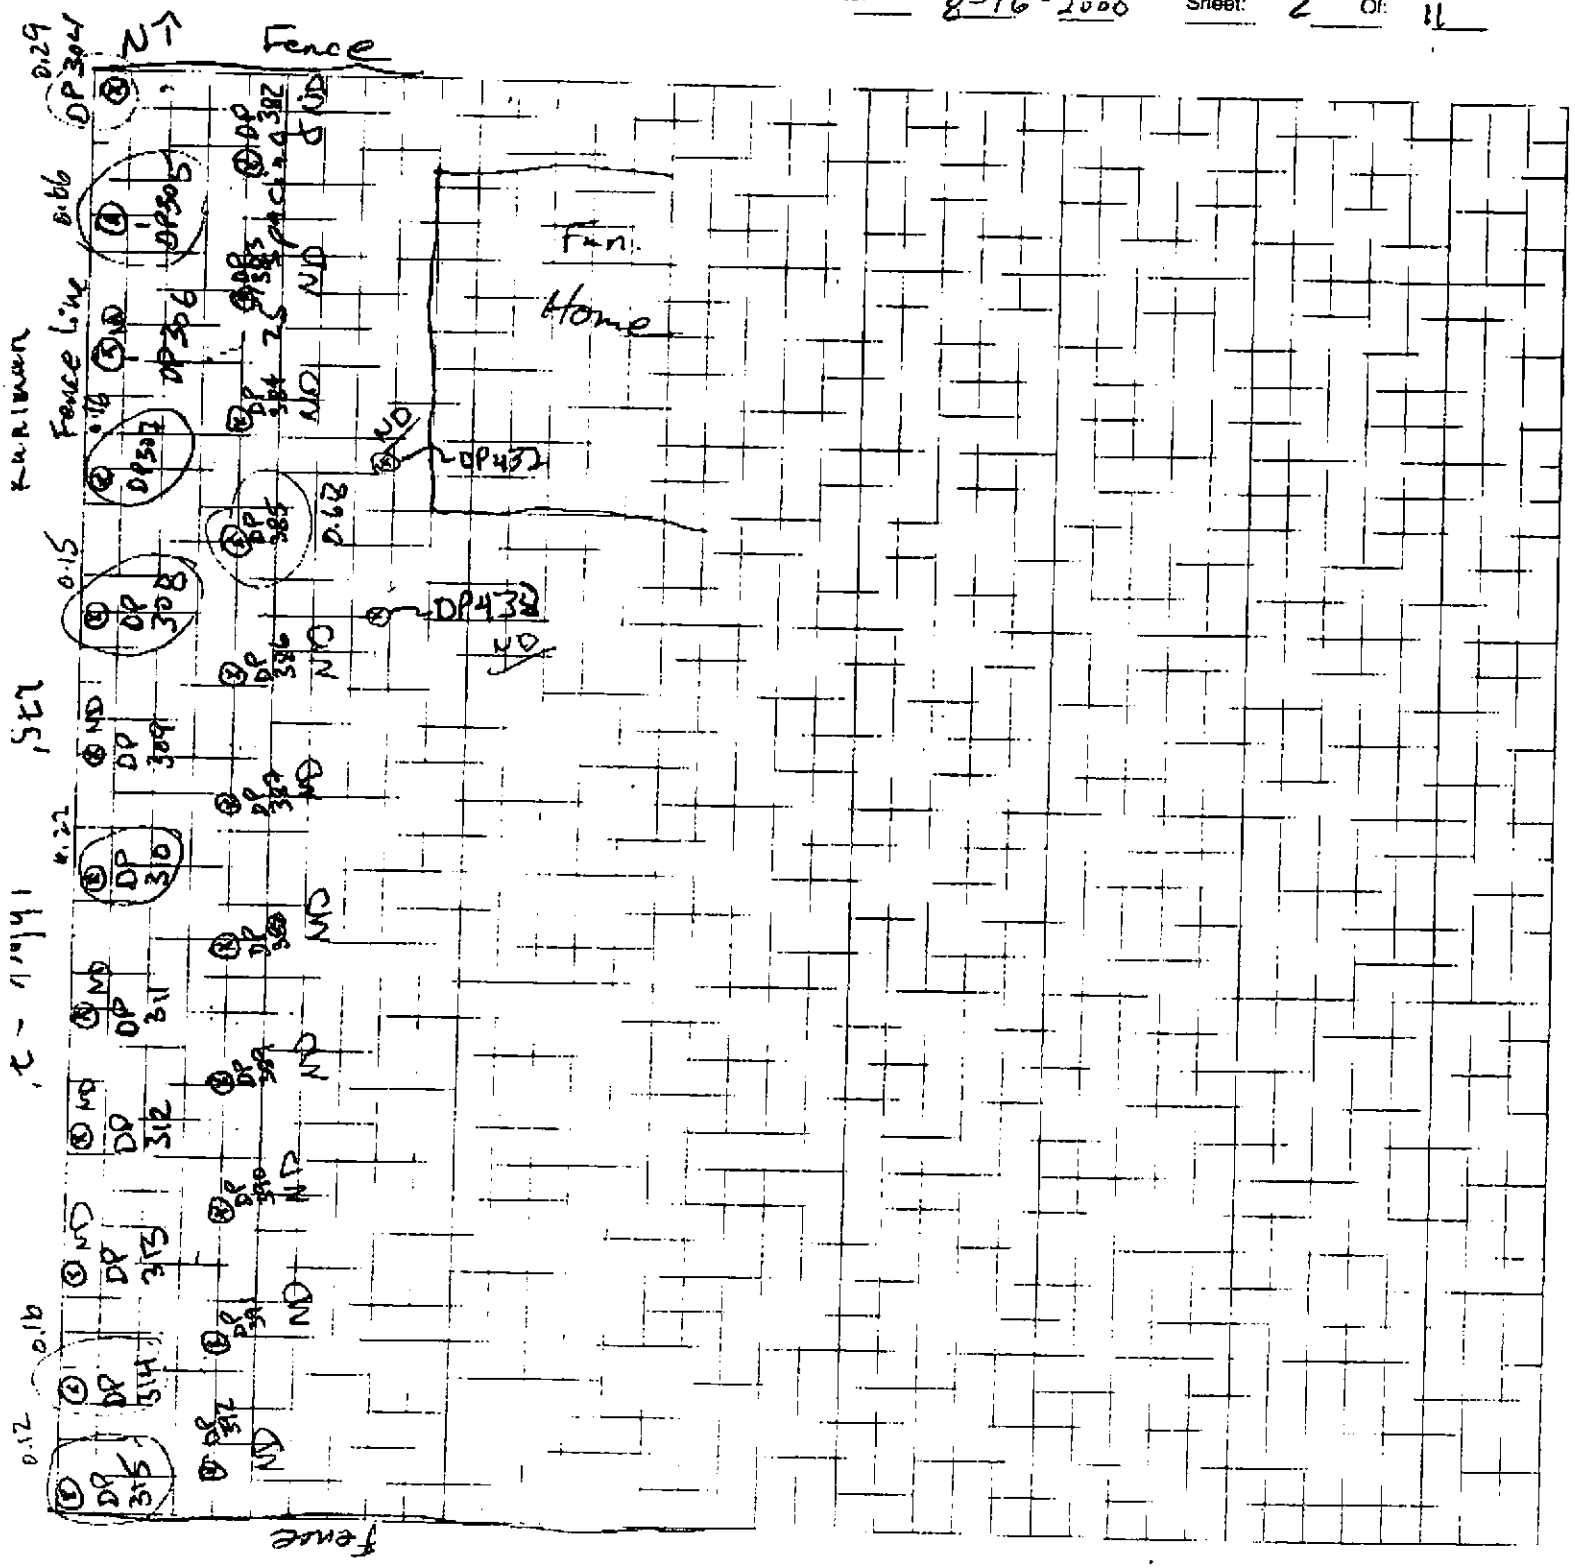

OGDEN

Job Name: Crystal Springs
Job Number:
Title: 401 N. Jackson & Elmer Wright
Computed by: Checked by:
Date: 8-16-2000 Sheet: 3 of: 11

1 block = 4'

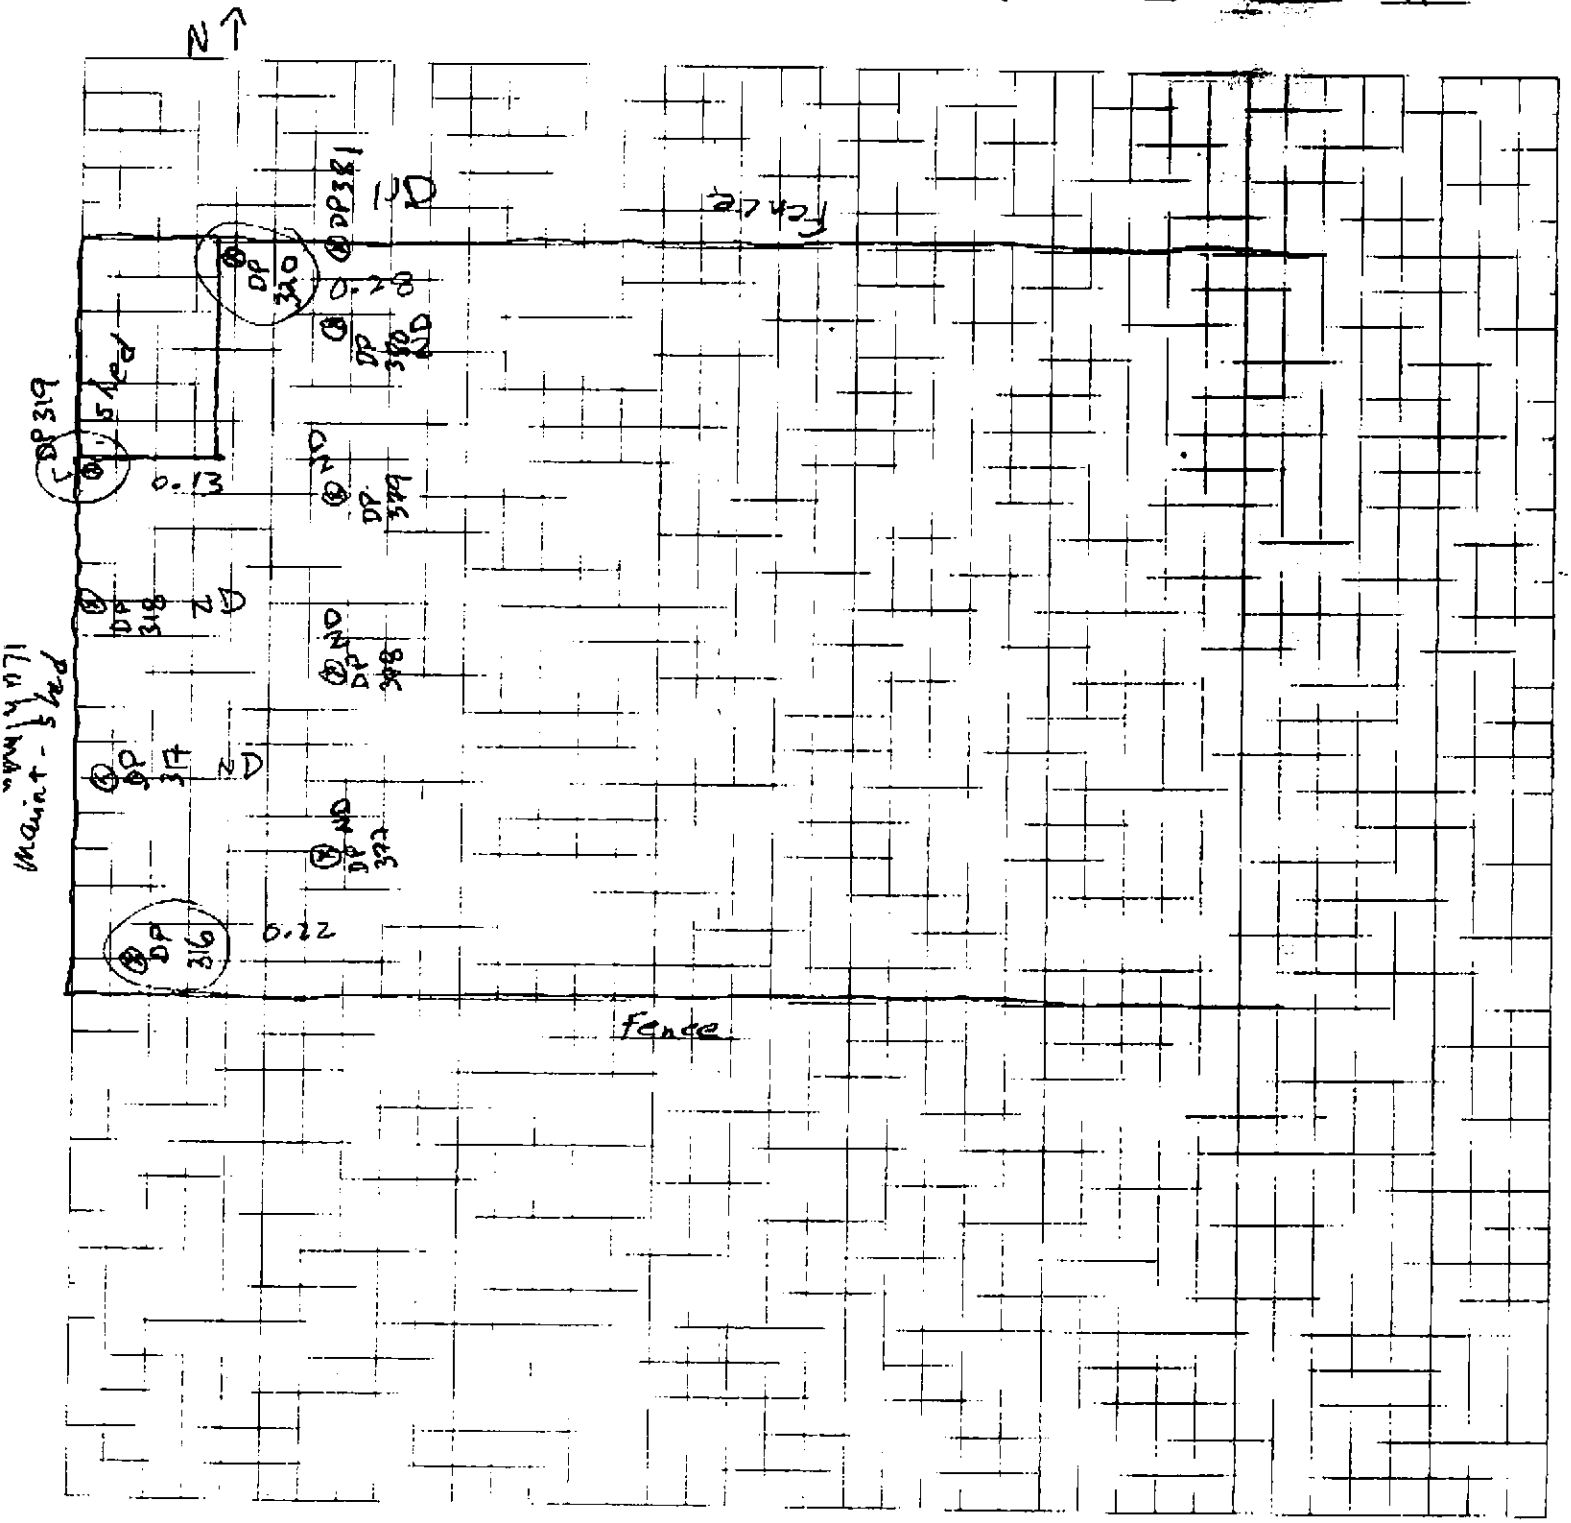

601 8926496

OGDEN

Job Name: Crystal Springs
Job Number:
Title: 407 N. Jackson Louise Lang
Computed by: Checked by:
Date: 8-16-00 Sheet: 4 Of: 11

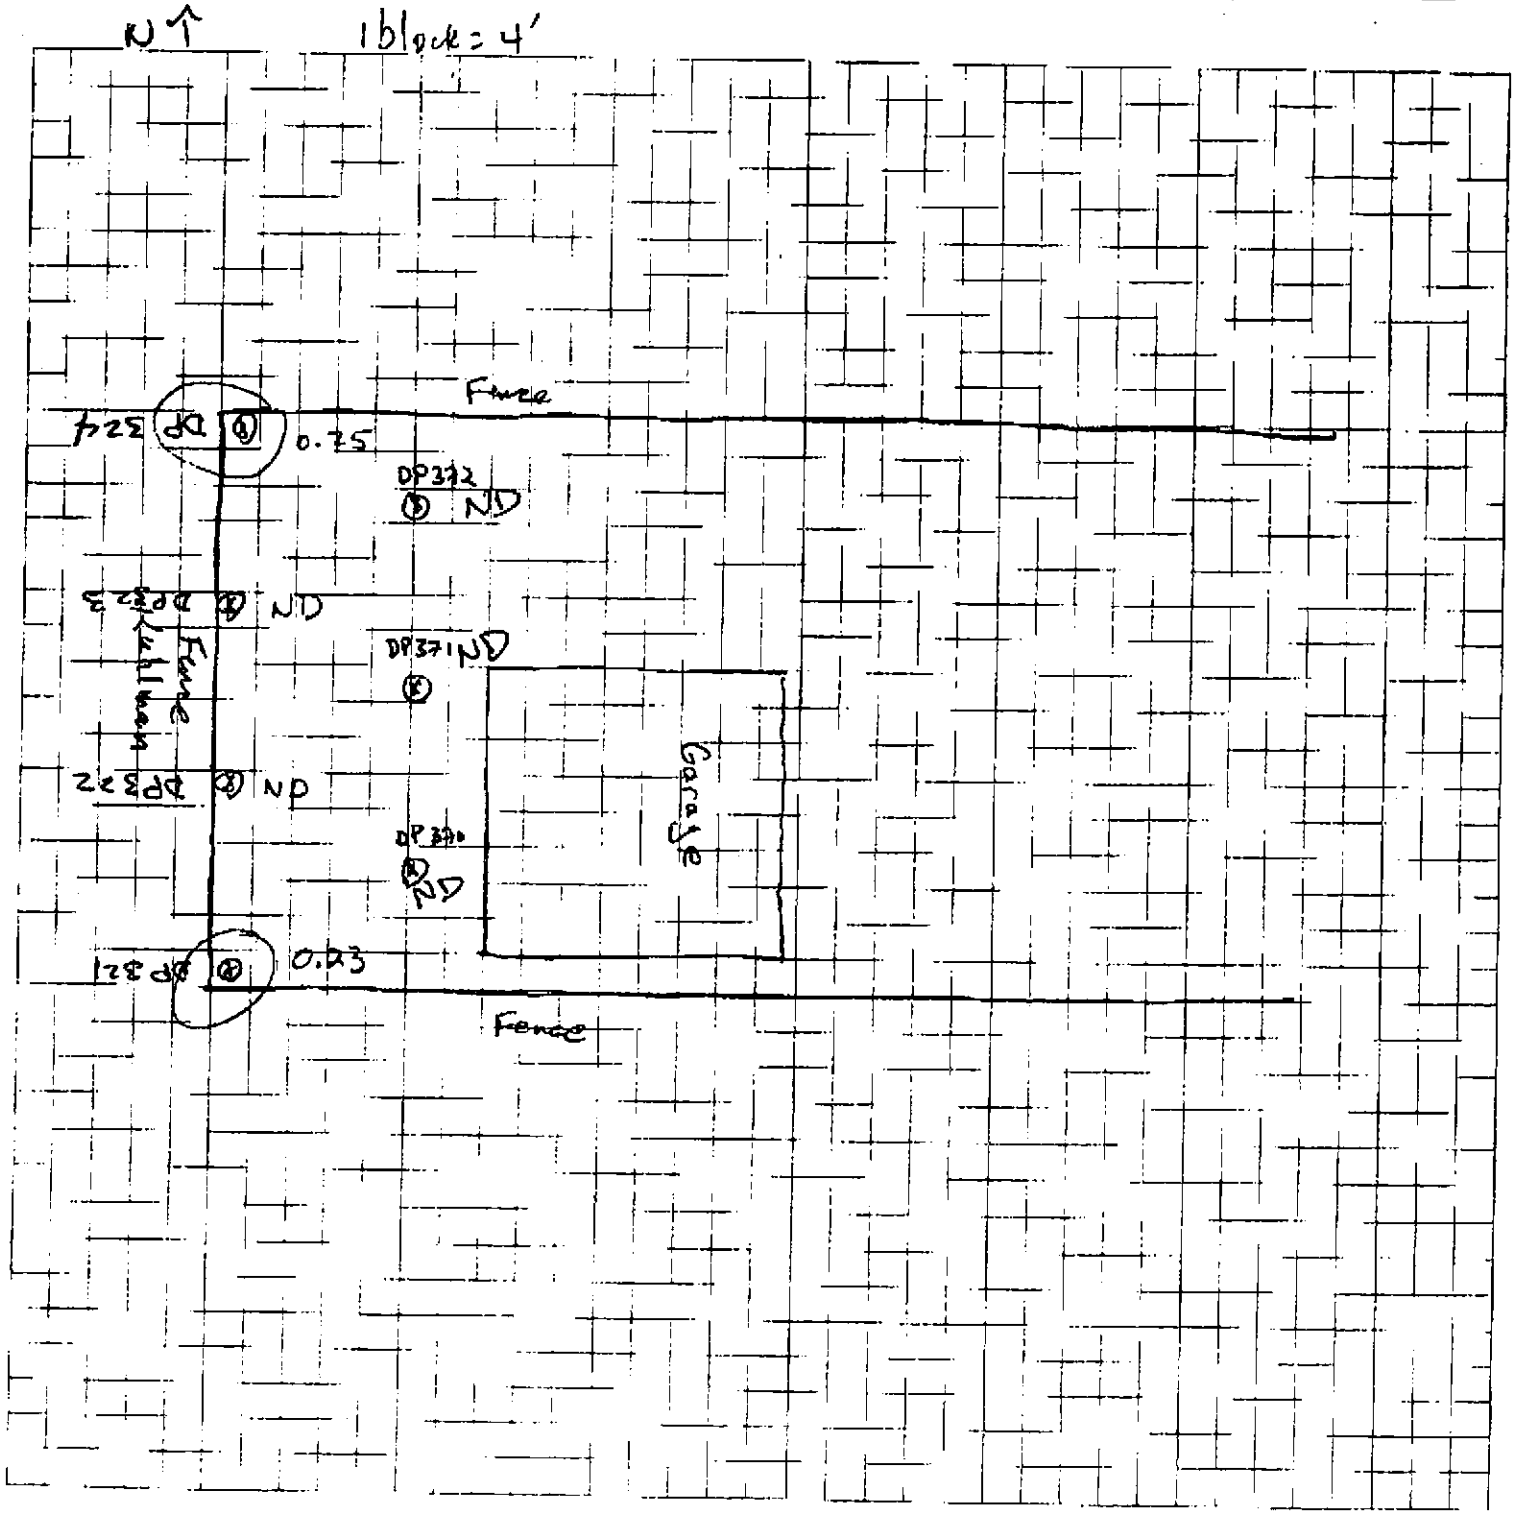

OGDEN

Job Name: Crystal Springs
Job Number:
Title: Lee St. Medical
Computed by: Checked by:
Date: 8/17/00 Sheet: 5 Of: 11

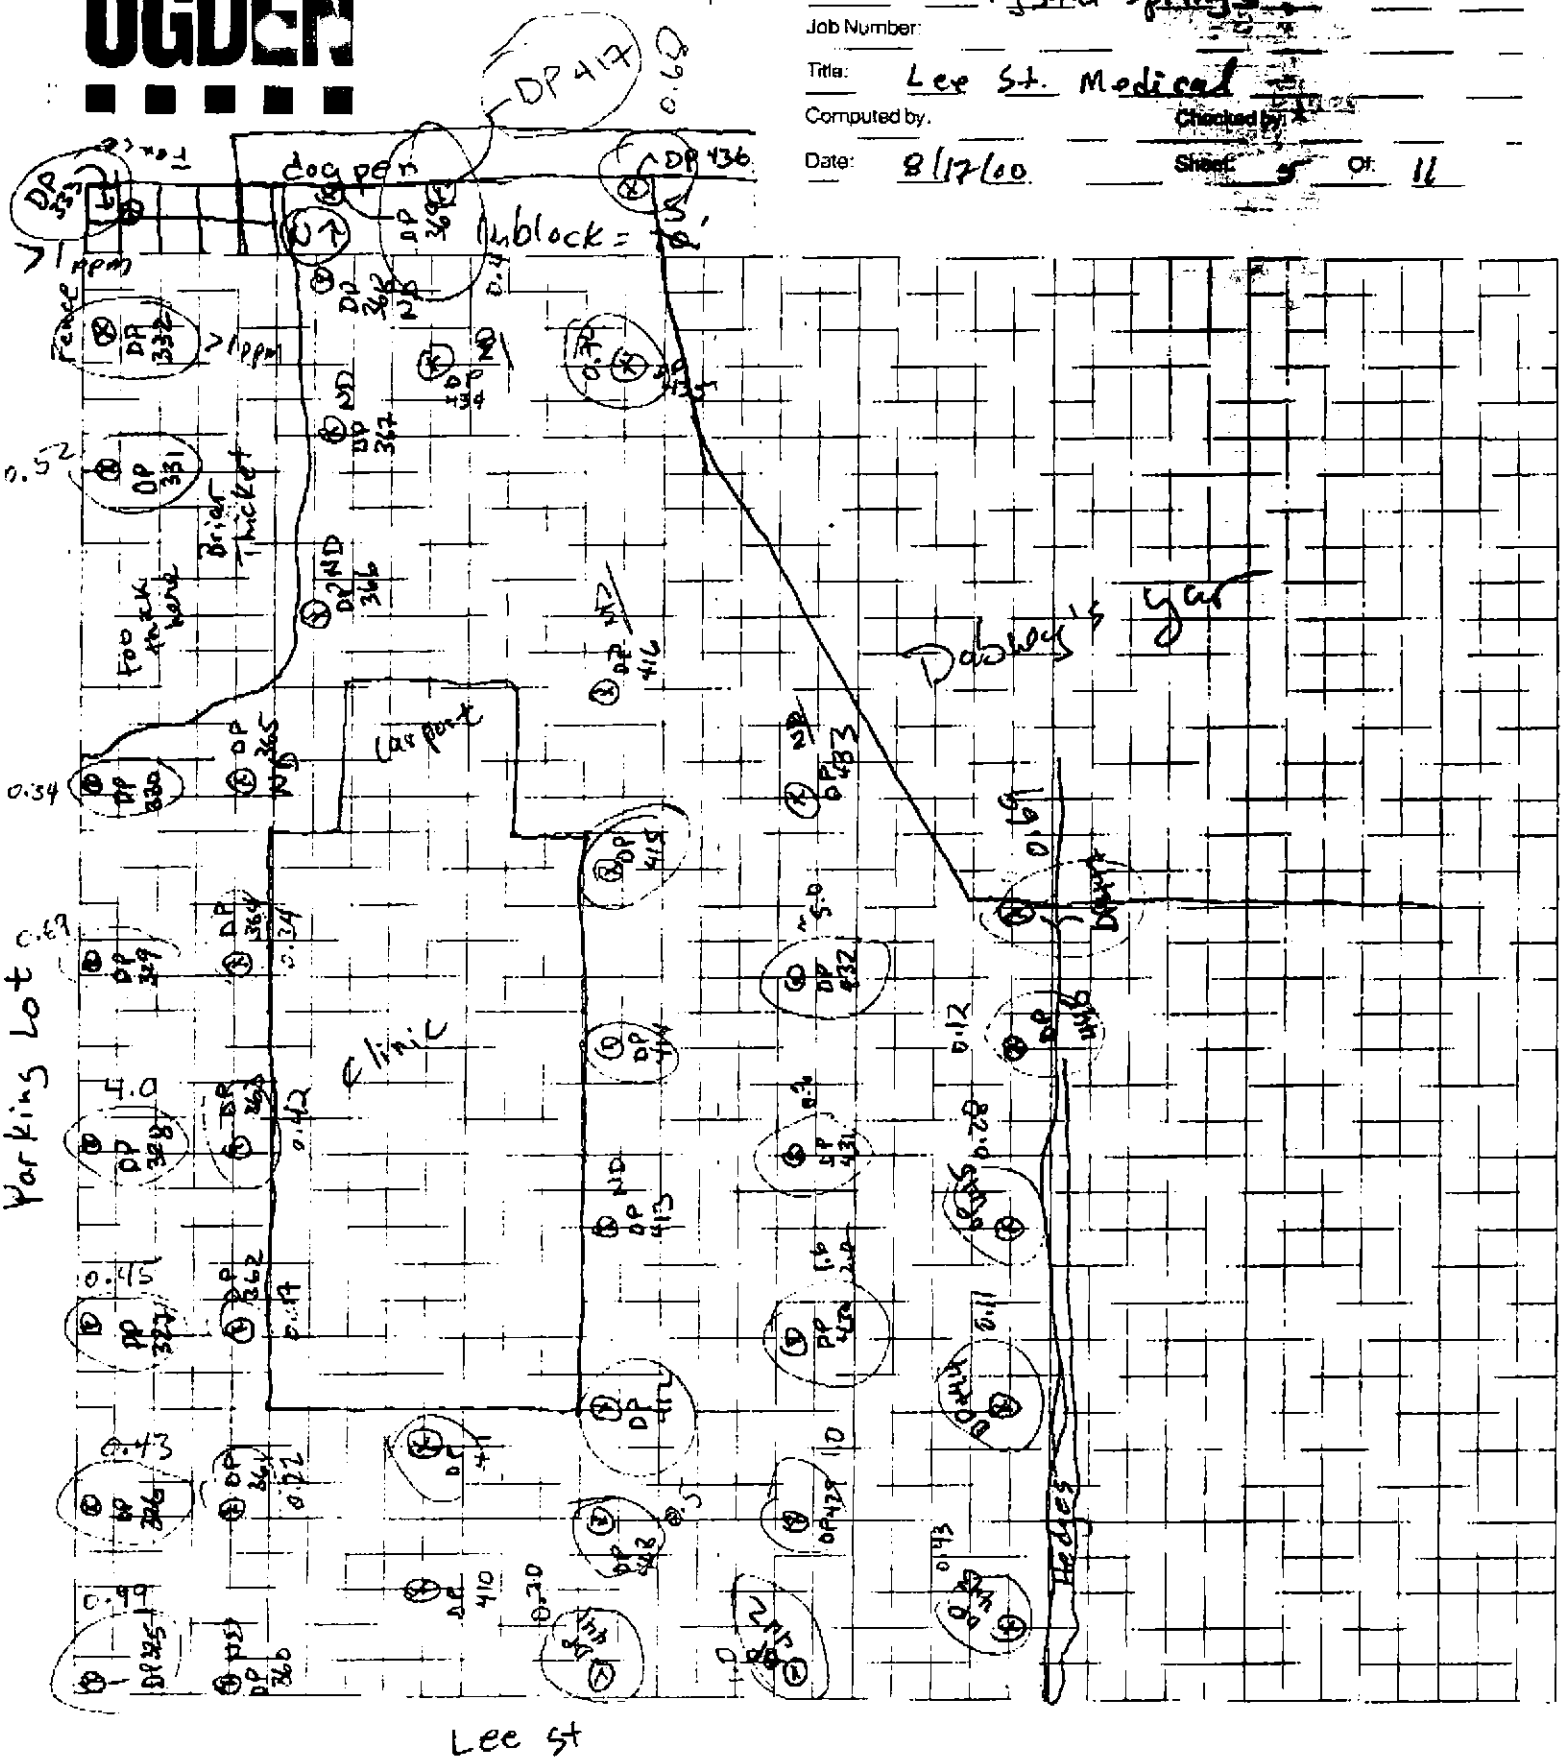

OGDEN

Job Name: Crystal Springs

Job Number:




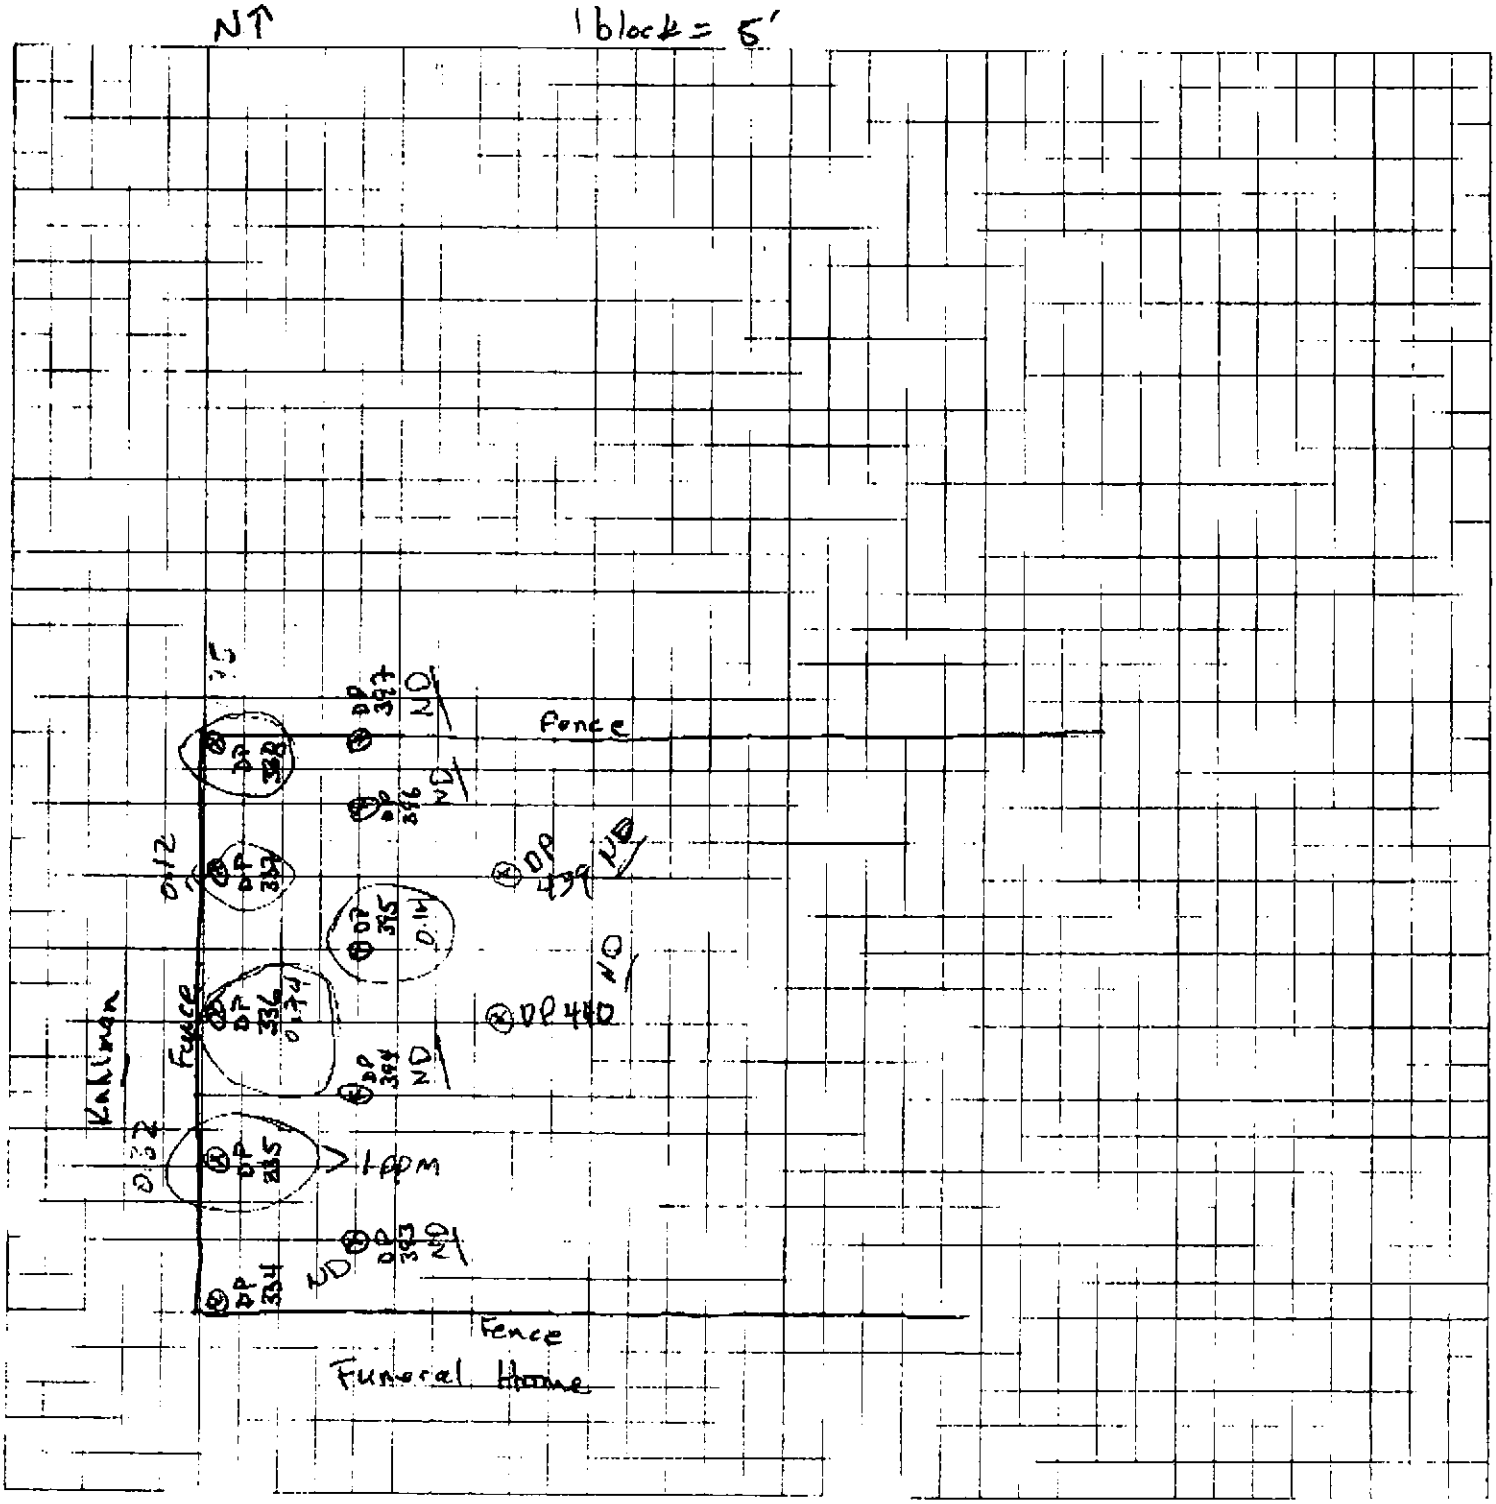

OGDEN

Job Name: Crystal Springs
Job Number:
Title: 219 N. Jackson - Perry Smith
Computed by: TJF
Checked by:
Date: 8-17-00
Sheet: 7 of: 11

1 block = 5'

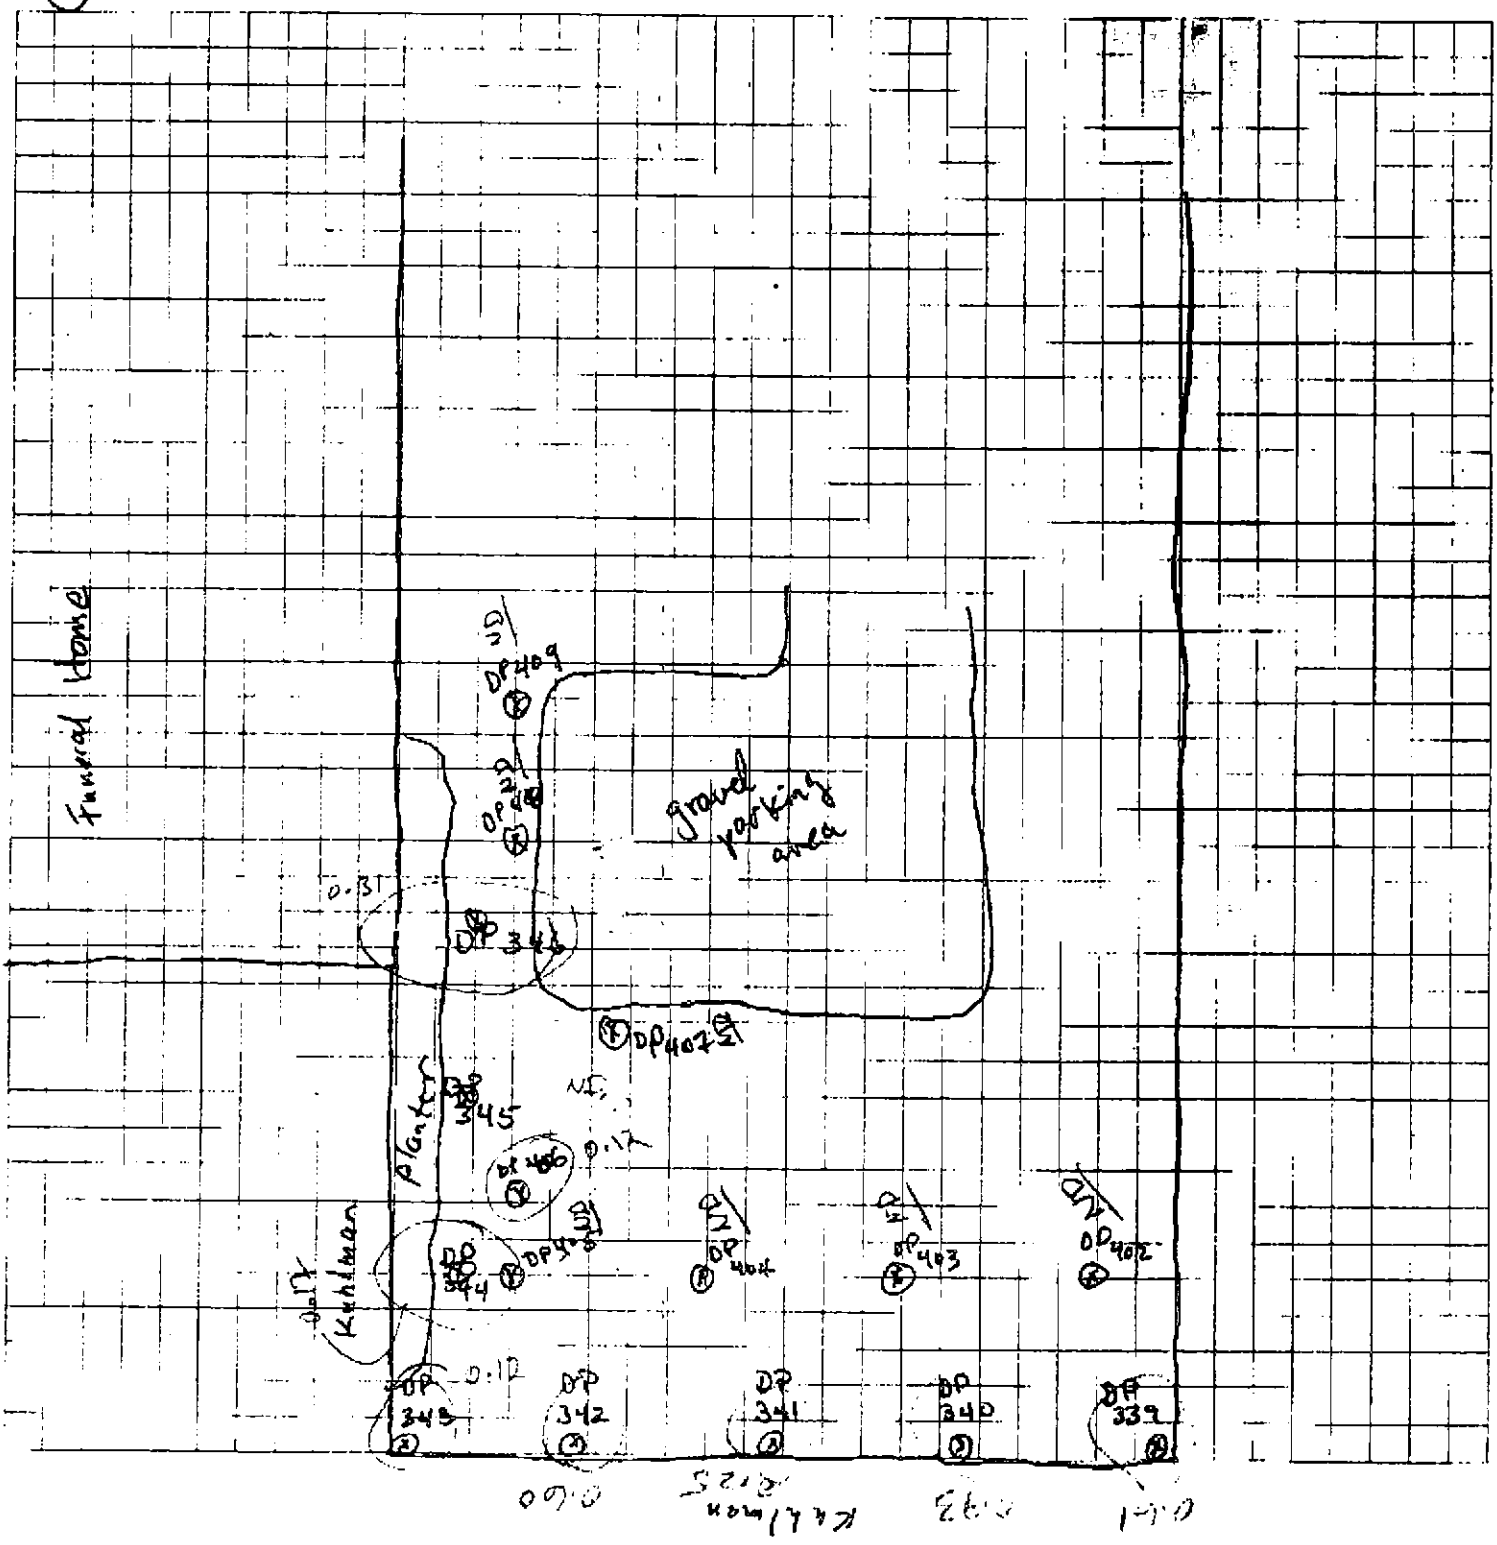

OGDEN

Job Name: Crystal Springs
Job Number:
Title: 409 N. Jackson (Anny Cooper)
Computed by: DF Checked by:
Date: 8-9-00 Sheet: 8 Of: 11

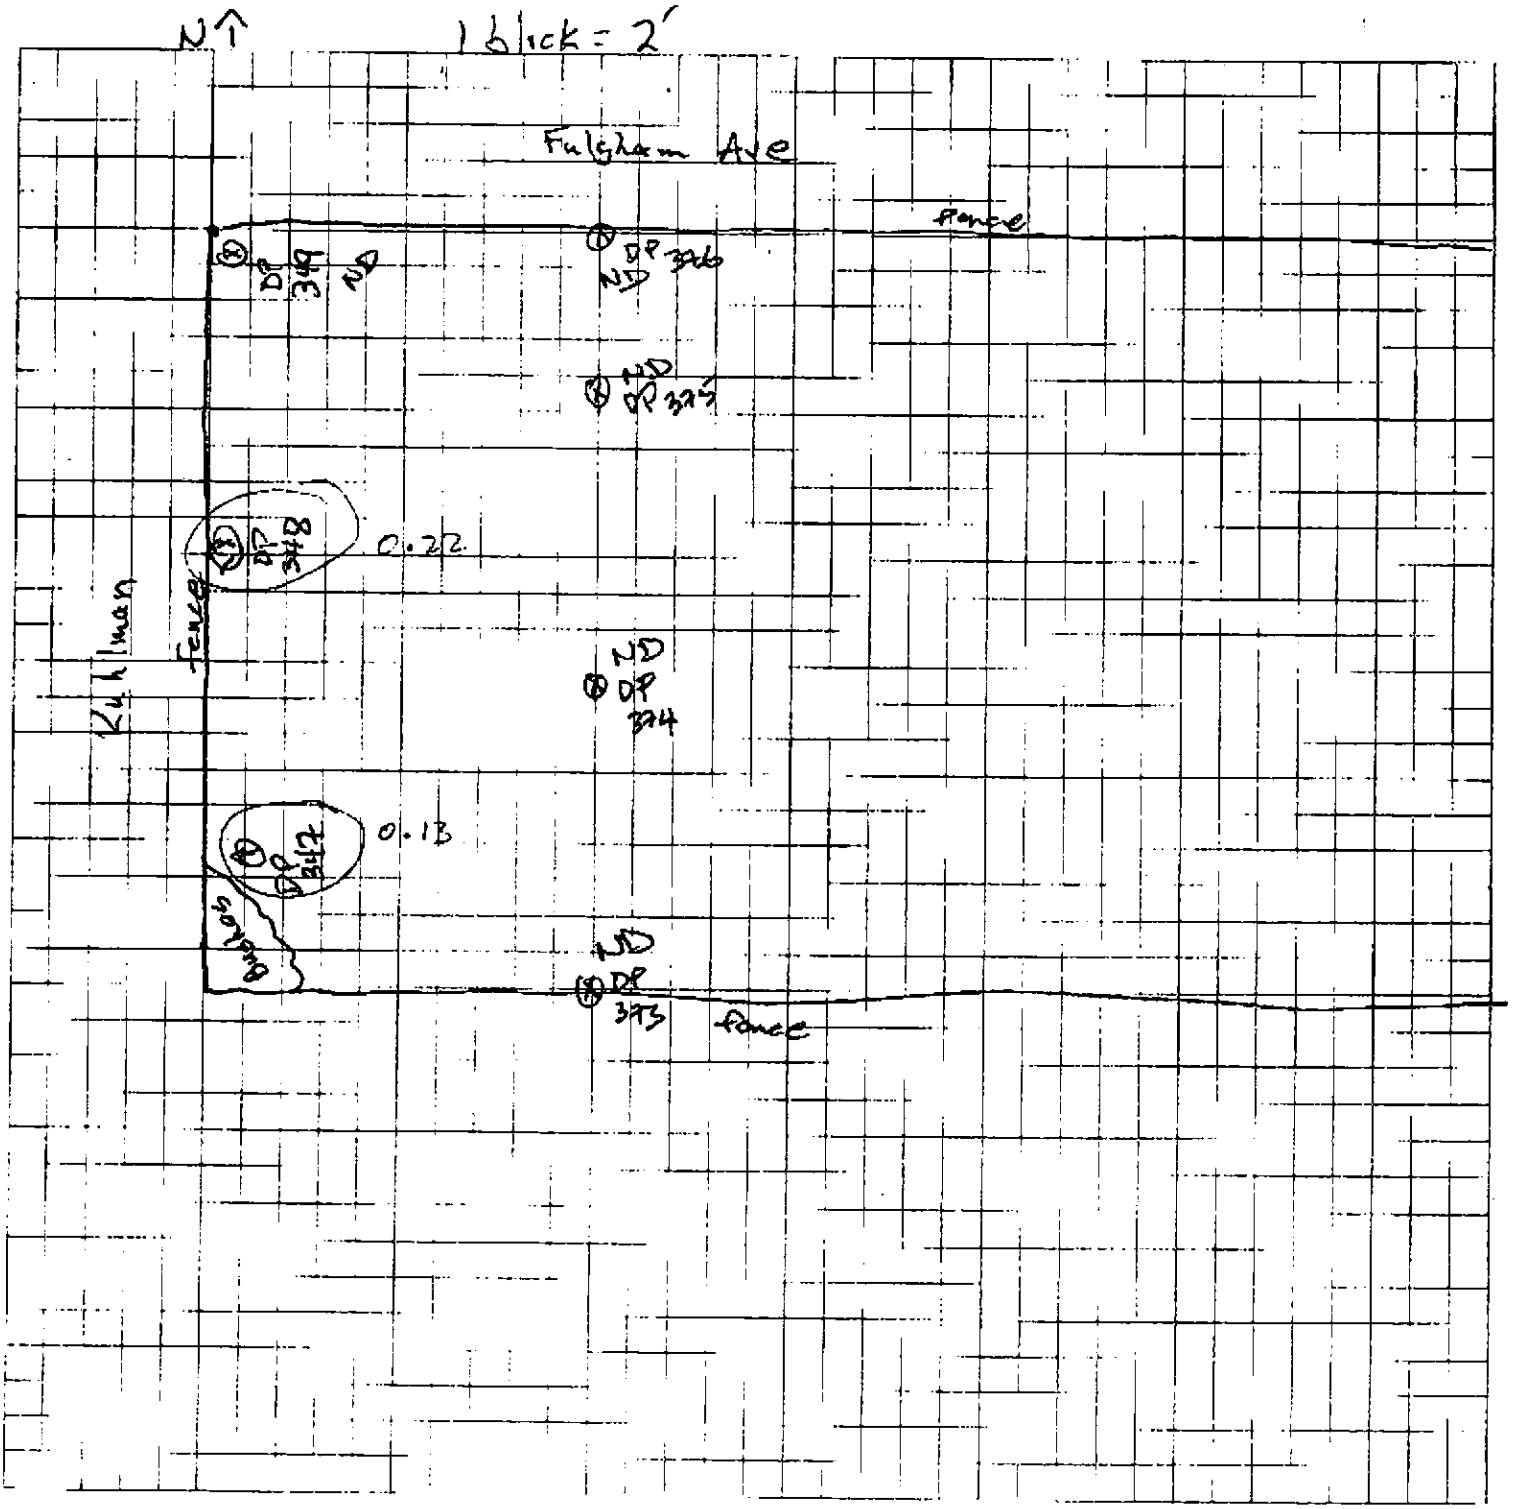

OGDEN

Job Name: Crystal Springs
Job Number:
Title: Dabney Home Plan
Computed by: TJE Checked by:
Date: 8-7-00 Sheet 9 Of 11

1 block = 5'

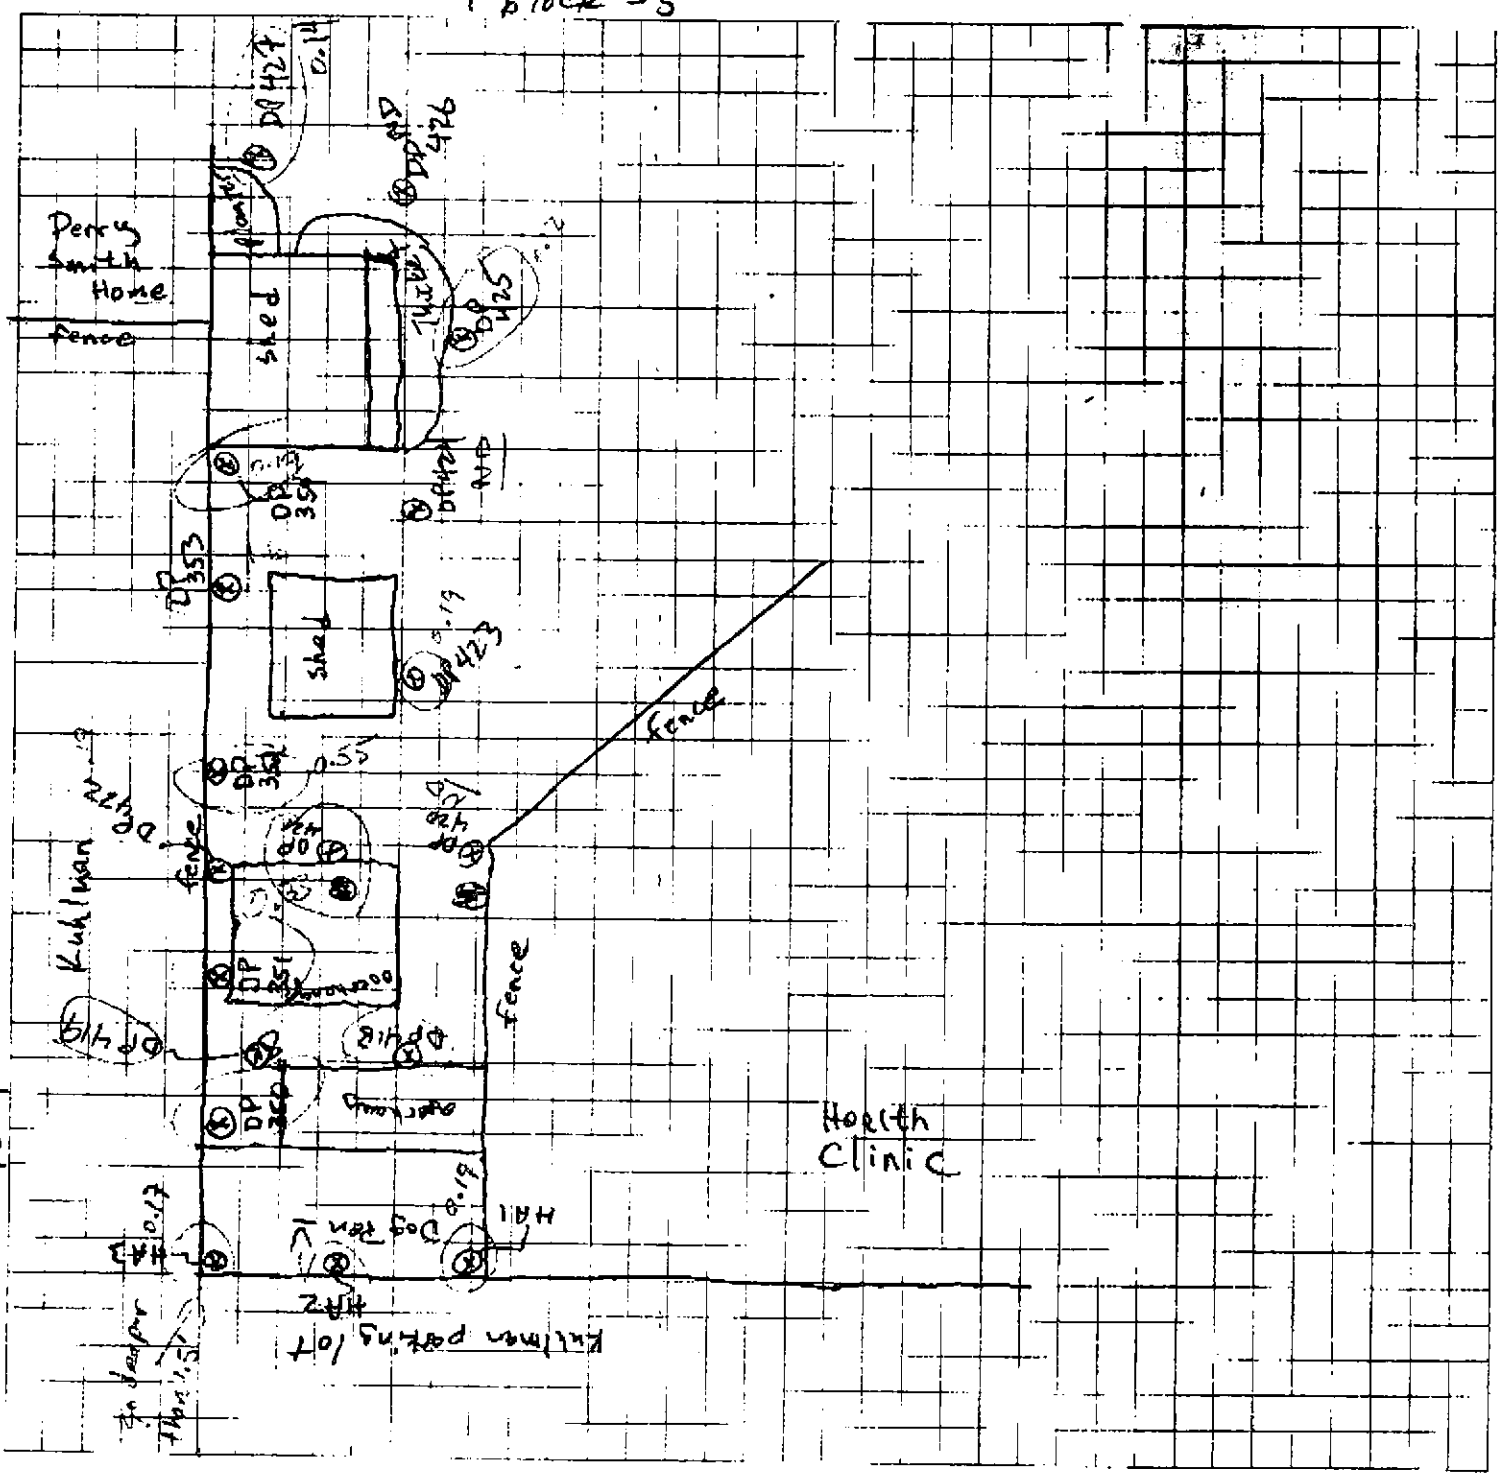

OGDEN

Job Name: Crystal Springs
Job Number:
Title: Wright House
Computed by: Checked by:
Date: 8-18-00 Sheet: 10 Of: 11

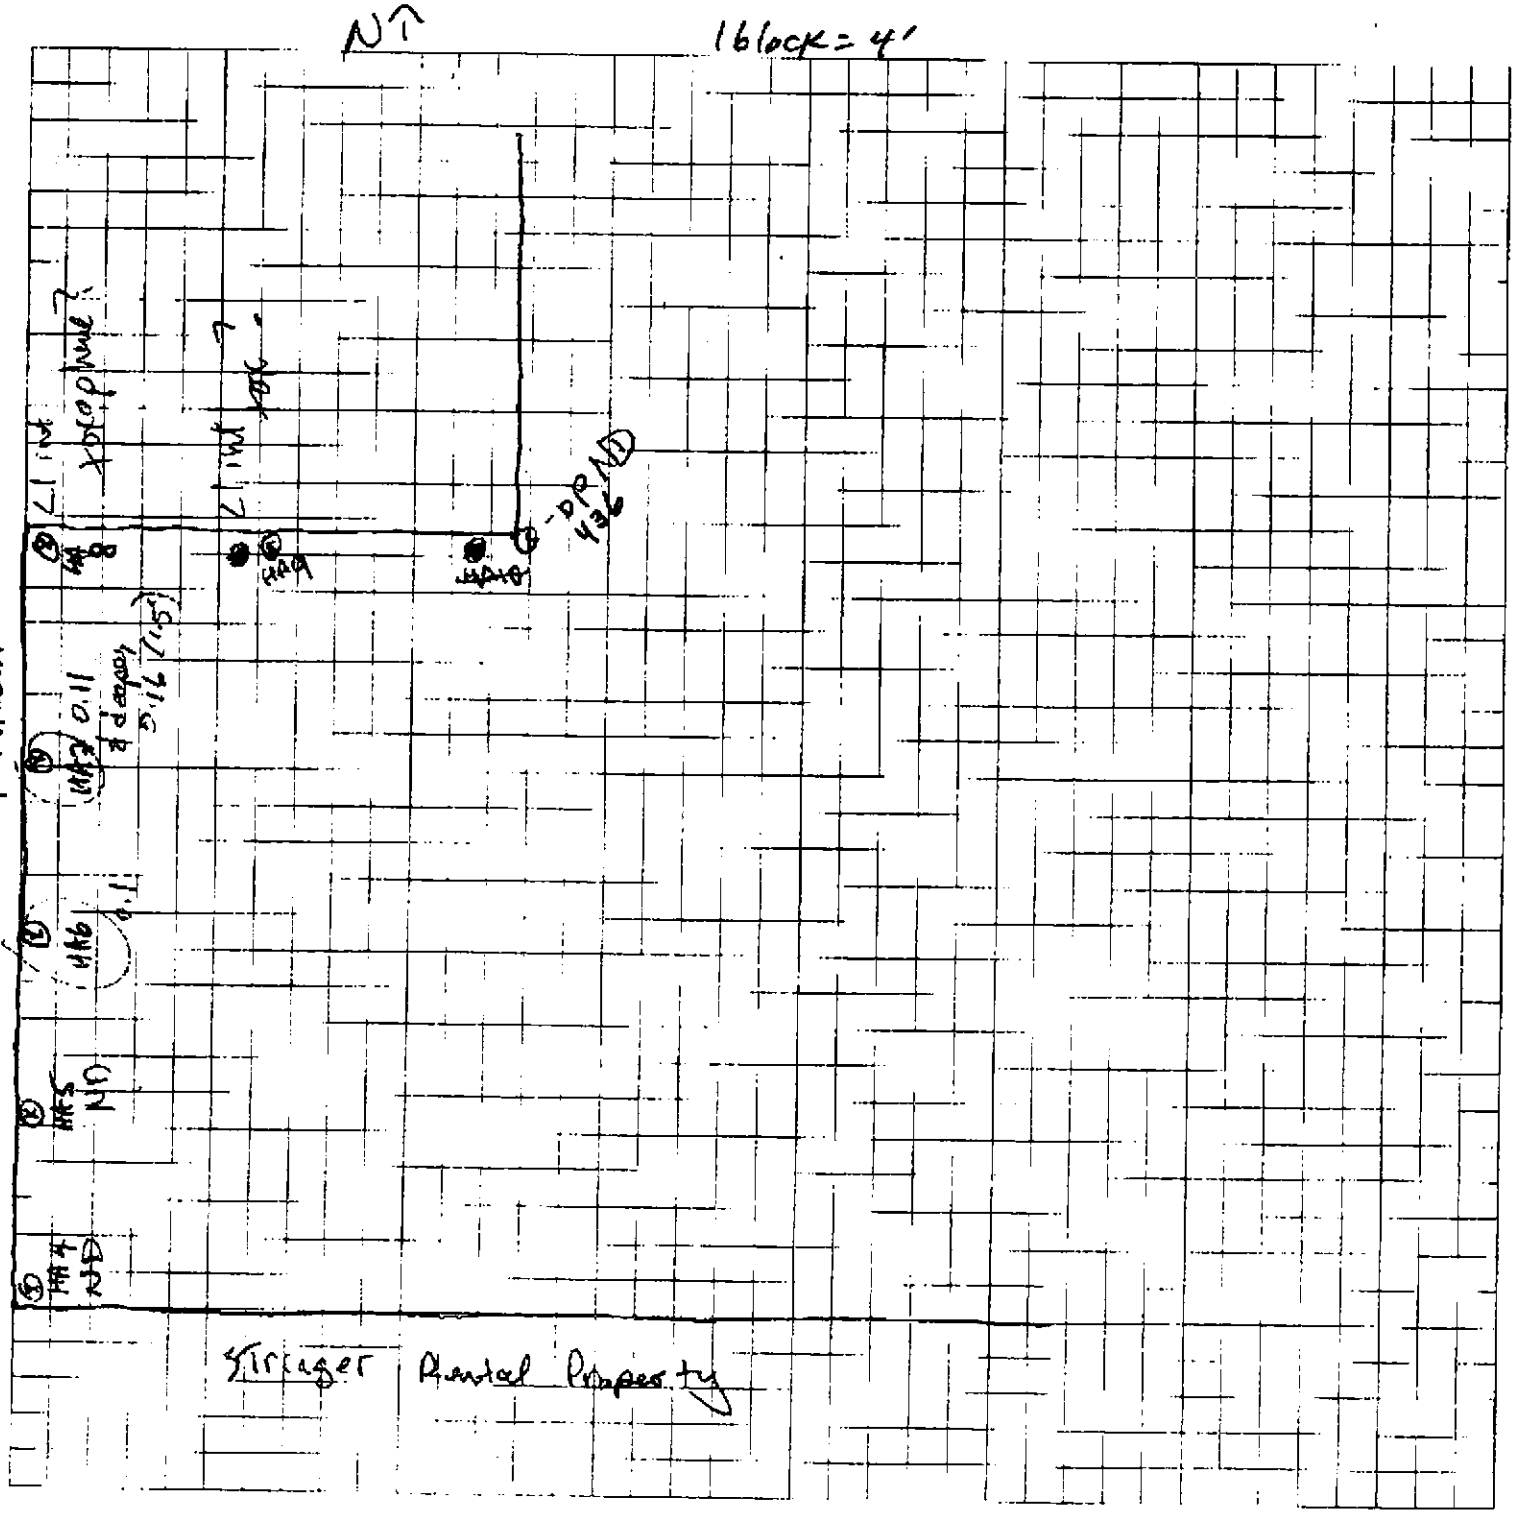

OGDEN

Job Name: Crystal Springs
Job Number:
Title: Harold & Suzanne Worten
Computed by: JDF
Checked by:
Date: 8-18-00
Sheet 1 Of 11

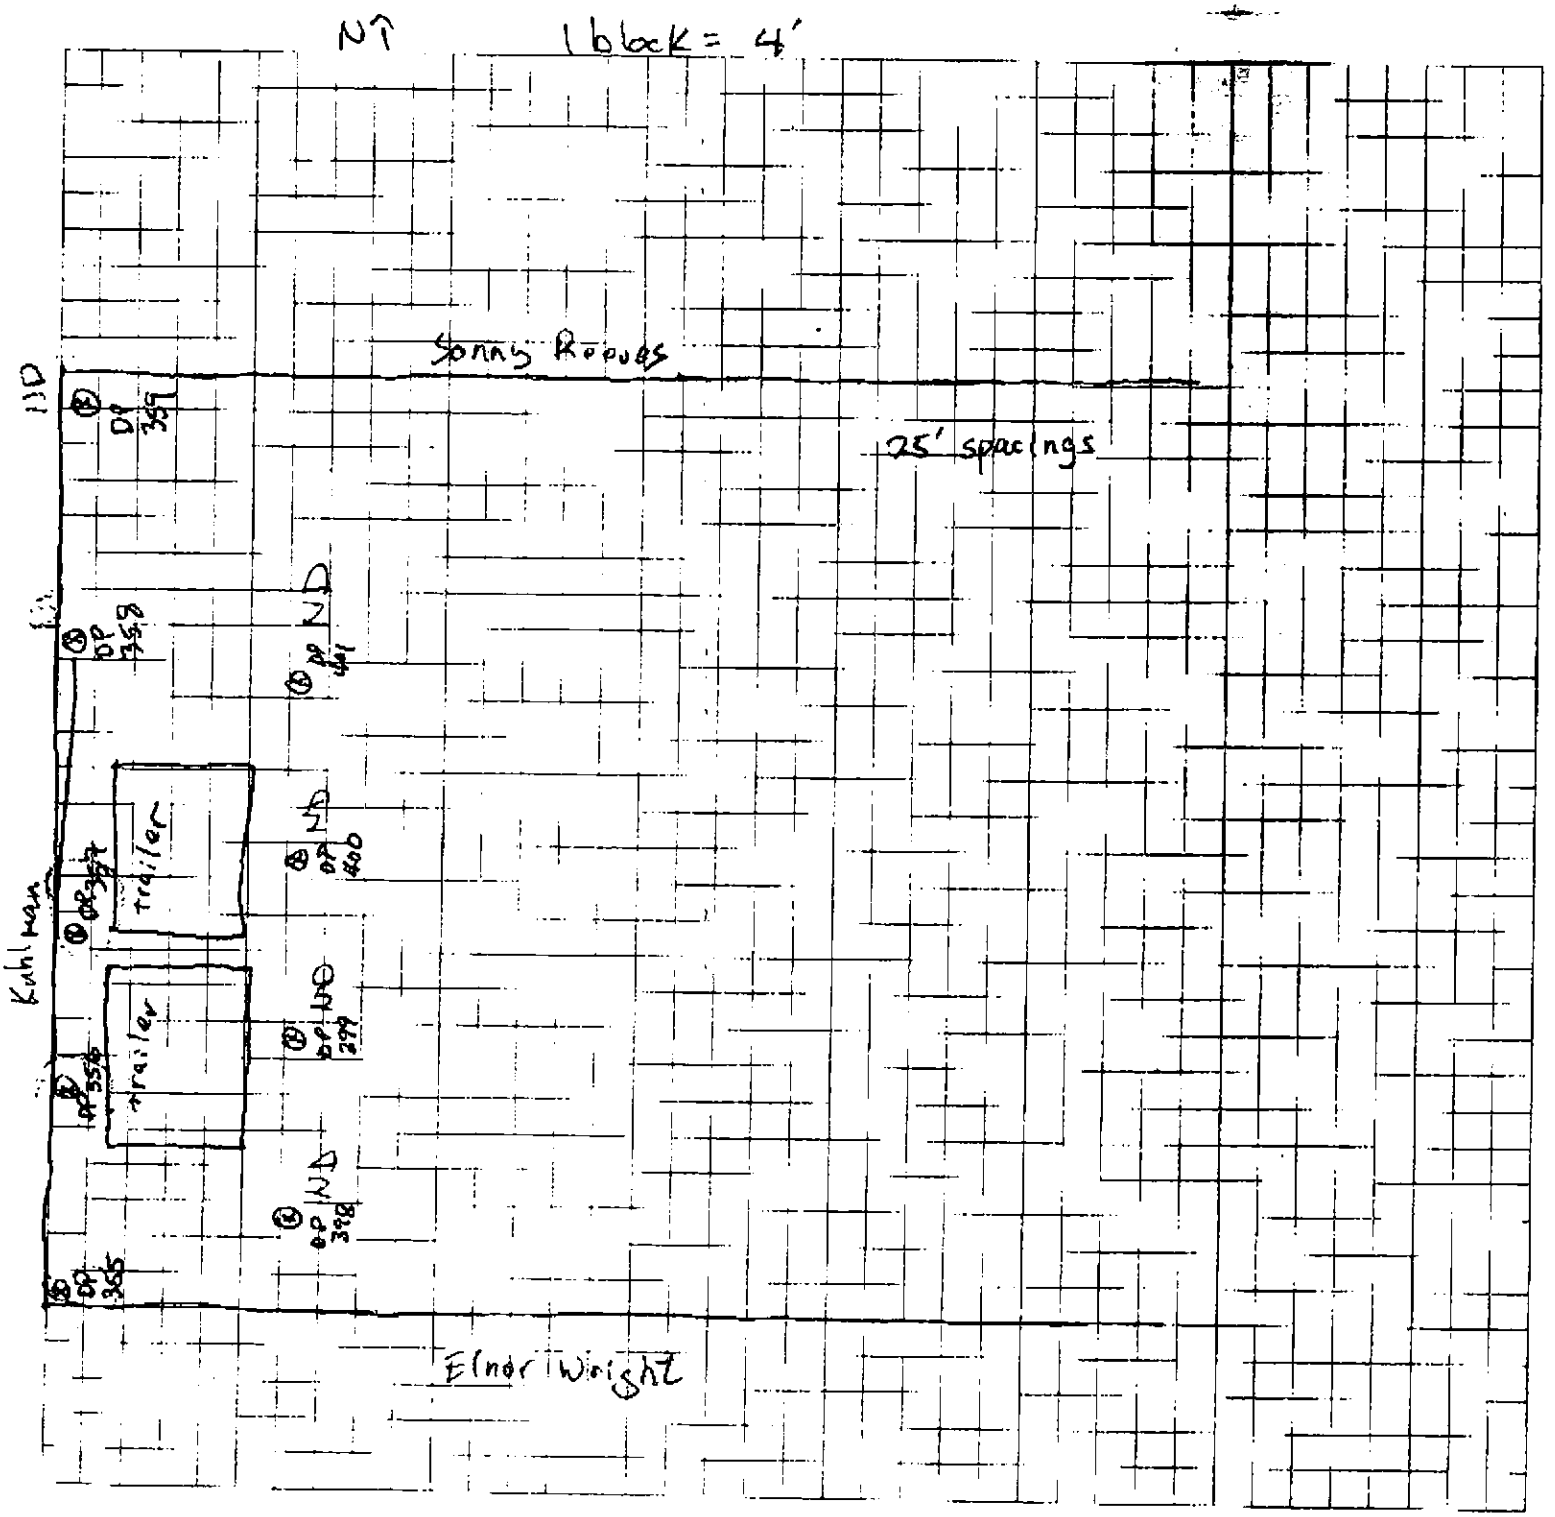

OGDEN

Job Name:
Job Number:
Title:
Computed by: Checked by:
Date: Sheet: Of:

FILE COPY

Fax Coversheet

To: Gretchin Zmitrovich
MDEQ

19 pages total

From: Tim Fitzpatrick
Ogden Environmental

Re: Crystal Springs Data Summary

Ms. Zmitrovich:

Following is all the data available as of 5:30 PM on Friday Aug 18. The mobile lab had autosampler malfunctions the previous two nights and are thus still somewhat behind. We will be working through the weekend and you can reach me on my cell at 704-236-3496 if you like.

Best Regards,

Tim Fitzpatrick

Sample Tracking Form

Date: 16 AUG 00

Target Analyte	Sample Description: DP300 0.5	DP300 4	DP301 0.5	DP301 4	DP302 0.5	DP302 4	DP303 0.5	DP303 40	DP304 0.5	DP304 4	DP305 0.5	DP305 4	DP306 0.5	DP306 4	DP307 0.5	DP307 4	DP308 0.5	DP308 4	DP309 0.5	DP309 4	Blank	LCS	8 MS	8 MSD
	4	5	6	7	8	9	10	11	12	13	14	15	16	17	18	19	20	21	22	23	#2	#2	#	#
1,3,5-TriCB	<0.01	<0.01	<0.01	<0.01	<0.01	<0.01	<0.01	<0.01	<0.01	<0.01	<0.01	<0.01	<0.01	<0.01	<0.01	<0.01	<0.01	<0.01	<0.01	<0.01	<0.01	99	145	146
1,2,4-TriCB																						99	141	142
1,2,3-TriCB																						99	140	141
1,2,3,5&1,2,4,5																						102	141	143
1,2,3,4-TeCB																						102	139	141
Penta-CB																						106	138	140
Hexa-CB	↓	↓	↓	↓	↓	↓	↓	↓	↓	↓	↓	↓	↓	↓	↓	↓	↓	↓	↓	↓	↓	107	135	136
PCB as 1260	<0.10	<0.10	<0.10	<0.10	<0.10	<0.10	<0.10	<0.10	0.29	<0.10	0.66	<0.10	<0.10	<0.10	0.16	<0.10	9.15	<0.10	<0.10	<0.10	<0.10	103	131	133
Surrogate TCMX	99.6	105	129	104	135	106	137	111	102	85.1	131	97.0	104	91.8	139	118	137	108	137	104	111	104	135	136
DCBP	89.5	100	96.9	101	125	115	130	109	87.9	83.9	129	99.4	101	95.0	140	116	133	107	132	103	111	107	130	130
						3																		
	TRACE 1260					ONES BUT TCMX					TWO OFFSCALE UP PEAKS AFTER HCB ONES LATER		TRACE 1260						TRACE 1260					

J = Estimated
E = Exceeds calibration range

1248?
1260

Sample Tracking Form

Date: Aug 14, 2000

Target Analyte	~~DP30~~ 0.5 24	DP30 4 25	DP31 0.5 26	311 4 27	312 0.5 28	312 4 29	313 0.5 30	313 4 31	314 0.5 32	314 4 33	315 0.5 34	315 4 35	316 0.5 36	316 4 37	317 0.5 38	317 4 39	318 0.5 40	318 4 41	319 0.5 42	319 4 43	~~Blank~~ #3	~~LCS~~ #3	MS #30	MSD #30
1,3,5-TriCB	<0.01	<0.01	<0.01	<0.01	<0.01	<0.01	<0.01	<0.01	<0.01	<0.01	<0.01	<0.01	<0.01	<0.01	<0.01	<0.01	<0.01	<0.01	<0.01	<0.01	<0.01	97.4	100	104
1,2,4-TriCB																						98.0	101	105
1,2,3-TriCB																						97.0	100	105
1,2,3,5&1,2,4,5																						99.5	103	107
1,2,3,4-TeCB																						99.4	103	107
Penta-CB																						101	106	108
Hexa-CB	↓	↓	↓	↓	↓	↓	↓	↓	↓	↓	↓	↓	↓	↓	↓	↓	↓	↓	↓	↓	↓	103	108	109
PCB as 1260	0.22	<0.10	<0.10	<0.10	<0.10	<0.10	<0.10	<0.10	0.16	<0.10	~~0.33~~ 0.12	<0.10	0.22	<0.10	<0.10	<0.10	<0.10	<0.10	0.13	<0.10	<0.10	100	112	107
Surrogate recov	101	83.8	96	74	111	93	110	107	112	99	134	107	127	98.0	107	103	109	102	106	112	104	100	103	107
DCBP	115	102	91	79	103	106	109	114	112	105	128	112	129	101	106	102	106	111	108	120	112	107	109	107
			TRACE 1260		TRACE 1260										TRACE 1248 or 1254		TRACE 1260							

J = Estimated
E = Exceeds calibration range

Sample Tracking Form

Date: 16 AUG 2000

Target Analyte	Sample Description: ACID 320 0.5 (#44)	ACID 320 4 (#45)	ACID 321 0.5 (#46)	321 2 (#47)	321 4 (#48)	322 0.5 (#49)	322 4 (#50)	323 0.5 (#51)	323 4 (#52)	324 0.5 (#53)	324 4 (#54)	Blank #4	LCS #4	MS #44	MSD #44
1,3,5-TriCB	<0.01	<0.01	<0.01	<0.01	<0.01	<0.01	<0.01	<0.01	<0.01	<0.01	<0.01	<0.01	104	150	147
1,2,4-TriCB													104	147	145
1,2,3-TriCB													104	145	143
1,2,3,5&1,2,4,5													103	147	145
1,2,3,4-TeCB													104	143	141
Penta-CB													105	143	141
Hexa-CB													102	140	138
PCB as 1260	0.28	<0.10	0.13	<0.10	<0.10	<0.10	<0.10	<0.10	<0.10	0.25	<0.10	<0.10	102	161	137
Surrogate TCMX	141	112	134	107	93.7	103	105	106	104	99.6	107	111	101	139	133
DBP	155	117	137	111	105	110	116	109	113	104	107	122	109	147	149
			OC PEAK BY MANUAL					TRACE 1260							

J = Estimated
E = Exceeds calibration range

Sample Tracking Form

plate 1-2 | plate 1-5

Date: August 17, 2000

Target Analyte	Sample Description: ACID 325 0.5 55	ACID 325 4 56	ACID 326 0.5 57	ACID 326 4 58	ACID 327 0.5 59	ACID 327 4 60	ACID 328 0.5 61	ACID 328 4 62	ACID 329 0.5 63	ACID 329 4 64	ACID 330 0.5 65	ACID 330 4 66	ACID 331 0.5 67	ACID 331 4 68	ACID 332 0.5 69	ACID 332 4 70	ACID 333 0.5 71	ACID 333 4 72	ACID 334 0.5 73	ACID 334 4 74	Blank #5	LCS #5	MS #61	MSD #61
1,3,5-TriCB	<0.01	<0.01	<0.01	<0.01	<0.01	<0.01	<0.01	<0.01	<0.01	<0.01	<0.01	<0.01	<0.01	<0.01	<0.01	<0.01	<0.01	<0.01	<0.01	<0.01	<0.01	99.8	149	152
1,2,4-TriCB	↓	↓	↓	↓	↓	↓	↓	↓	↓	↓	↓	↓	↓	↓	↓	↓	↓	↓	↓	↓	↓	89.4	149	150
1,2,3-TriCB	↓	↓	↓	↓	↓	↓	↓	↓	↓	↓	↓	↓	↓	↓	↓	↓	↓	↓	↓	↓	↓	98.4	147	148
1,2,3,5&1,2,4,5	↓	↓	↓	↓	↓	↓	↓	↓	↓	↓	↓	↓	↓	↓	↓	↓	↓	↓	↓	↓	↓	98.4	149	150
1,2,3,4-TeCB	↓	↓	↓	↓	↓	↓	↓	↓	↓	↓	↓	↓	↓	↓	↓	↓	↓	↓	↓	↓	↓	97.0	148	148
Penta-CB	↓	↓	↓	↓	↓	↓	↓	↓	↓	↓	↓	↓	↓	↓	↓	↓	↓	↓	↓	↓	↓	98.4	147	147
Hexa-CB	↓	↓	↓	↓	↓	↓	↓	↓	↓	↓	↓	↓	↓	↓	↓	↓	↓	↓	↓	↓	↓	96.8	141	141
PCB as 1260	0.99	<0.10	0.43	<0.10	0.45	<0.10	4.0	<0.10	0.69	<0.10	0.34	<0.10	0.52	<0.10		<0.10		<0.10	<0.10	<0.10	<0.10	108	120	122
Surrogate TCMX	143	103	108	104	109	109	145	104	103	108	107	107	132	104	133	100	137	103	104	105	103	97.4	147	143
DCBP	132	103	107	117	113	115	156	107	103	110	105	110	134	110	140	108	127	113	110	114	116	128	152	137
					07																			
		TRACE			Peak						07					TRACE			1260					
		1260			AT						PEAK					1260								
					2.789						AT													
											2.782													
INI. Data																				18	18	18		

J = Est 1

 

Page 2 of 2

Sample Tracking Form

Date: August 11, 2000

Target Analyte	Sample Description																							
	ACD						ACD	ACD					ACD	ACD									ACD	ACD
	335 0.5 75	335 4 76	336 ~~0.5~~ 4 78 ~~77~~	336 ~~4~~ 0.5 77 ~~78~~	337 0.5 79	337 4 80	338 0.5 81	338 4 82	339 0.5 83	339 4 84	340 0.5 85	340 4 86	341 0.5 87	341 4 88	342 0.5 89	342 4 90	343 0.5 91	343 4 92	344 0.5 93	344 4 94	Blank # 10	LCS # 10	1-20 DL MS # 35	MSD # 35
1,3,5-TriCB	<0.01	<0.01	<0.01	<0.01	<0.01	<0.01	<0.01	<0.01									<0.01	<0.01	<0.01	<0.01	<0.01	97.6	148	146
1,2,4-TriCB	↓	↓	↓	↓	↓	↓	↓	↓									↓	↓	↓	↓	↓	98.6	146	145
1,2,3-TriCB	↓	↓	↓	↓	↓	↓	↓	↓									↓	↓	↓	↓	↓	98.2	144	143
1,2,3,5&1,2,4,5	↓	↓	↓	↓	↓	↓	↓	↓									↓	↓	↓	↓	↓	97.9	146	144
1,2,3,4-TeCB	↓	↓	↓	↓	↓	↓	↓	↓									↓	↓	↓	↓	↓	97.6	144	142
Penta-CB	↓	↓	↓	↓	↓	↓	↓	↓									↓	↓	↓	↓	↓	98.6	144	142
Hexa-CB	↓	↓	↓	↓	↓	↓	↓	↓									↓	↓	↓	↓	↓	97.8	139	138
PCB as 1260	0.32	<0.10	<0.10	0.74	0.12	<0.10	0.75	<0.10									0.12	<0.10	0.17	<0.10	<0.10	97.0		134
Surrogate TCMX	128	107	105	111	110	103	139	110									102	99.3	104	103	100	98.2	141	140
DCBP	142	117	115	112	123	109	162	117									102	114	108	110	130	110	162	158
105 Data	18	18	18	18	18	18	18	18									18	18	18	18	18	18	18	18

J = Estima

E = Exceed calibration range

Sample Tracking Form

Page 2 of ~~4~~ 3

Date: 17AUG00

ACID — Sample Description

Target Analyte	345 0.5 95	345 4 96	346 0.5 97	346 4 98	347 0.5 99	347 4 100	348 0.5 101	348 4 102	349 0.5 103	349 4 104	Smpl 15 105	Smpl 5*5 106	~~350 0.5 107~~	~~350 4 108~~	~~351 0.5 109~~	~~351 4 110~~	~~352 0.5 111~~	~~352 4 112~~	~~353 0.5 113~~	~~353 4 114~~	Blank # 7	LCS # 7	MS # 95	MSD # 95
1,3,5-TriCB	<0.01	<0.01	<0.01	<0.01	<0.01	<0.01	<0.01	<0.01	<0.01	<0.01		<0.01									<0.01	98.2	88.8	96.6
1,2,4-TriCB																						98.4	85.8	96.2
1,2,3-TriCB																						97.2	87.6	96.0
1,2,3,5&1,2,4,5																						99.0	92.1	97.3
1,2,3,4-TeCB																						96.5	91.0	94.8
Penta-CB																						97.5	98.2	97.6
Hexa-CB																						100	101	102
PCB as 1260	<0.10	<0.10	0.31	<0.10	0.13	<0.10	0.22	<0.10	0.61	<0.10		<0.10									<0.10	104	110	98.9
Surrogate TCMX	106	99.9	99.3	98.7	98.7	99.6	94.5	95.4	122	90.0		89.8									114	98.3	96.9	99.8
DCBP	108	108	100	112	107	111	104	107	137	106		113									128	114	103	90.9
	T/Arochlor 1260							OK #	U2 PEAK AFTER MARKER															
5 Day	18	18	18	18	18	18			18	18		18									~~18~~ 17	18	18	18

J = Estim[ated] AUGUST 00

601 8926496
601 8926496;

Page 1 of _____

Sample Tracking Form

Date: 18 Aug 00

Target Analyte	350 0.5 107	350 4 108	351 0.5 109	351 4 110	352 0.5 111	352 4 112	353 0.5 113	353 4 114	354 0.5 115	354 4 116a	HA-1 0.5 117	1 4 118	2 0.5 119	2 4 120	3 0.5 121	3 1.5 122	4 0.5 123	4 2.5 124	5 0.5 125	5 2.5 126	Blank # 8	LCS # 8	MS # 107	MSD # 107
	ACID								ACID	ACID				ACID									ACID	ACID
1,3,5-TriCB	<0.01	<0.01	<0.01	<0.01	<0.01	<0.01																	140	137
1,2,4-TriCB																							135	135
1,2,3-TriCB																							133	131
1,2,3,5&1,2,4,5																							133	131
1,2,3,4-TeCB																							126	124
Penta-CB																							124	121
Hexa-CB	✓	✓	✓	✓	✓	✓																	124	122
PCB as 1260	1.8	<0.10	0.33	<0.10	0.55	<0.10																	121	~~117~~ 124
Surrogate TCMX	104	100	96	96	101	80																	124	117
DCBP	116	114	108	116	114	105																	138	129
INJ Dup	18	18	18	18	18	18																	18	18

J = Estim

OGDEN

Job Name: Crystal Springs-
Job Number:
Title: Sonny Reeves backyard 405 Jackson
Computed by: Checked by:
Date: 8/16 2000 Sheet: 1 Of: 11

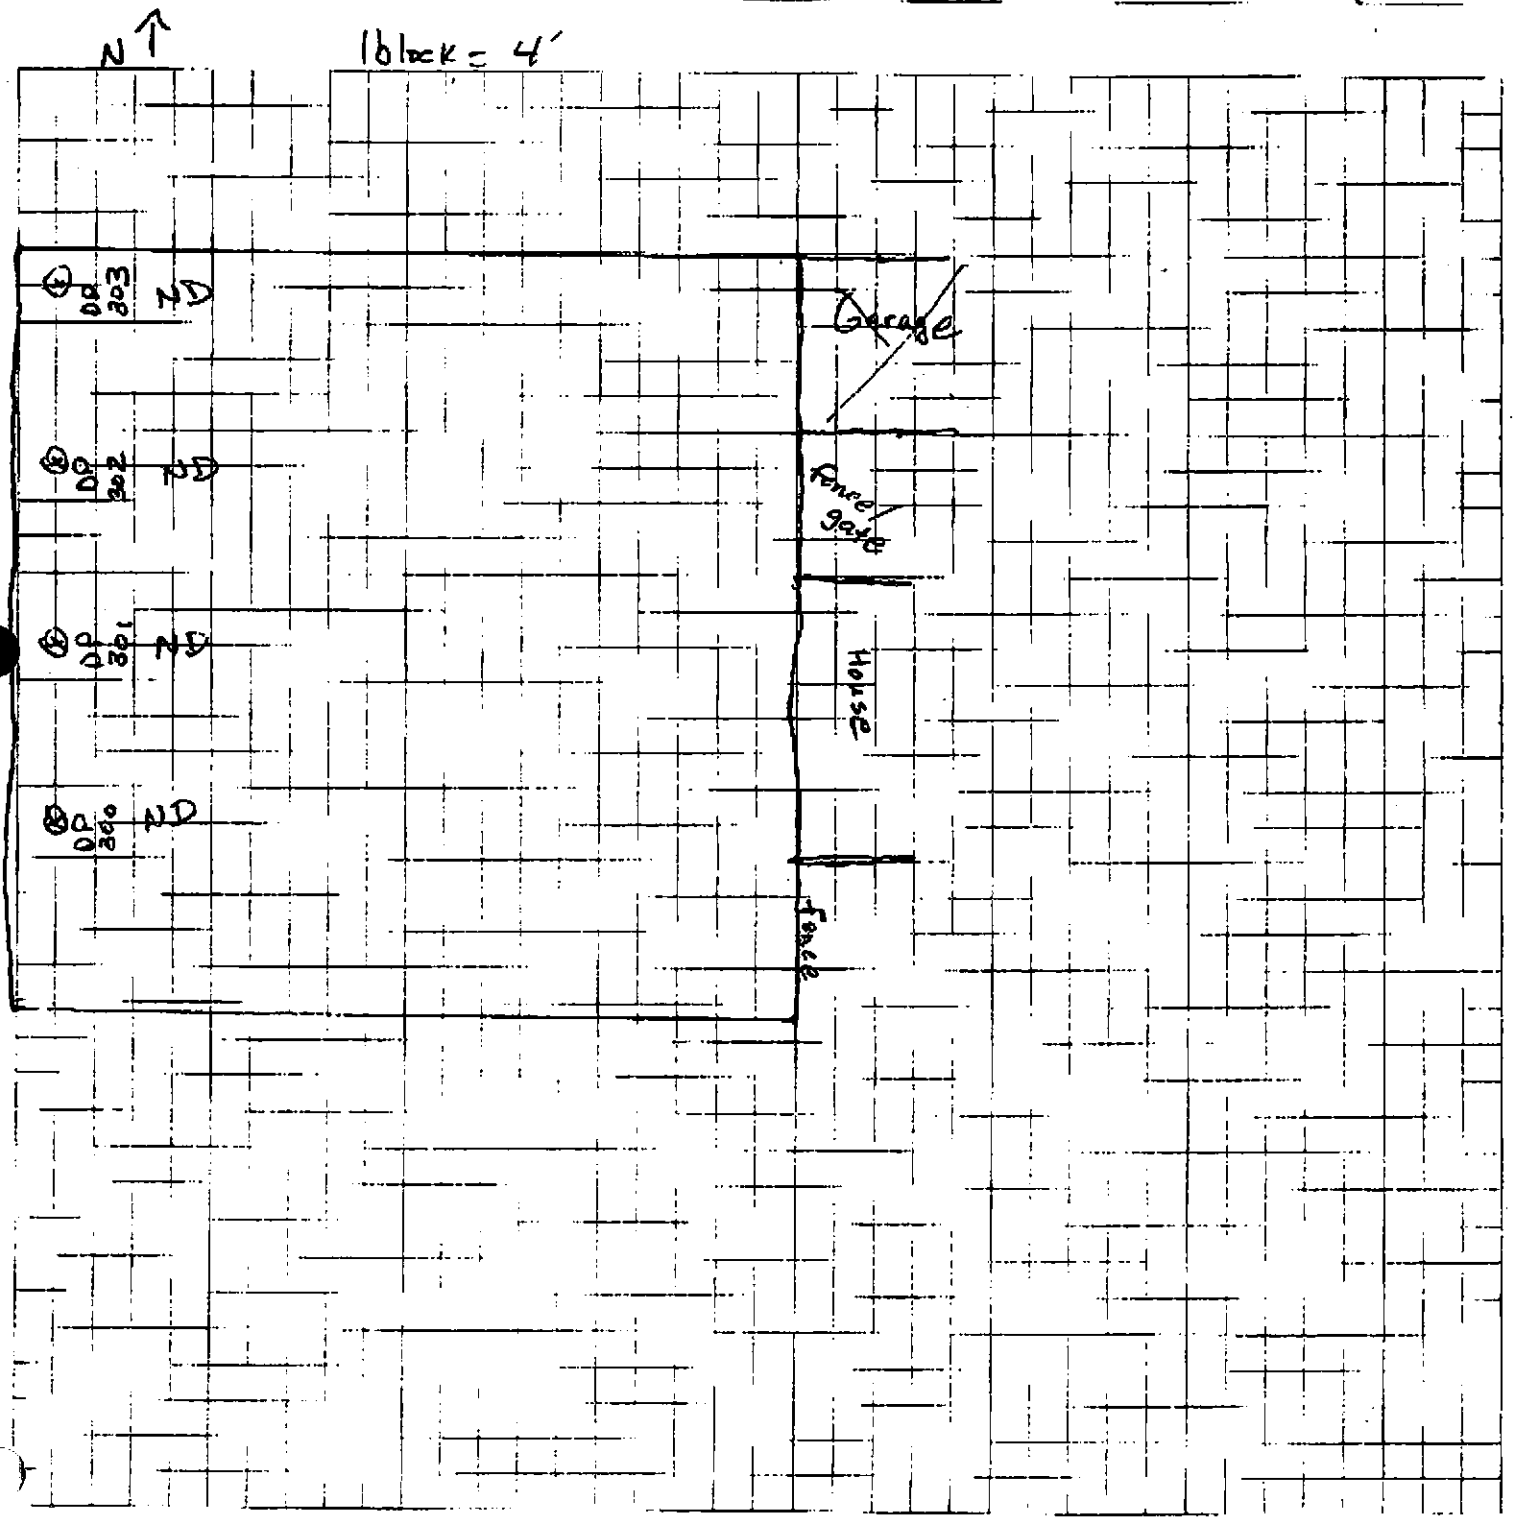

OGDEN

Job Name: Crystal Springs

Job Number:

Title: Stringer Funeral Home

Computed by: Checked by:

Date: Sheet: 2 Of: 11

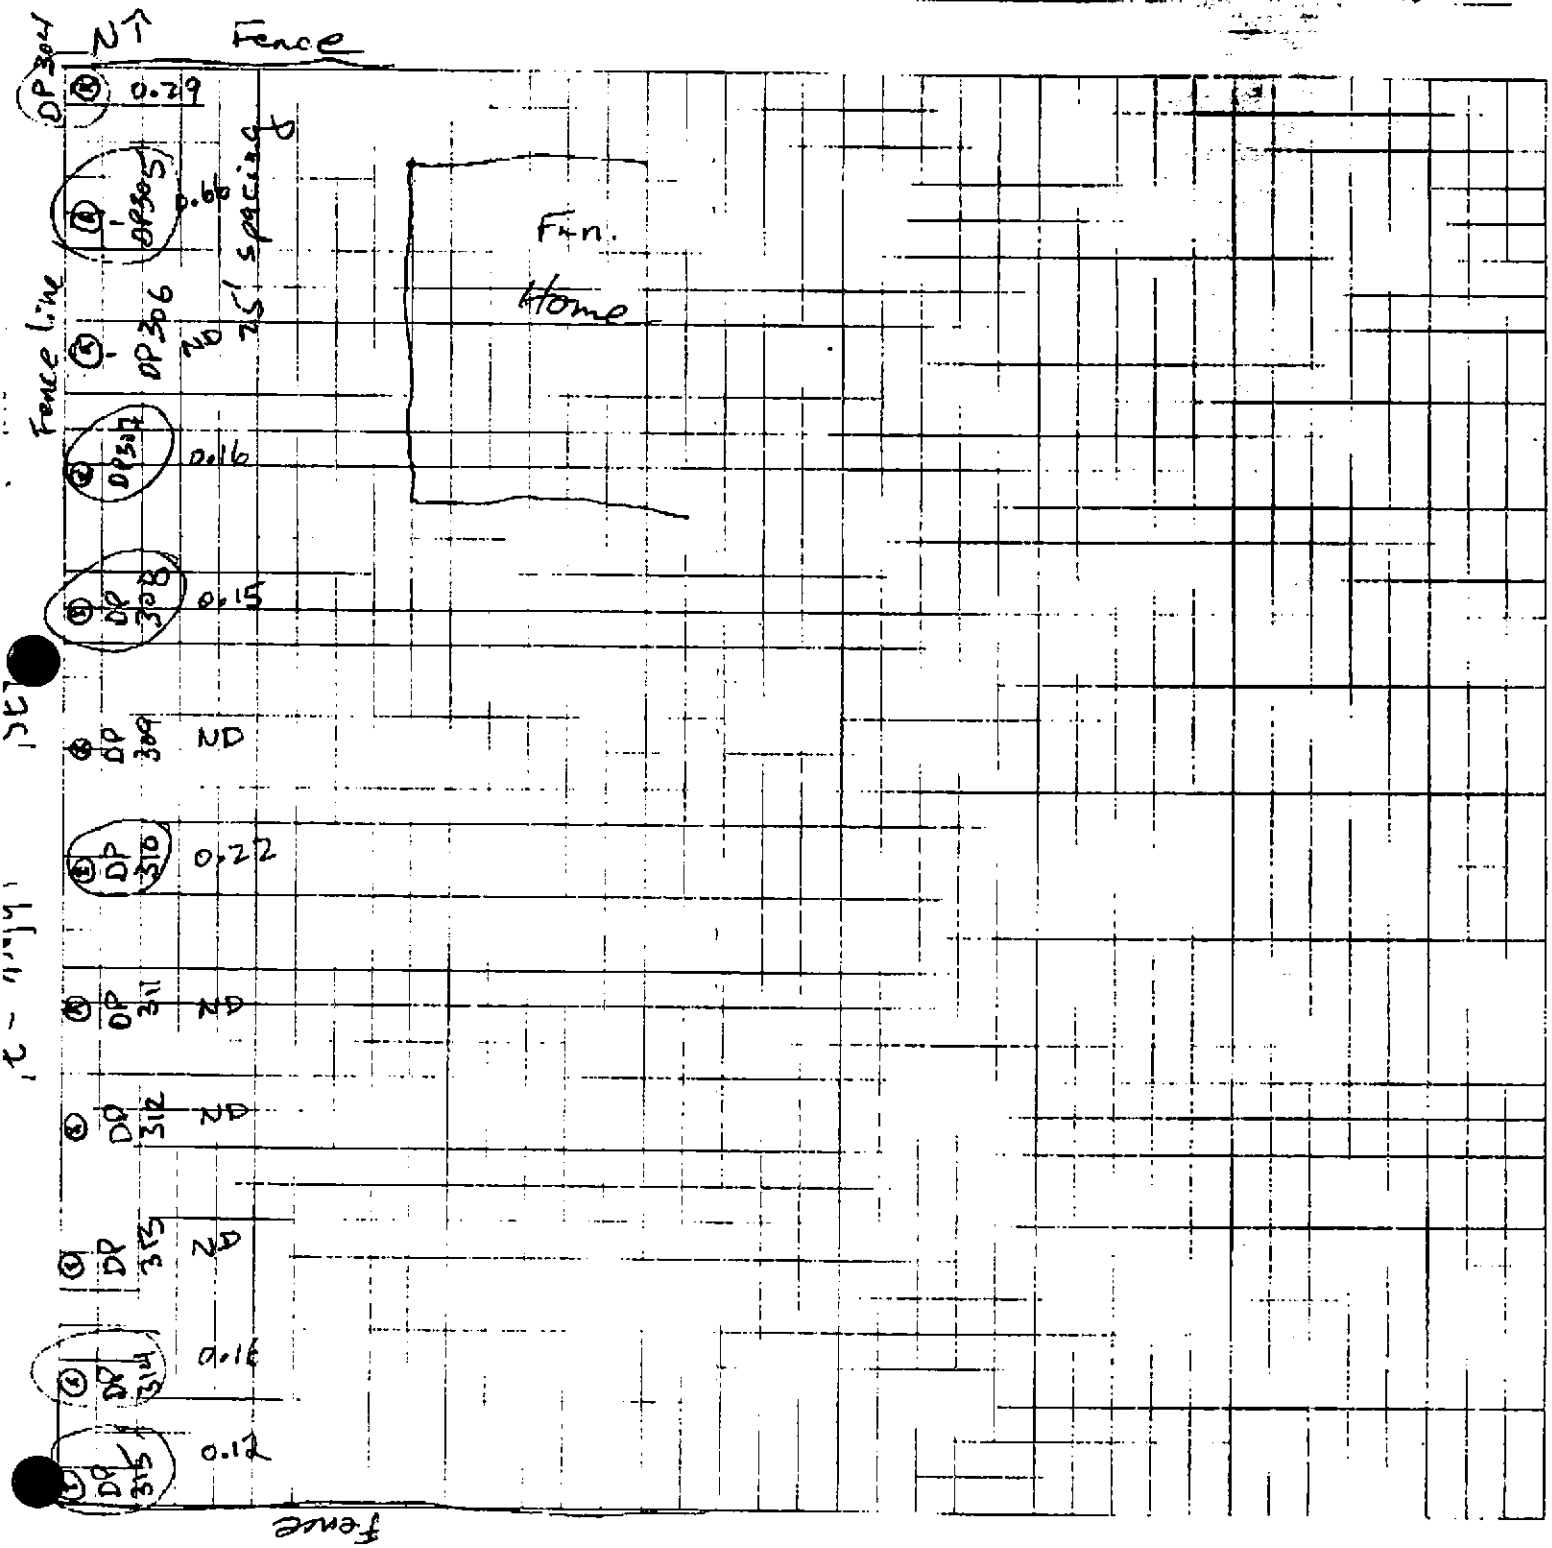

OGDEN

Job Name: Crystal Springs
Job Number:
Title: 401 N. Jackson Elnor Wright
Computed by: Checked by:
Date: 8-16-2000 Sheet: 3 Of: 11

1 block = 4'

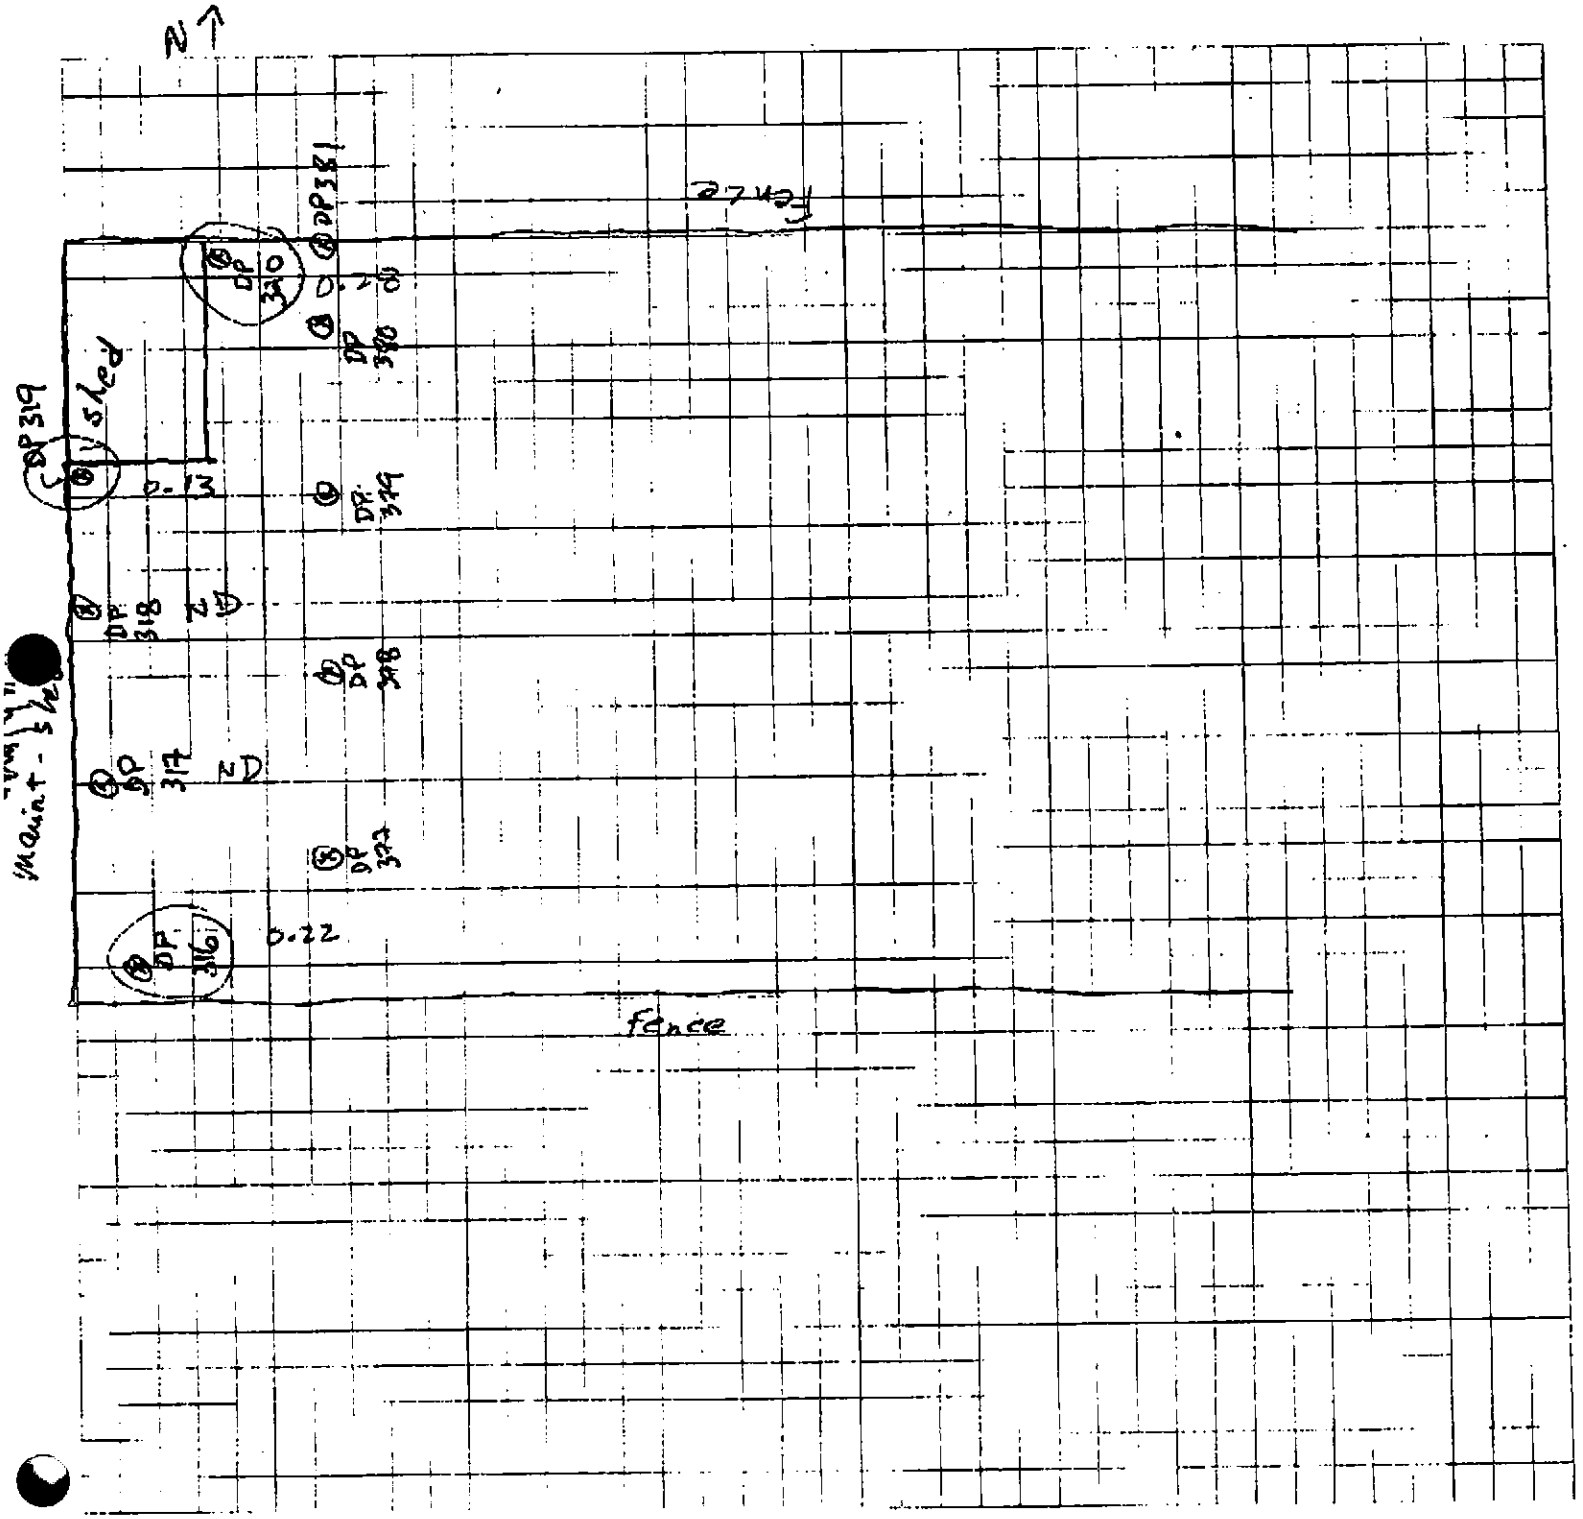

OGDEN

Job Name: Crystal Springs
Job Number:
Title: 407 N. Jackson, Louie Lang
Computed by: Checked by:
Date: 8-16-00 Sheet: 4 Of: 11

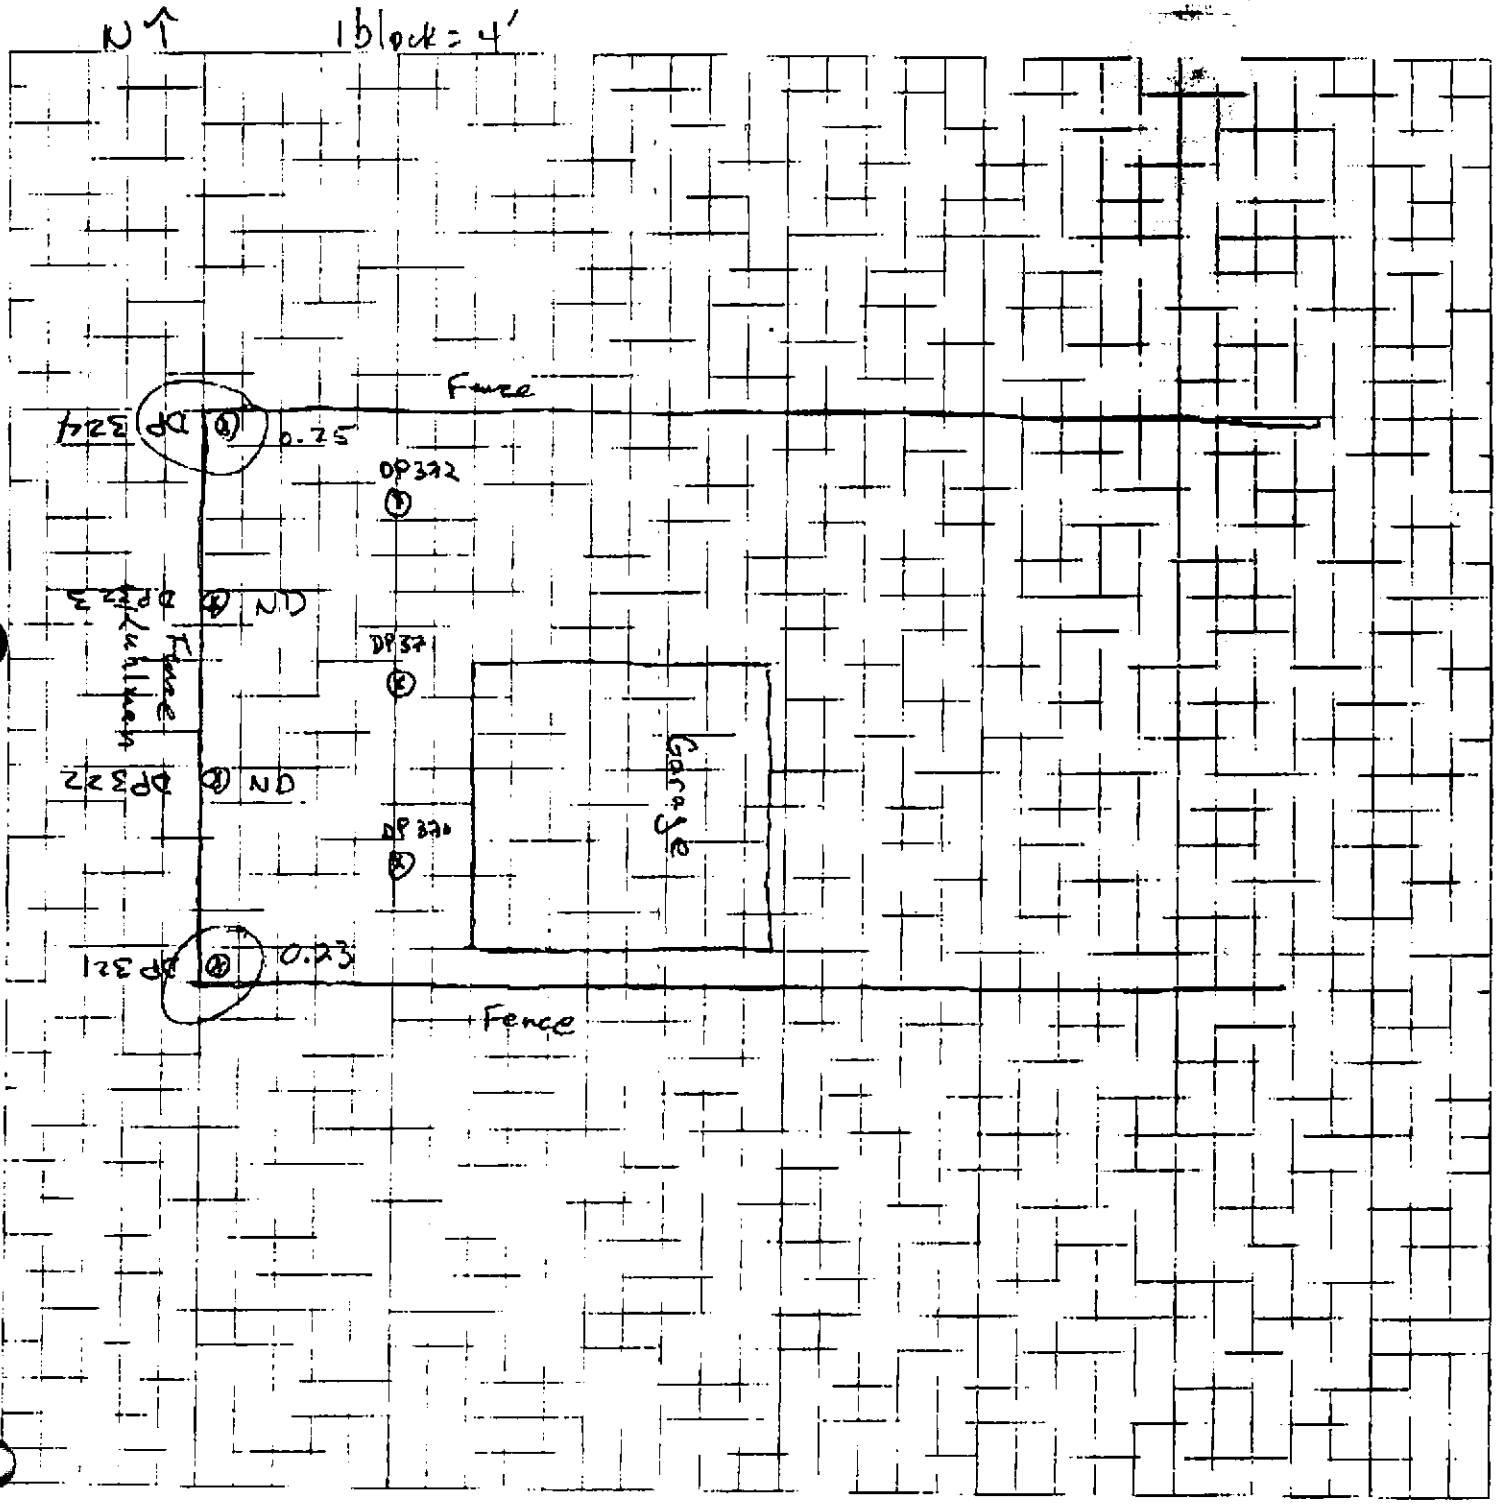

OGDEN

Job Name: Crystal Springs
Job Number:
Title: Lee St. Medical
Computed by: Checked by:
Date: 8/17/00 Sheet: 5 Of: 11

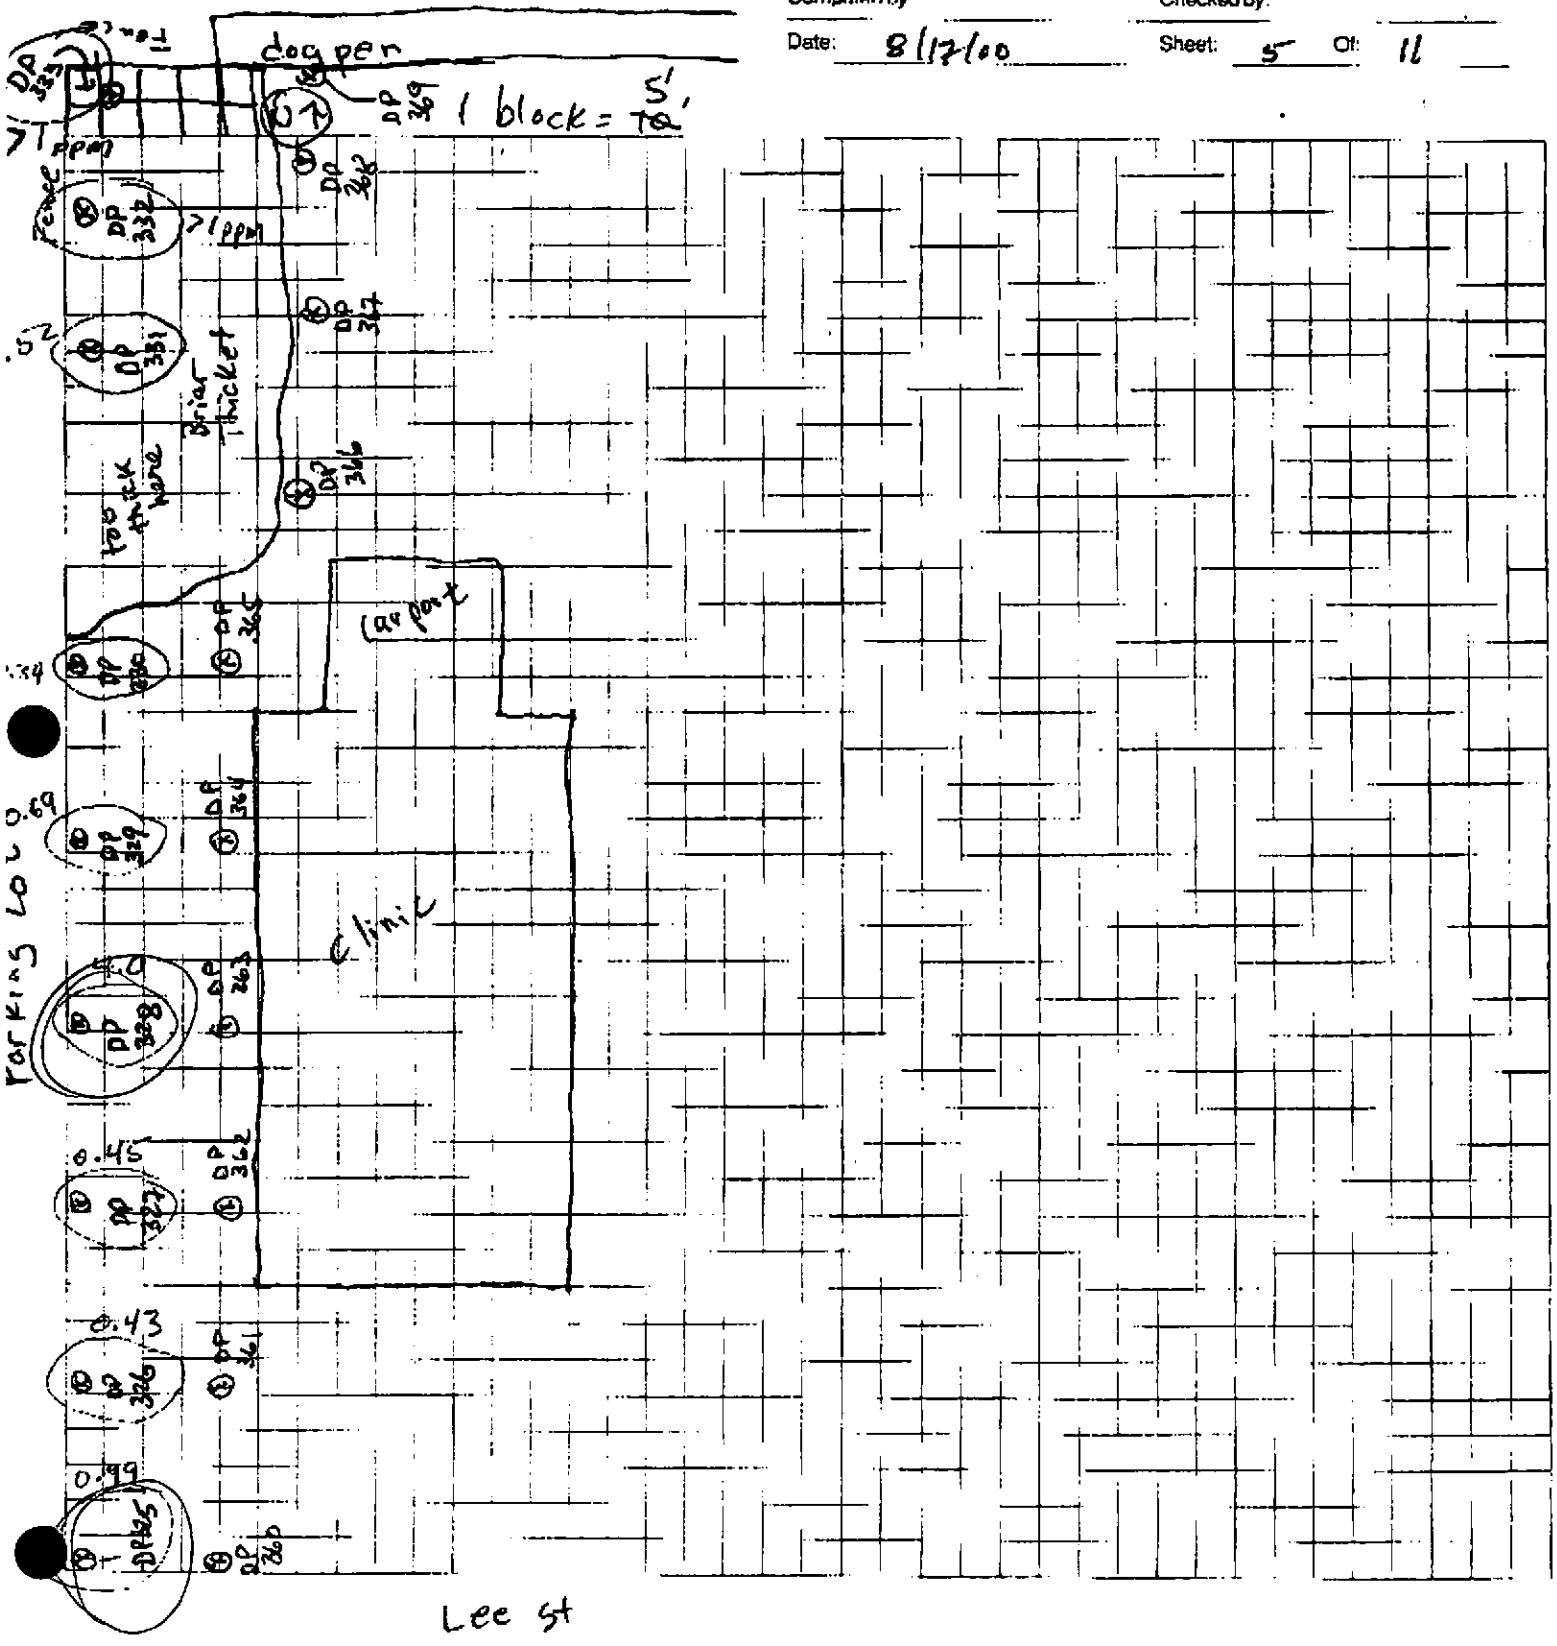

OGDEN

Job Name: Crystal Springs
Job Number:
Title: 303 N. Jackson (Stringer)
Computed by: Checked by:
Date: 8-17-00 Sheet: 6 Of: 11

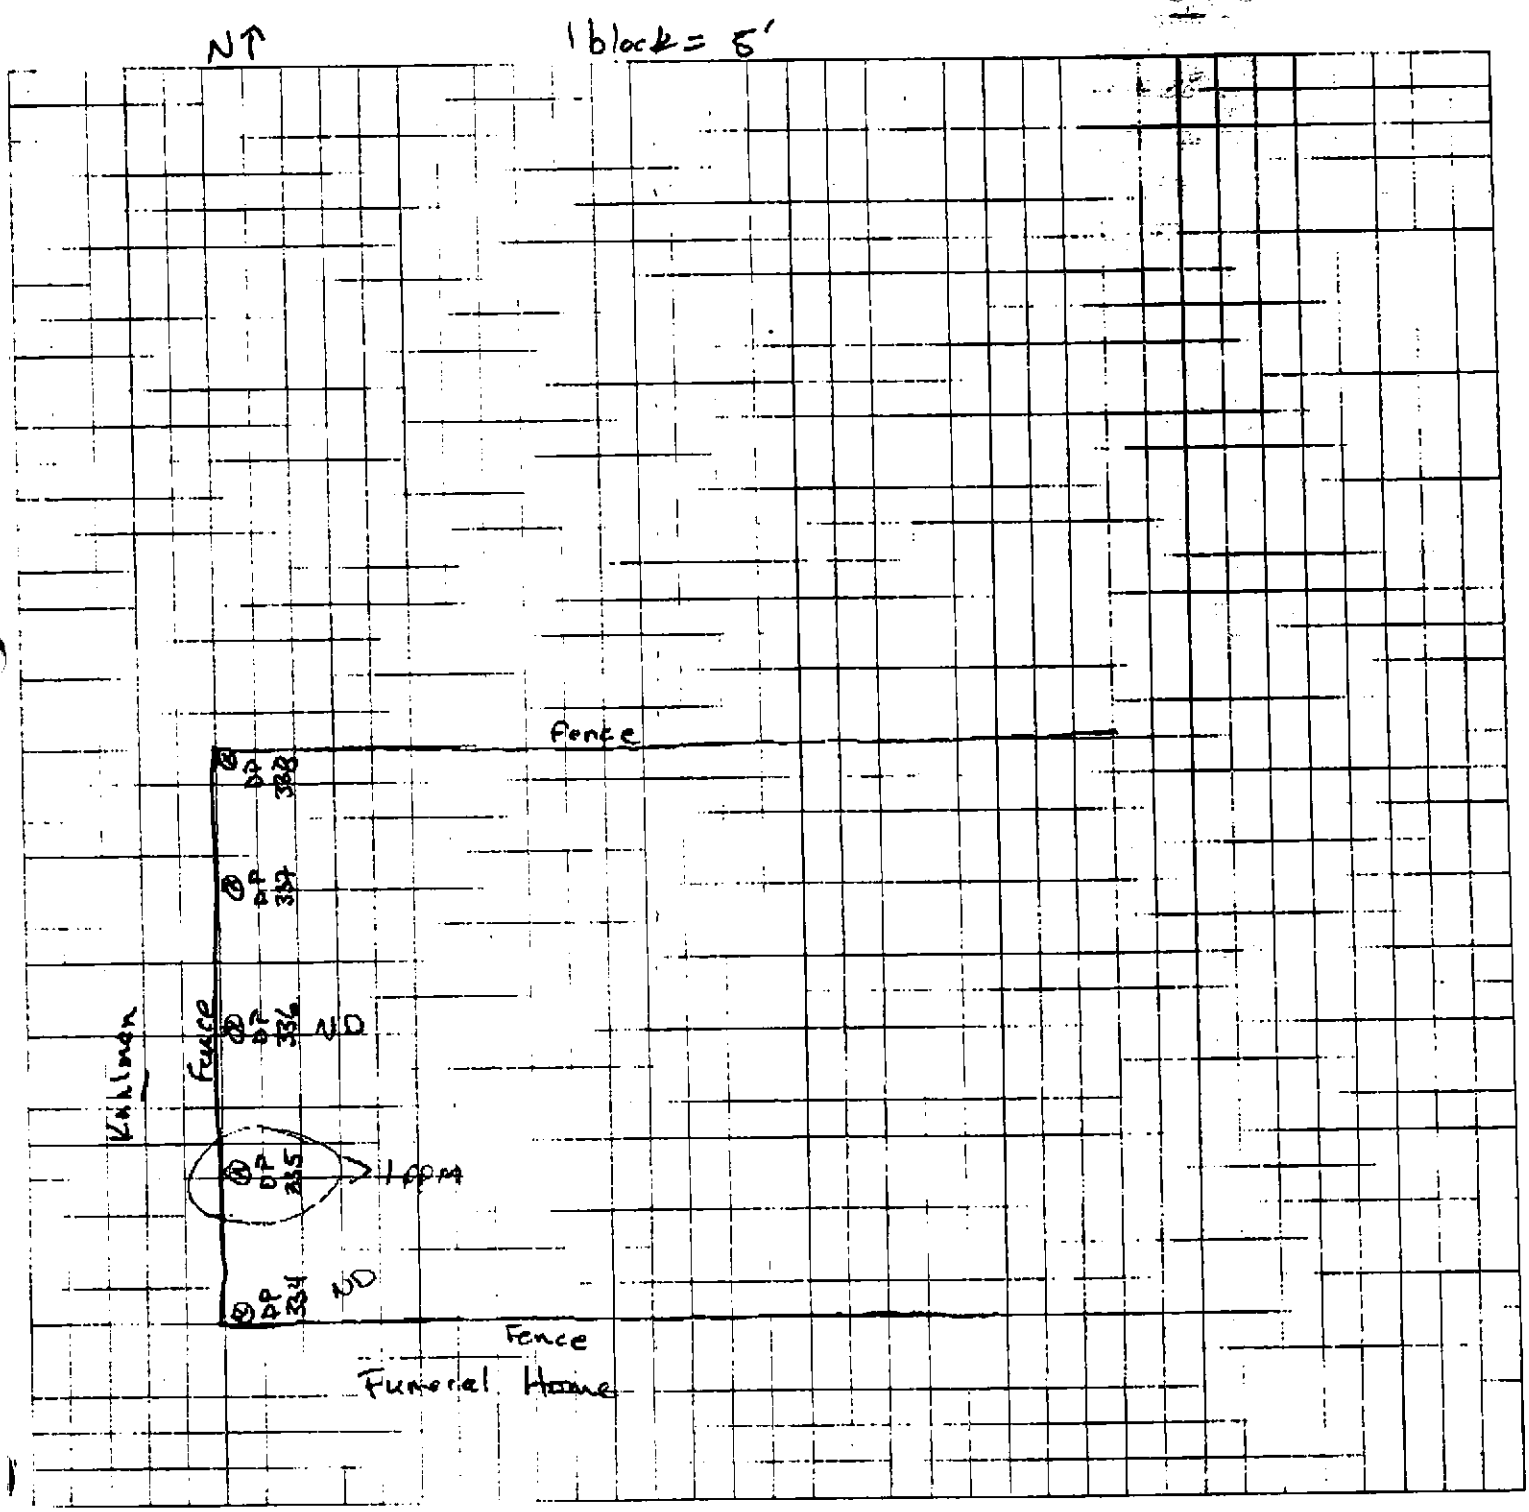

OGDEN

Job Name: Crystal Springs
Job Number:
Title: 219 N. Jackson - Perry Smith
Computed by: TJF Checked by:
Date: 8-17-00 Sheet: 7 Of: 11

1 block = 5'

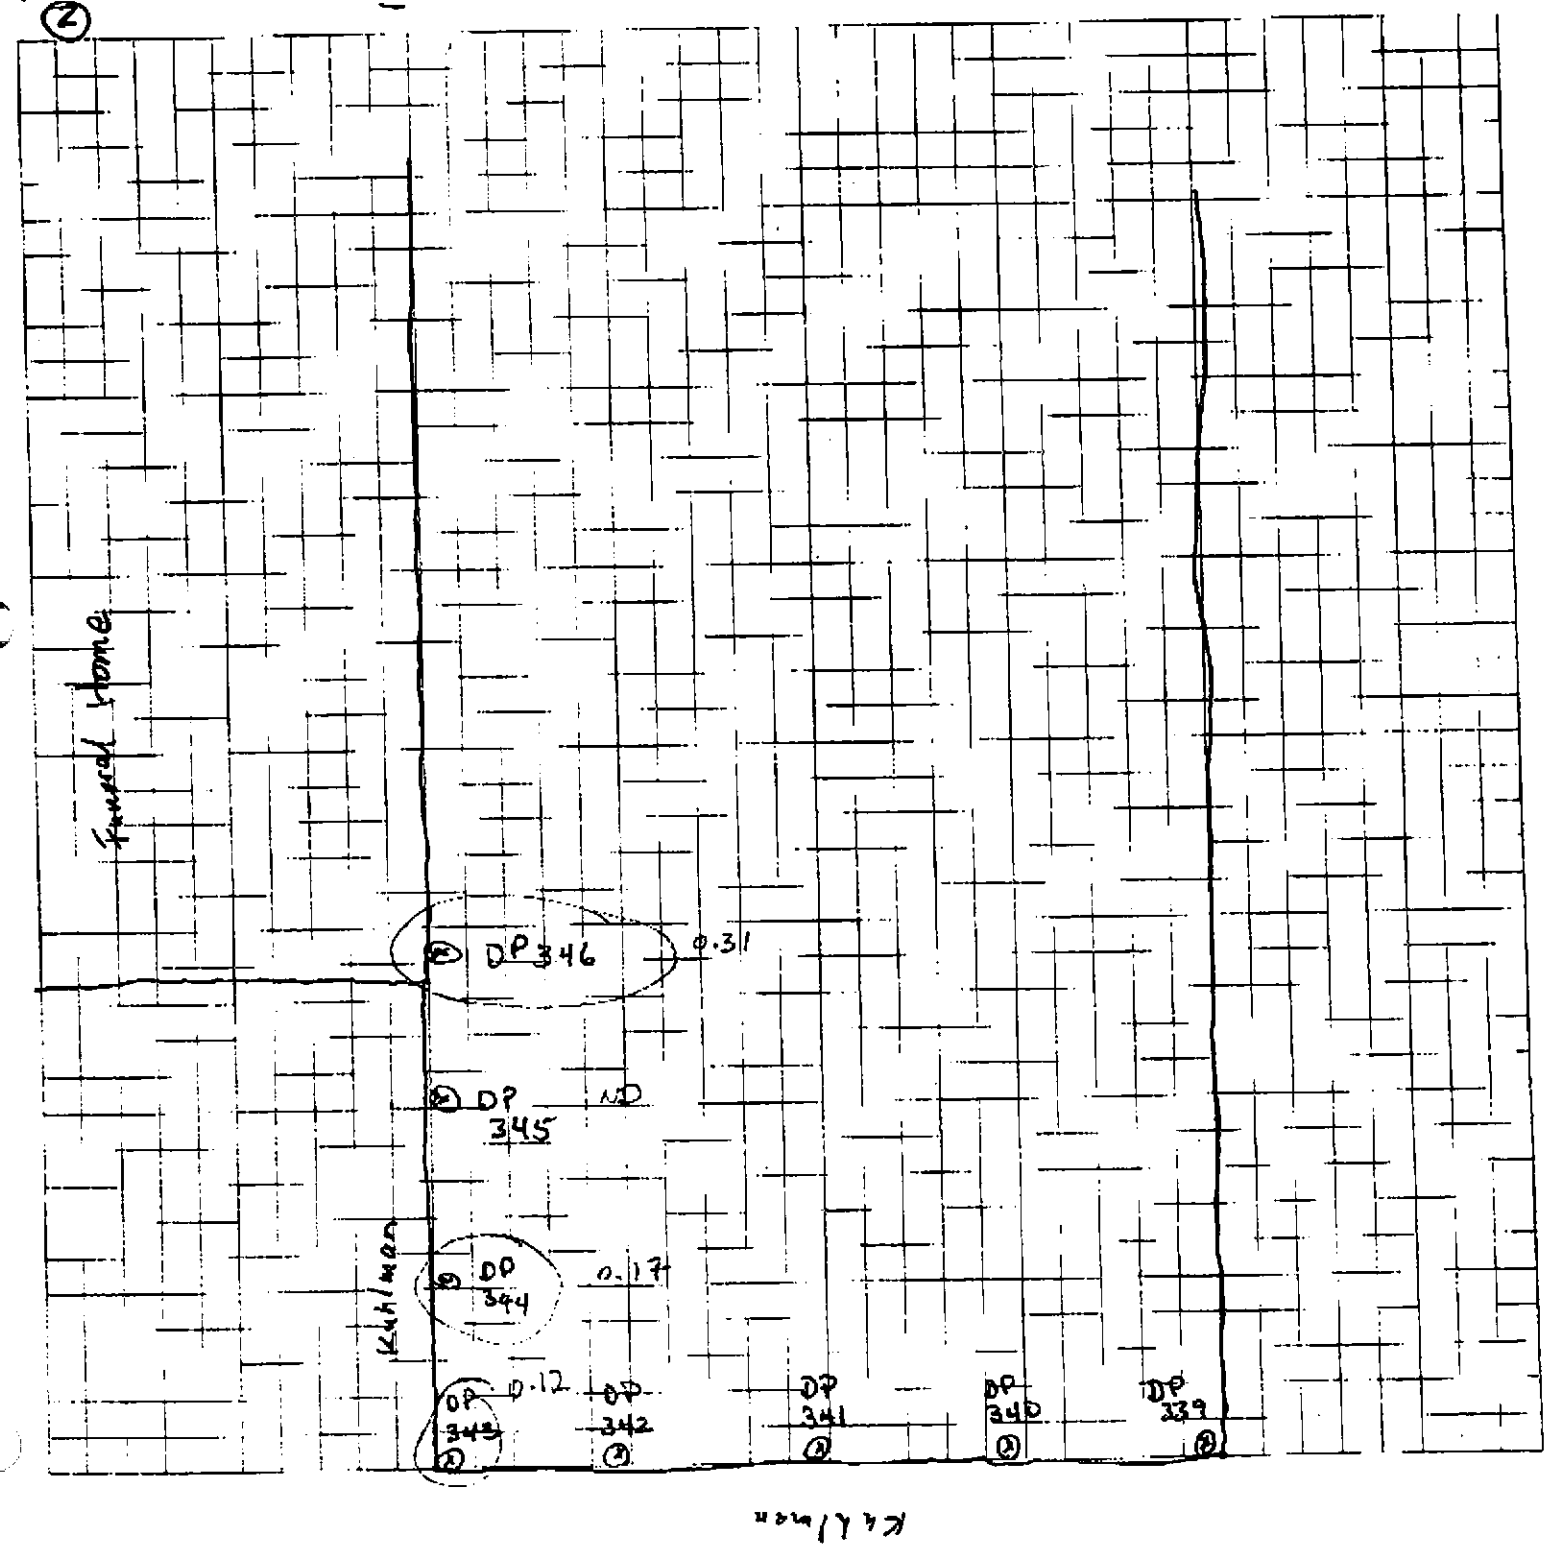

601 8926496

OGDEN

Job Name: Crystal Springs
Job Number:
Title: 409 N. Jackson (Amy Cooper)
Computed by: DF
Checked by:
Date: 8-17-00
Sheet: 8 Of: 11

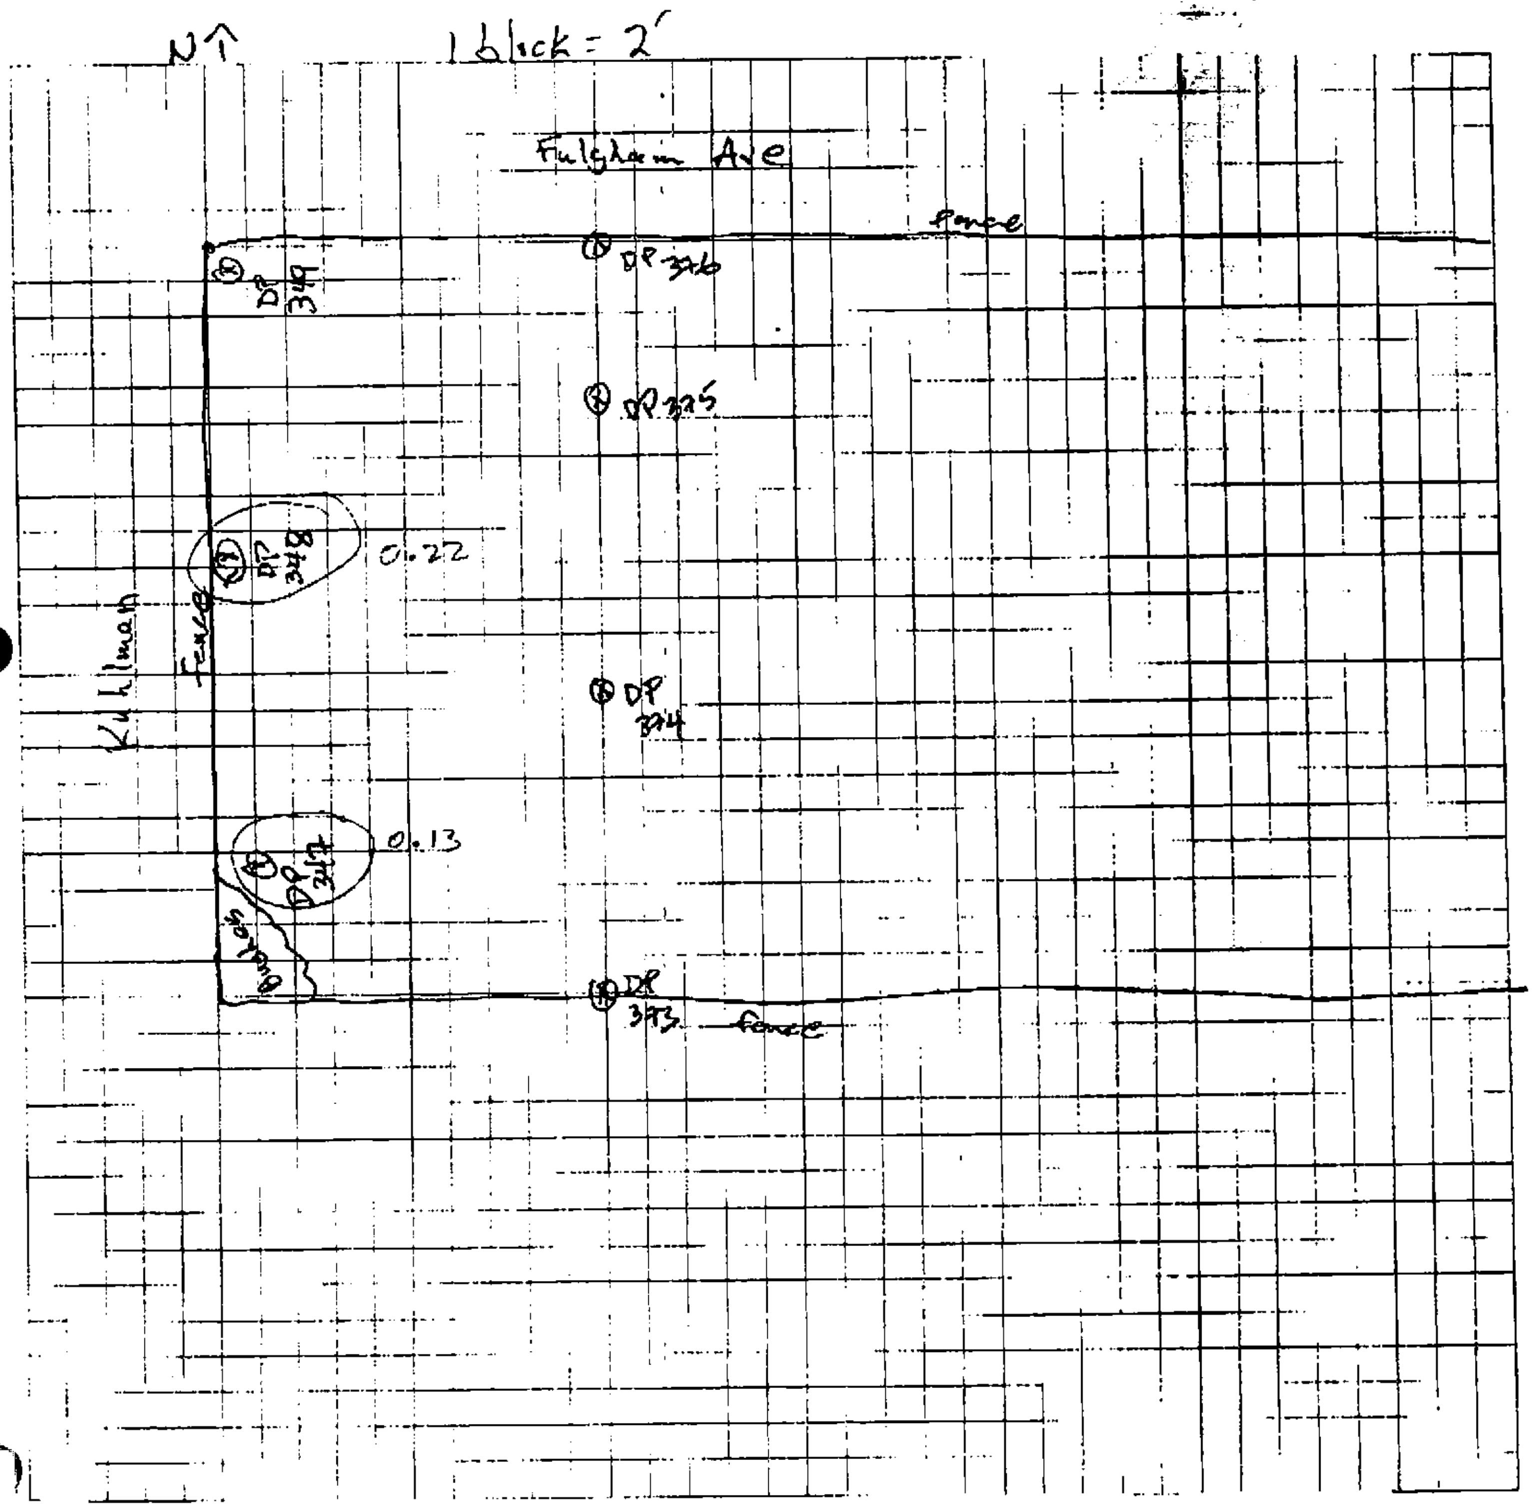

OGDEN

Job Name: Crystal Springs
Job Number:
Title: Dabney Home
Computed by: TJF Checked by:
Date: 8-17-00 Sheet: 9 Of: 11

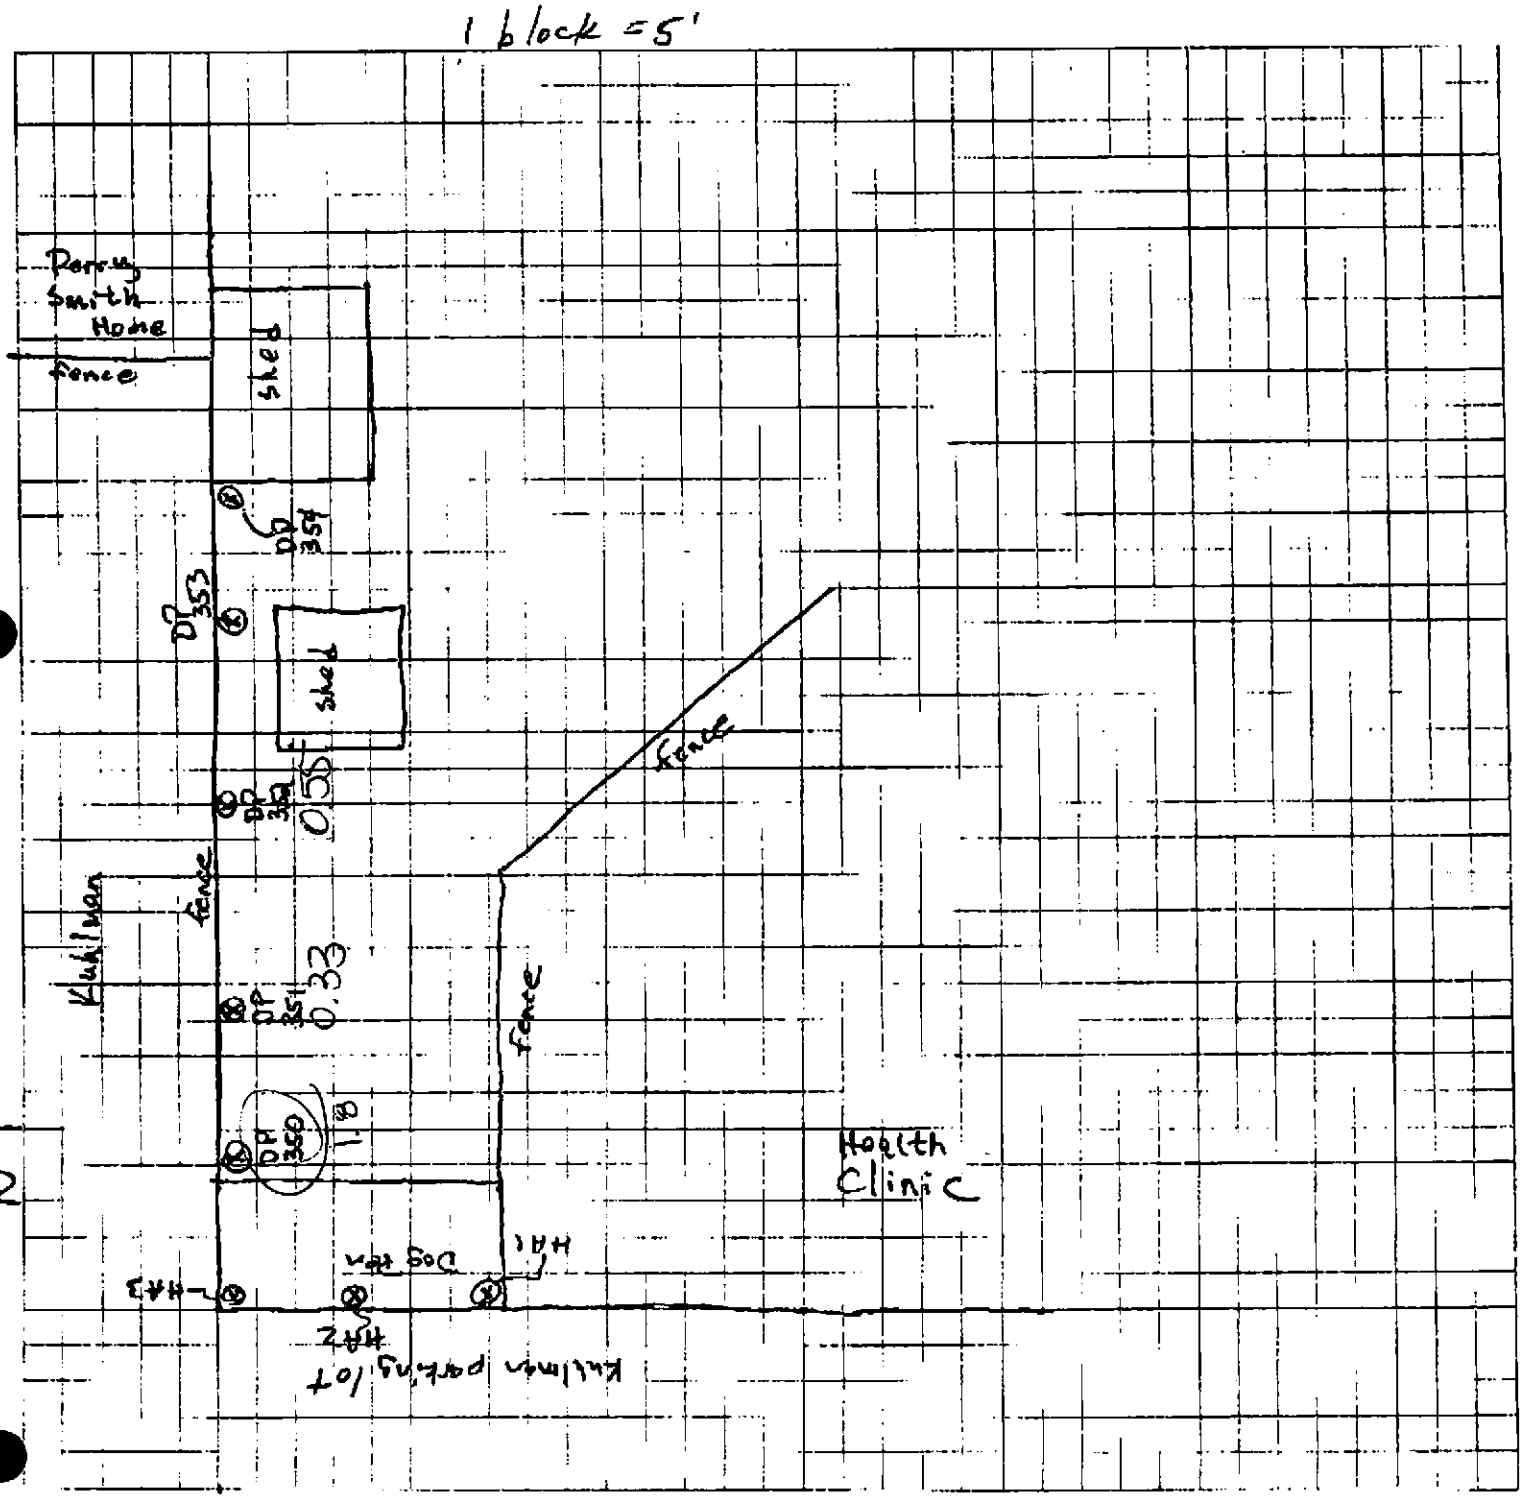

OGDEN

Job Name: Crystal Springs
Job Number:
Title: Wright House
Computed by: Checked by:
Date: 8-18-00 Sheet: 10 Of: 11

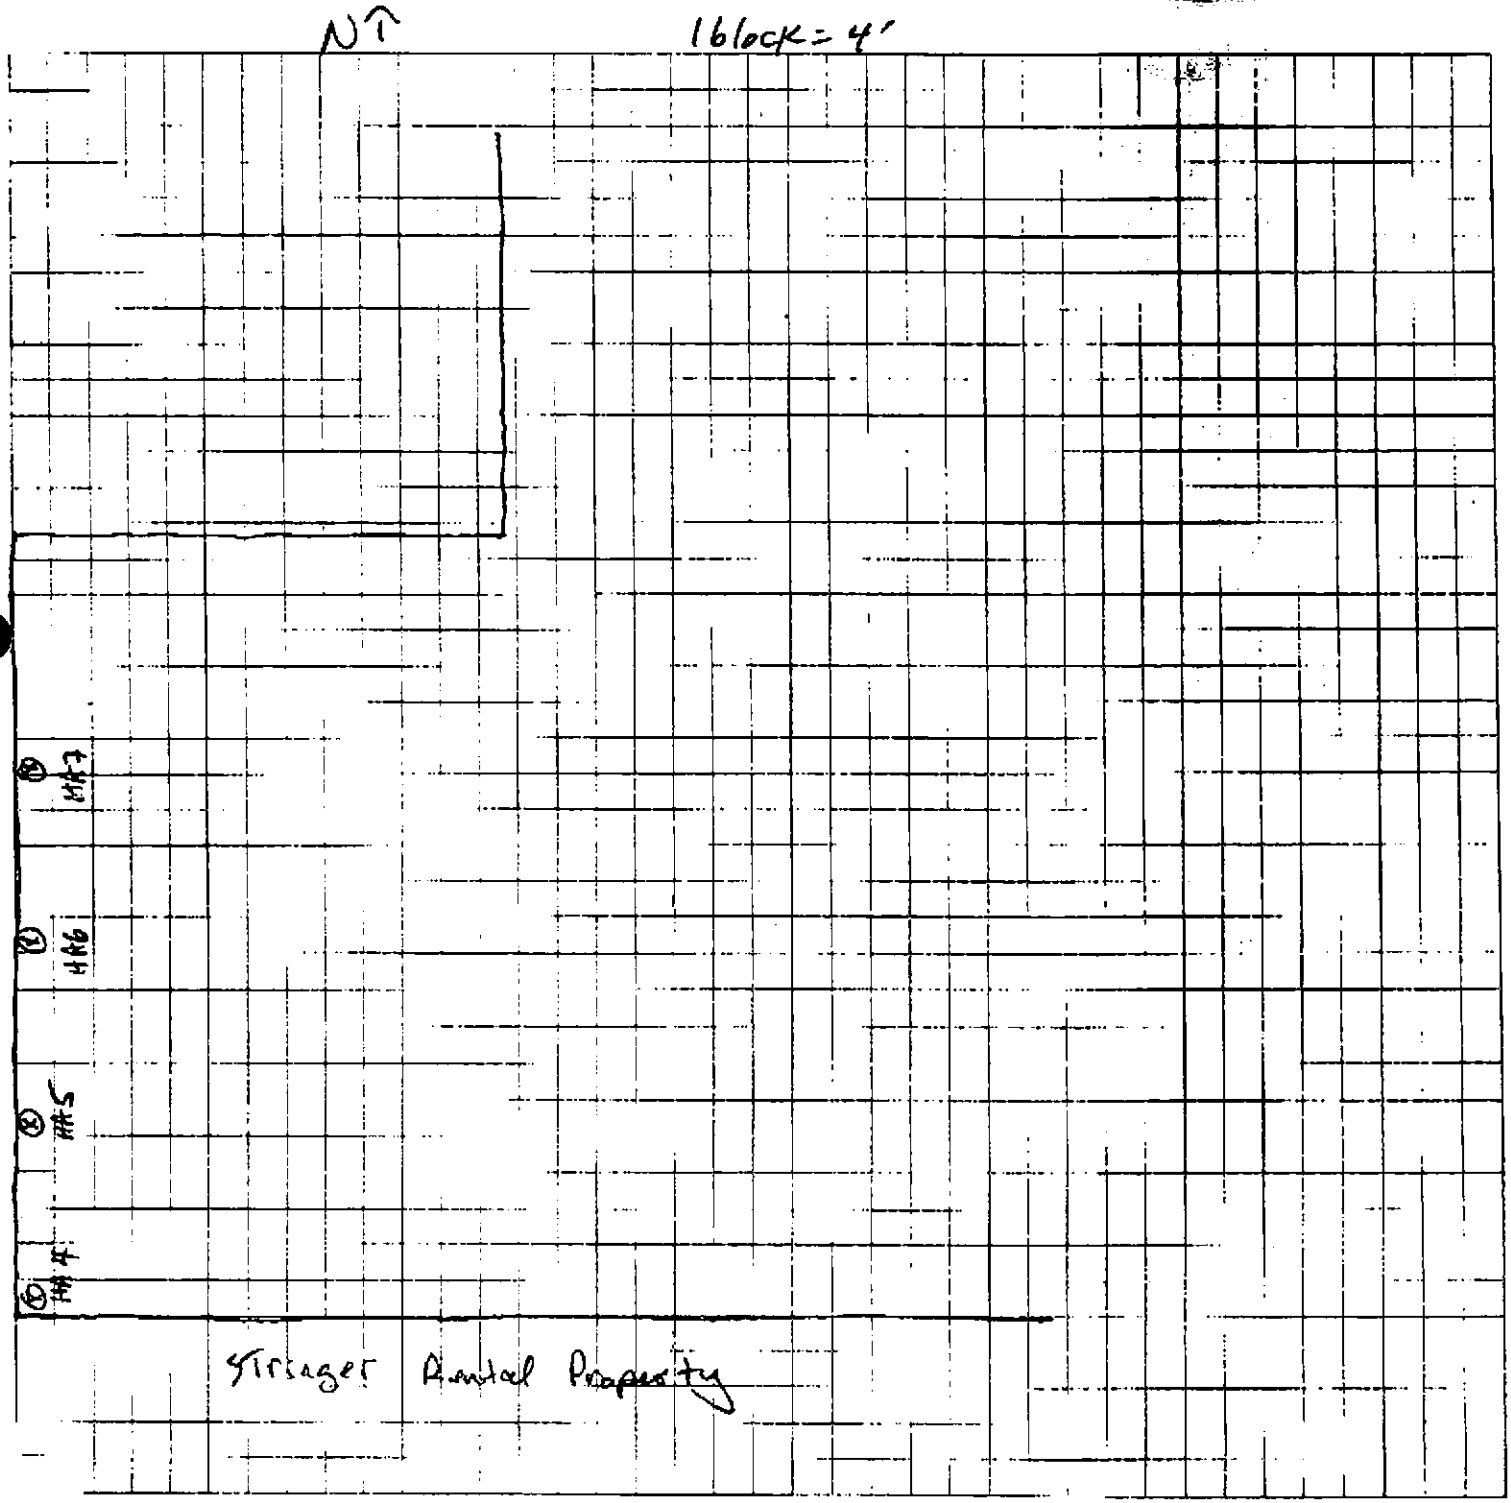

OGDEN

Job Name: Crystal Springs
Job Number:
Title: Harold & Suzanne Warren
Computed by: TJF Checked by:
Date: 8-18-00 Sheet: 11 Of: 11

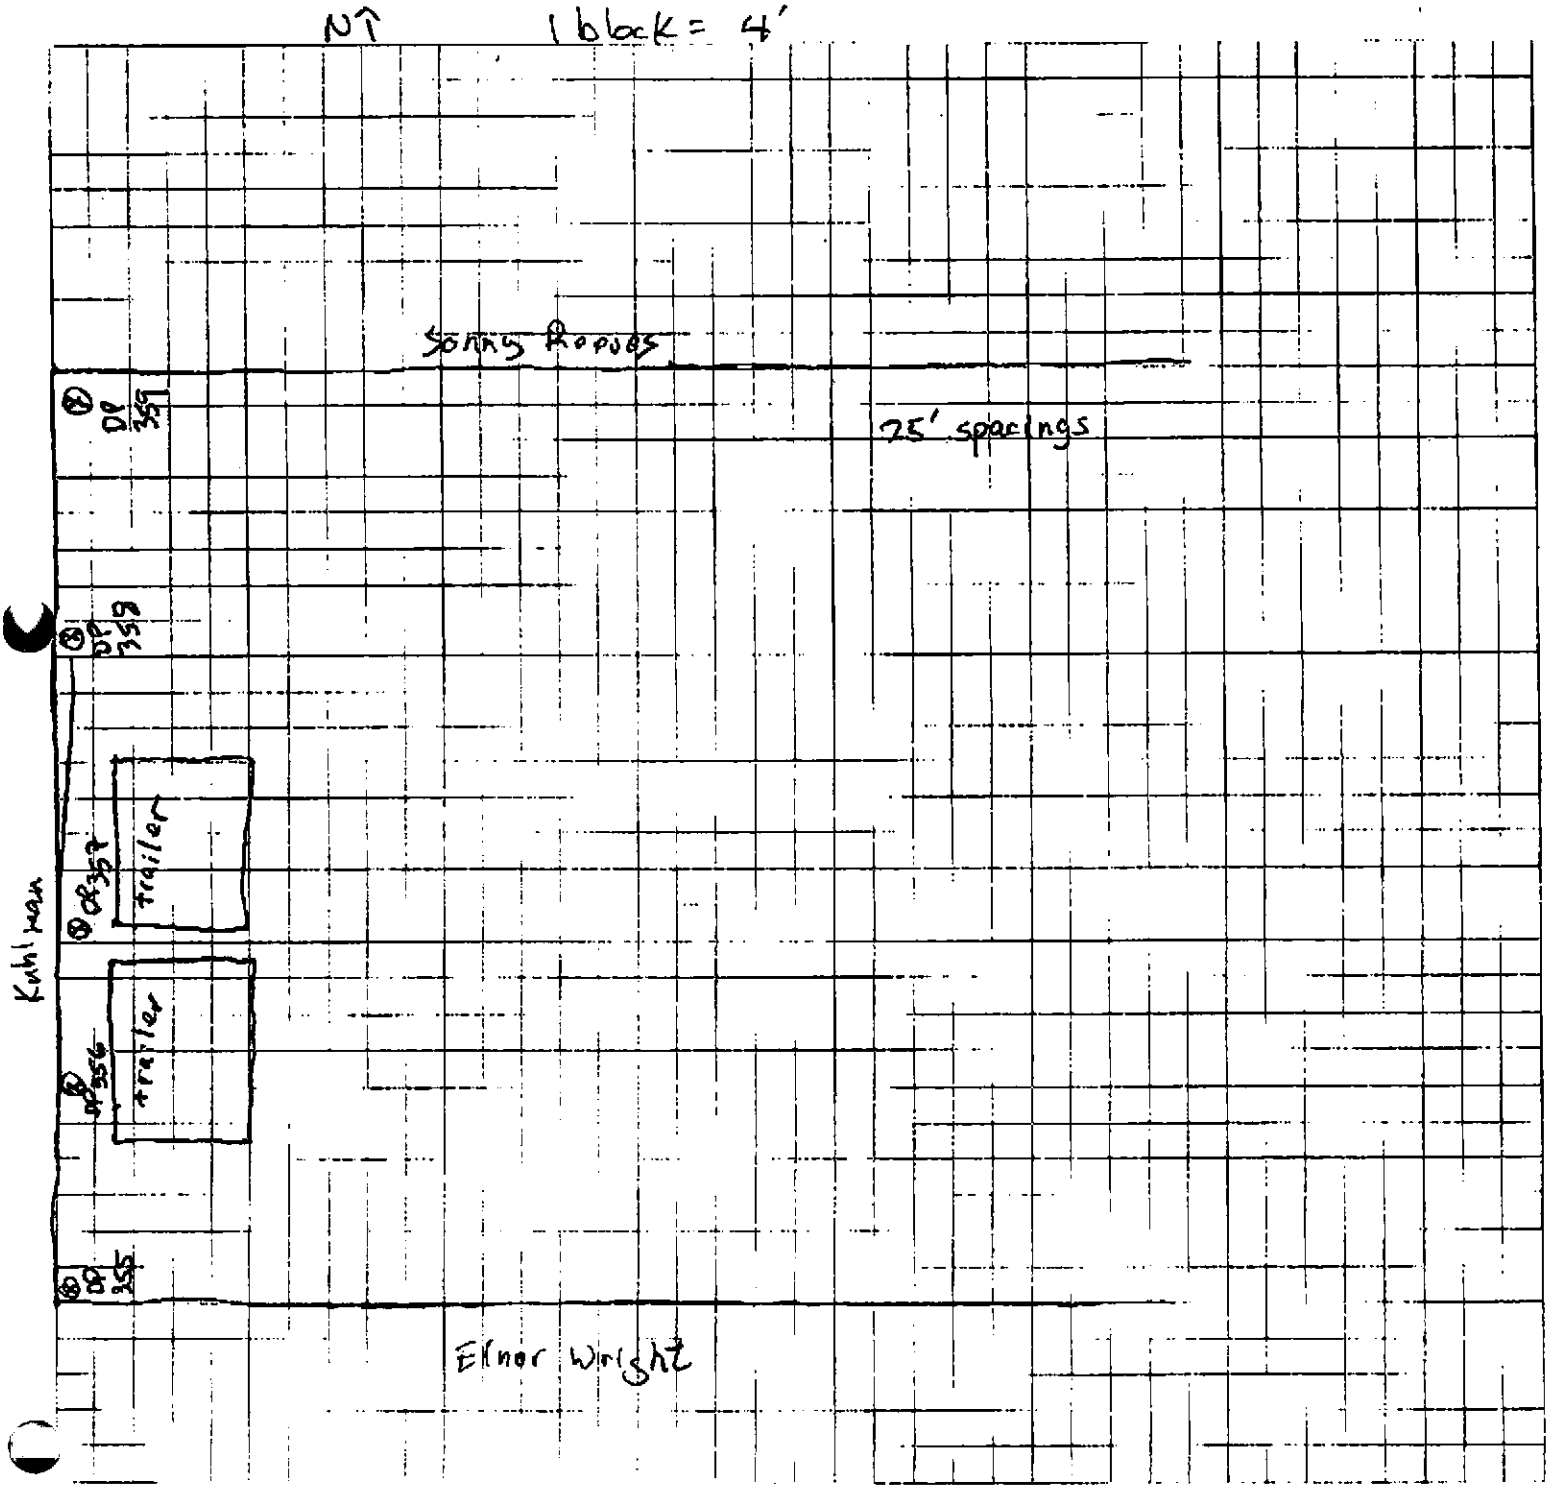

STRINGER FUNERAL

OGDEN

Job Name:
Job Number:
Title:
Computed by:
Date:

FILE COPY

Checked by:
Sheet: of:

FAX COVER SHEET

To: Anastasia Hamel / Gretchin Zmitrovich

From: Tim Fitzpatrick (704-236-3496)

Total pages including cover sheet: 10

Ms. Hamel & Ms. Zmitrovich:

Following is all data available at this point w/ location maps. As stated, the mobile lab experienced troubles w/ their autosampler last night and as a result they are somewhat behind, but should be able to catch up by tomorrow AM. - Please call me on my cell phone if I can help any further (number listed above).

Best Regards;

Tim Fitzpatrick

Sr. Environmental Chemist.

Page 2 of 3

Sample Tracking Form

Date: Aug 16 2000

Target Analyte	Sample Description																							
	PP340 0.5 24	PP340 4 25	DP341 0.5 26	341 4 27	342 0.5 28	342 4 29	343 0.5 30	343 4 31	344 0.5 32	344 4 33	345 0.5 34	345 4 35	346 0.5 36	346 4 37	347 0.5 38	347 4 39	348 0.5 40	348 4 41	349 0.5 42	349 4 43	~~30~~ Blank #3	~~30~~ LCS #3	MS # 30	MSD # 30
1,3,5-TriCB	<0.01		<0.01	<0.01	<0.01	<0.01	<0.01	<0.01	<0.01	<0.01	<0.01	<0.01	<0.01								<0.01	97.4	100	104
1,2,4-TriCB	↓		↓	↓	↓	↓	↓	↓	↓	↓	↓	↓	↓								↓	99.0	101	105
1,2,3-TriCB																						97.0	100	105
1,2,3,5&1,2,4,5																						99.5	103	107
1,2,3,4-TeCB																						99.4	103	107
Penta-CB																						101	106	108
Hexa-CB	↓		↓	↓	↓	↓	↓	↓	↓	↓	↓	↓	↓								↓	103	108	109
PCB as 1260	0.22		<0.10	<0.10	<0.10	<0.10	<0.10	<0.10	0.16	<0.10	~~0.33~~ 0.12	<0.10	0.22								<0.10	100	112	107
Surrogate recov DCBP	101 115		96 91	74 79	111 103	93 106	110 109	107 114	112 112	99 105	134 128	107 112	127 129								104 112	100 107	103 109	107 107
			THAC 1260		THAC 1260																			

J = Estim

E = Exce calibration range

ENT BY:

Sample Tracking Form

Page 1 of 3

Date: 16AUG00

Target Analyte	DP300 0.5 4	DP300 4 5	DP301 0.5 6	DP301 4 7	DP302 0.5 8	DP302 4 9	DP303 0.5 10	DP303 40 11	DP304 0.5 12	DP304 4 13	DP305 0.5 14	DP305 4 15	DP306 0.5 16	DP306 4 17	DP307 0.5 18	DP307 4 19	DP308 0.5 20	DP308 4 21	DP309 0.5 22	DP309 4 23	Blank #2	LCS #2	MS #	MSD #
	ACID		ACID		ACID		ACID				Acid Sample Description				BCID		ACID		ACID				ACID	ACID
1,3,5-TriCB	<0.01	<0.01	<0.01	<0.01	<0.01	<0.01	<0.01	<0.01	<0.01	<0.01						<0.01		<0.01	<0.01	<0.01	<0.01	99	145	146
1,2,4-TriCB	↓	↓	↓	↓	↓	↓	↓	↓	↓	↓						↓		↓	↓	↓	↓	99	141	142
1,2,3-TriCB																						99	140	141
1,2,3,5&1,2,4,5																						102	141	143
1,2,3,4-TeCB																						102	139	141
Penta-CB																						106	138	140
Hexa-CB	↓	↓	↓	↓	↓	↓	↓	↓	↓	↓						↓		↓	↓	↓	↓	107	135	~~136~~ 137
PCB as 1260	<0.10	<0.10	<0.10	<0.10	<0.10	<0.10	<0.10	<0.10	0.29	<0.10						<0.10		<0.10	<0.10	<0.10	<0.10	103	131	~~136~~ 133
Surrogate TCMX	99.6	105	129	104	135	106	137	111	102	85.1						118		108	137	104	111	104	135	136
DCBP	89.5	100	96.9	101	125	115	130	109	87.9	83.9						116		107	132	103	111	107	130	130
						3																		
	TRIP					UNKS																		
	1260					for													TRIP					
						TCMX													1260					

J = Estima

E = Exceeds calibration range

OGDEN

ZERO 200

Job Name: Crystal Springs
Job Number:
Title: Stringer Funeral Home
Computed by: Checked by:
Date: Sheet: 2 Of:

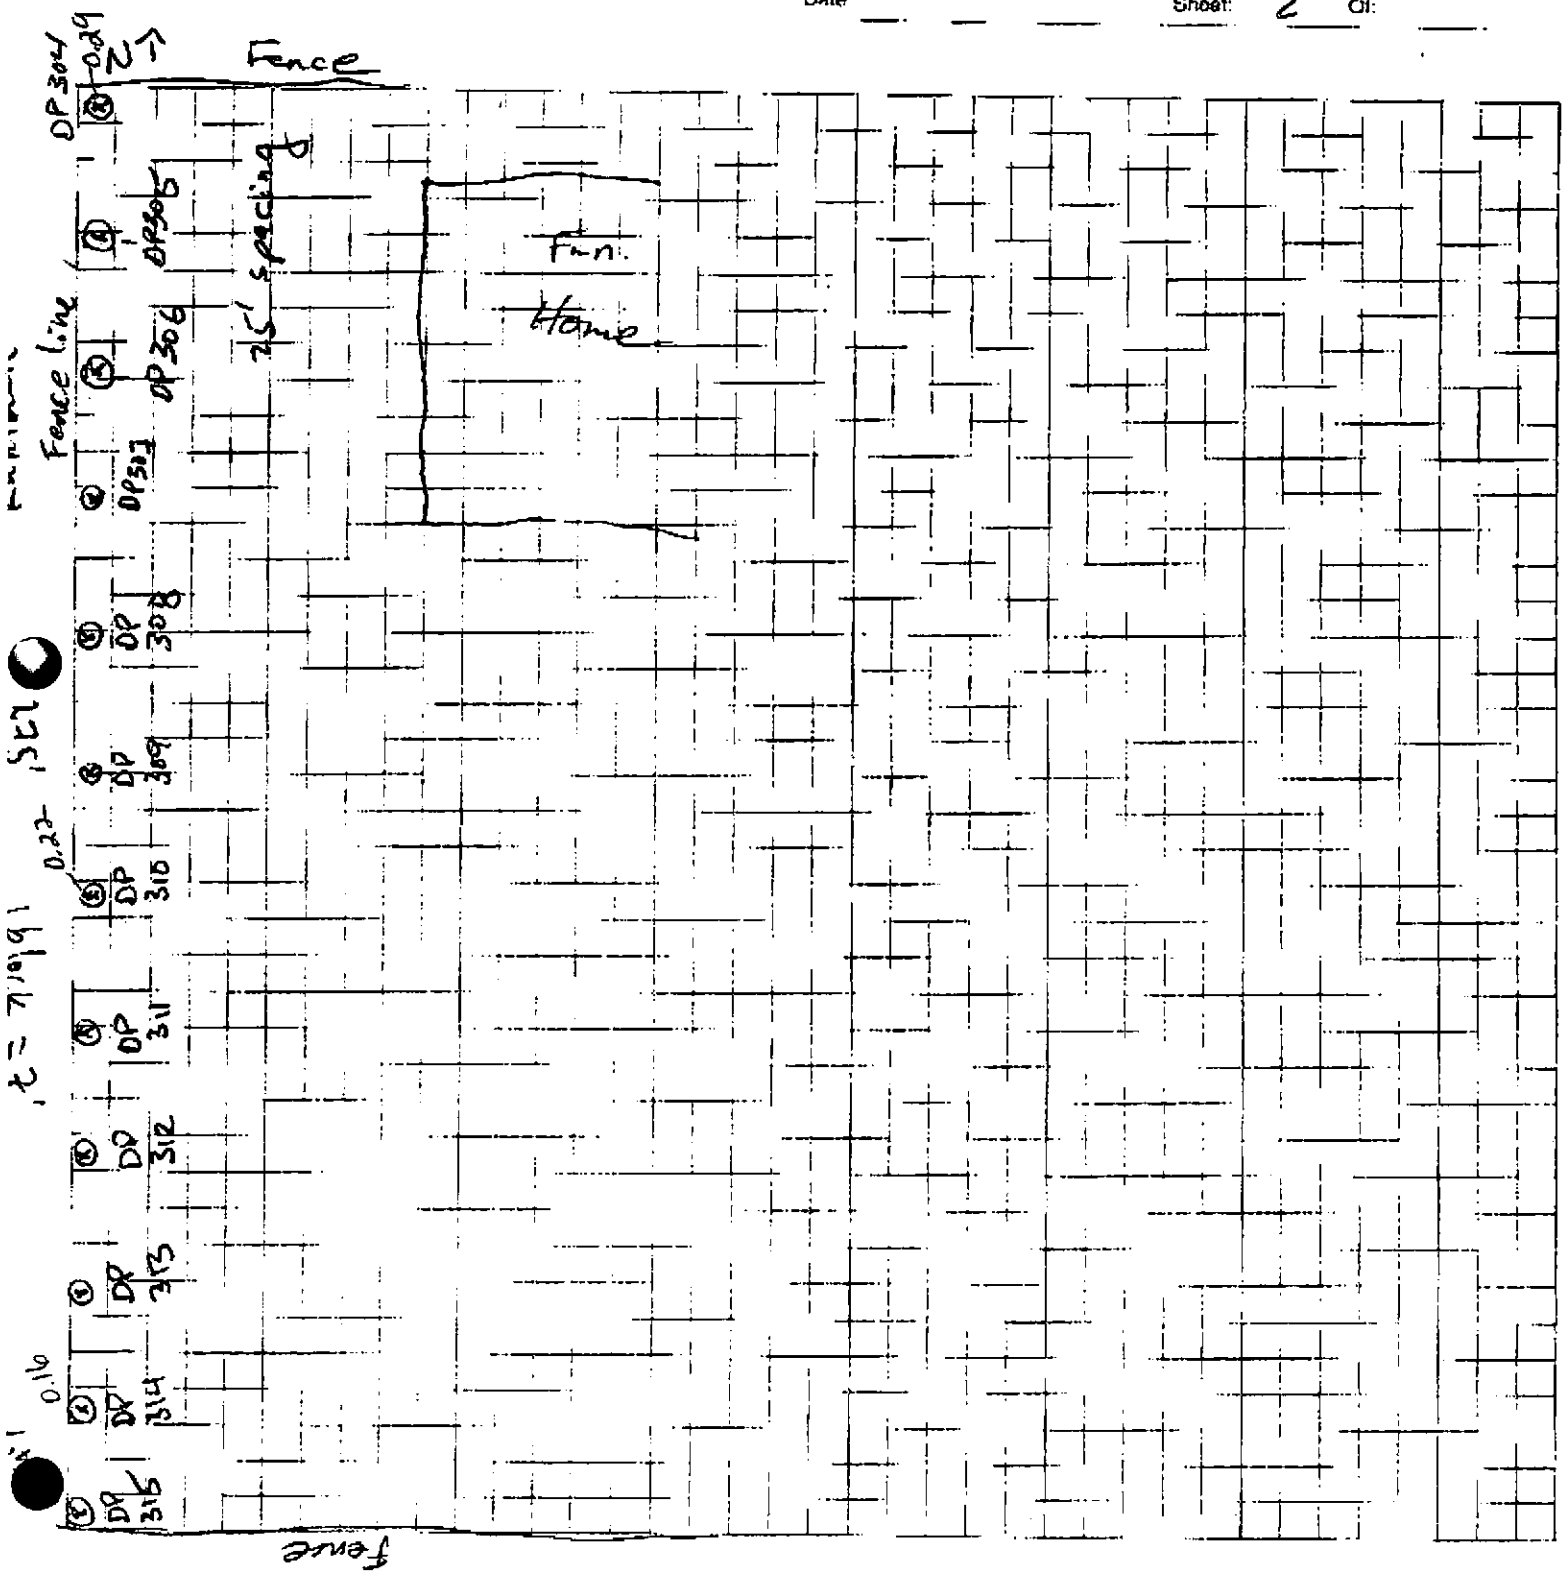

14 of 18

OGDEN

Job Name: Crystal Springs
Job Number:
Title: 303 N. Jackson (Stringer)
Computed by: Checked by:
Date: 8-17-00 Sheet: 10 Of:

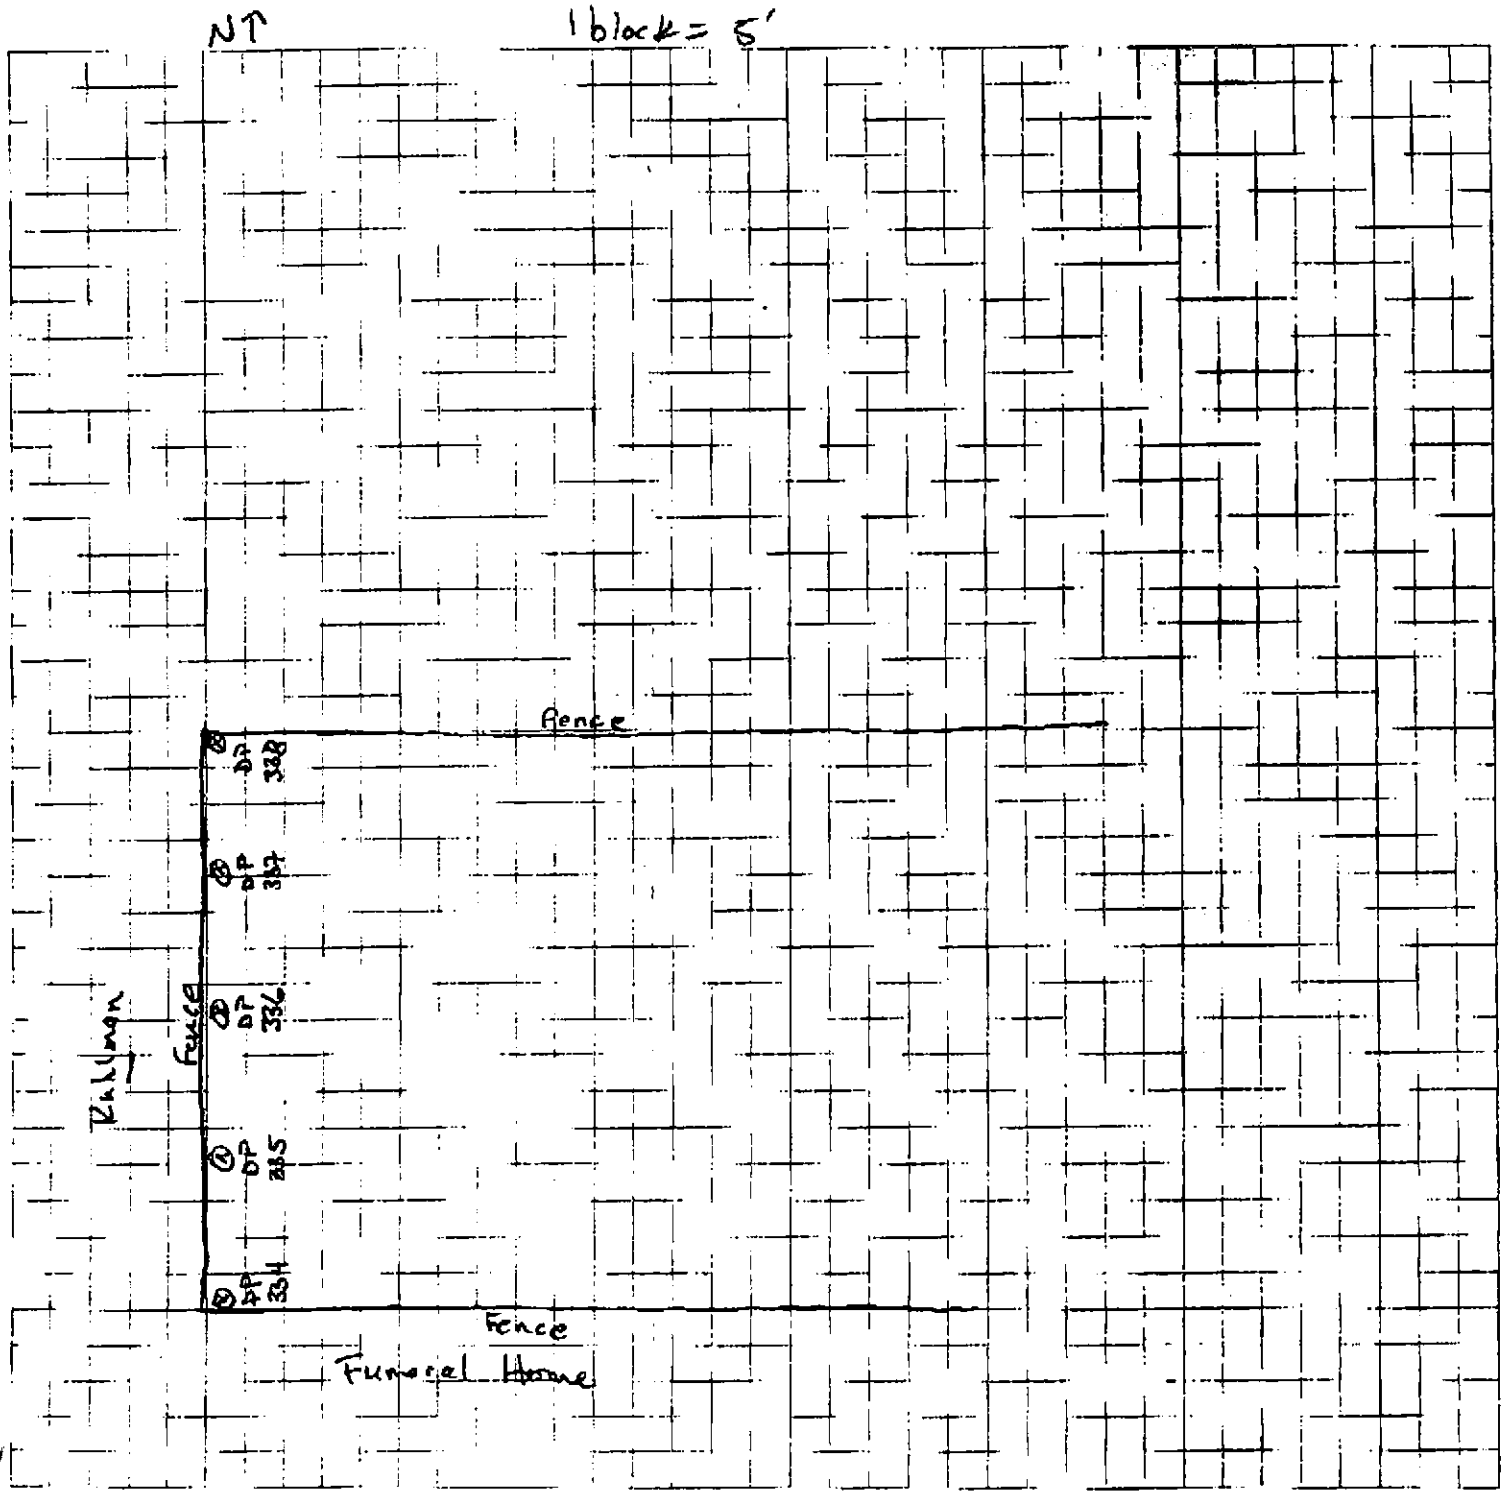

OGDEN

Job Name: Crystal Springs
Job Number:
Title: 401 N. Jackson Elnor Wright
Compiled by: Checked by:
Date: 8-16-2000 Sheet: 3 Of:

1 block = 4'

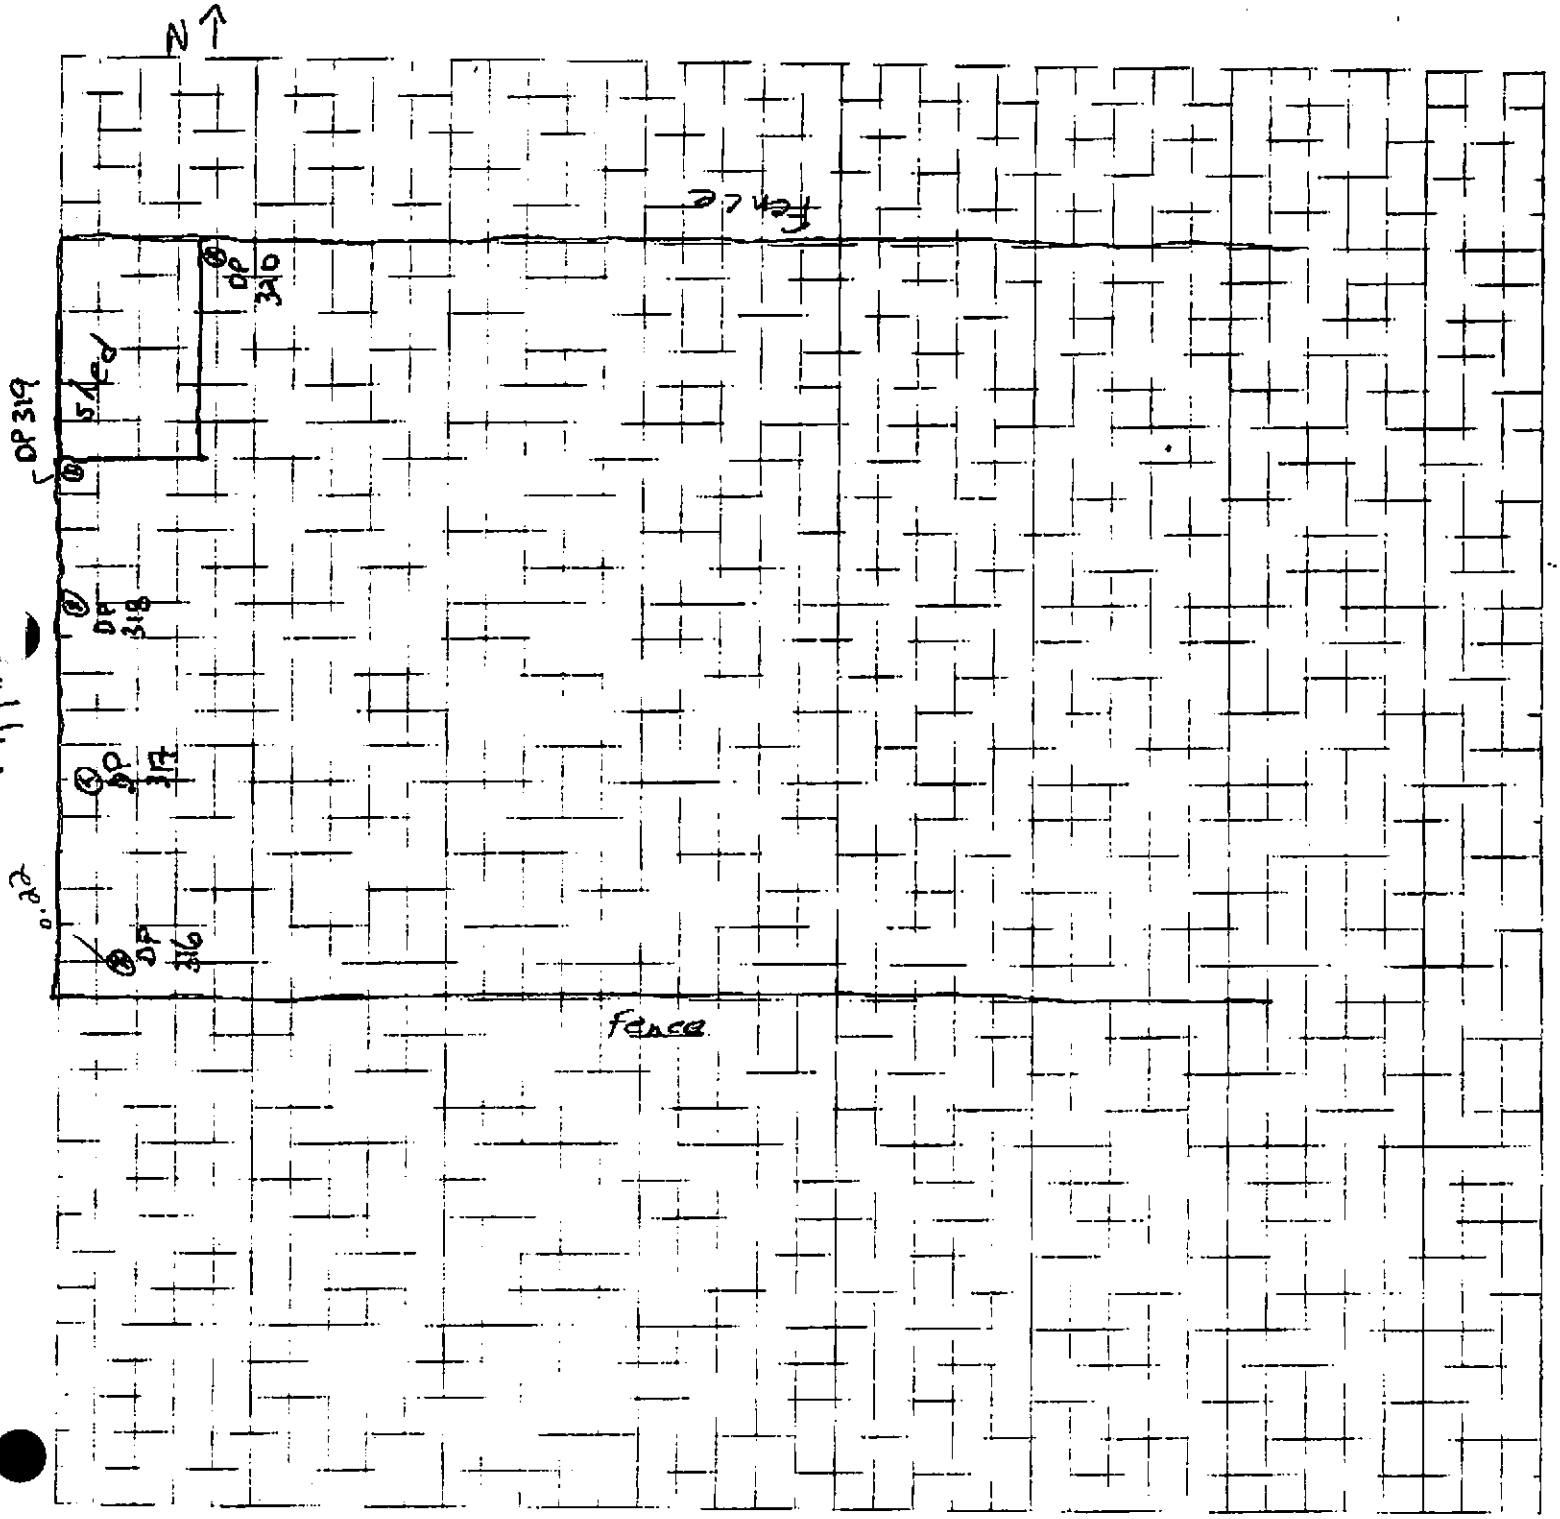

OGDEN

Job Name: Crystal Springs
Job Number:
Title: 407 N. Jackson Louie Lang
Computed by: Checked by:
Date: 8-16-00 Sheet 4 Of:

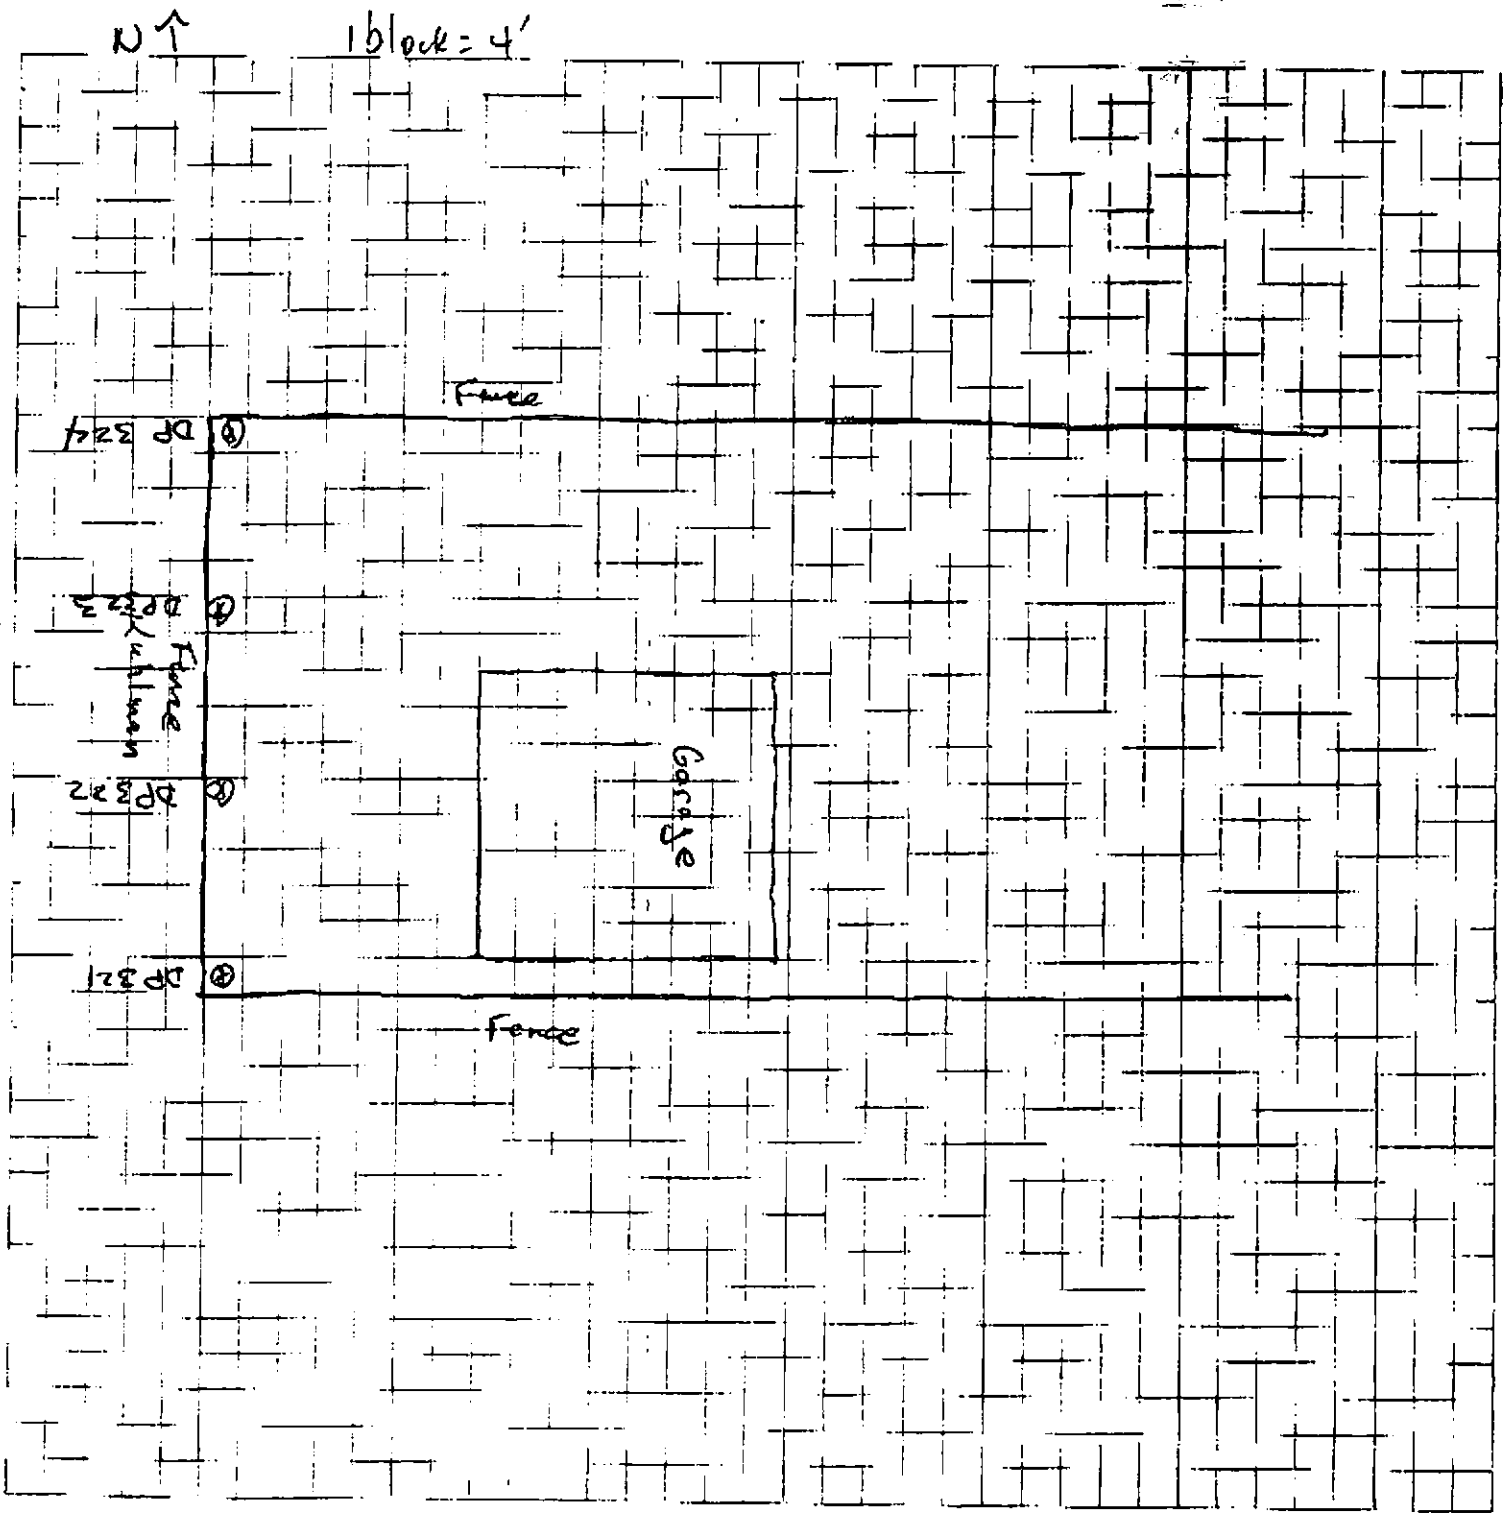

OGDEN

Job Name: Crystal Springs
Job Number:
Title: Lee St. Medical
Computed by: Checked by:
Date: 8/17/00 Sheet: 5 Of:

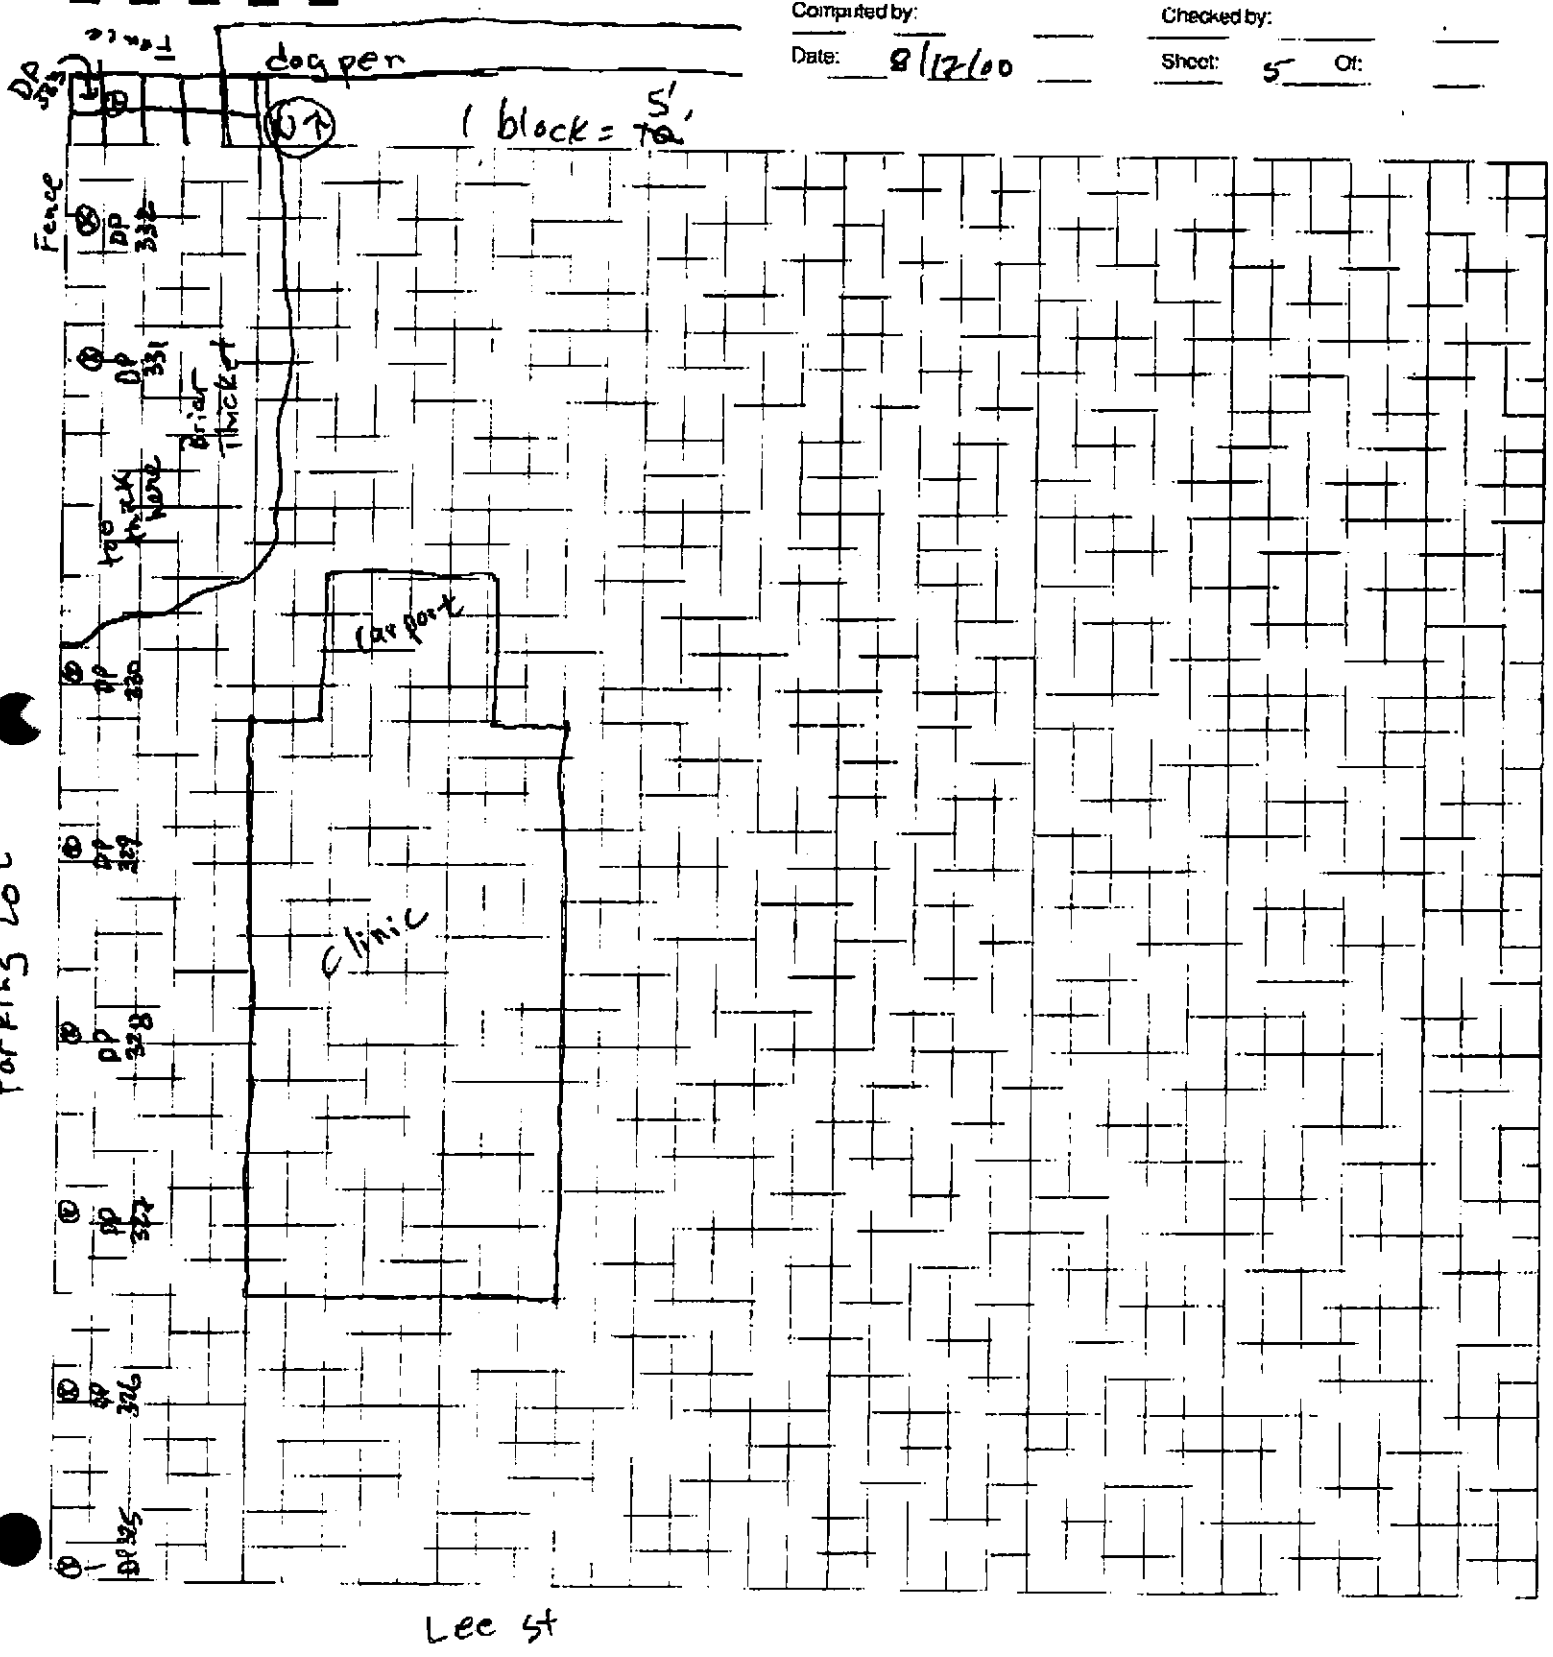

OGDEN

Job Name: Crystal Springs
Job Number:
Title: 219 N. Jackson - Perry Smith
Computed by: TJF Checked by:
Date: 8-17-00 Sheet: 7 Of:

1 block = 5'

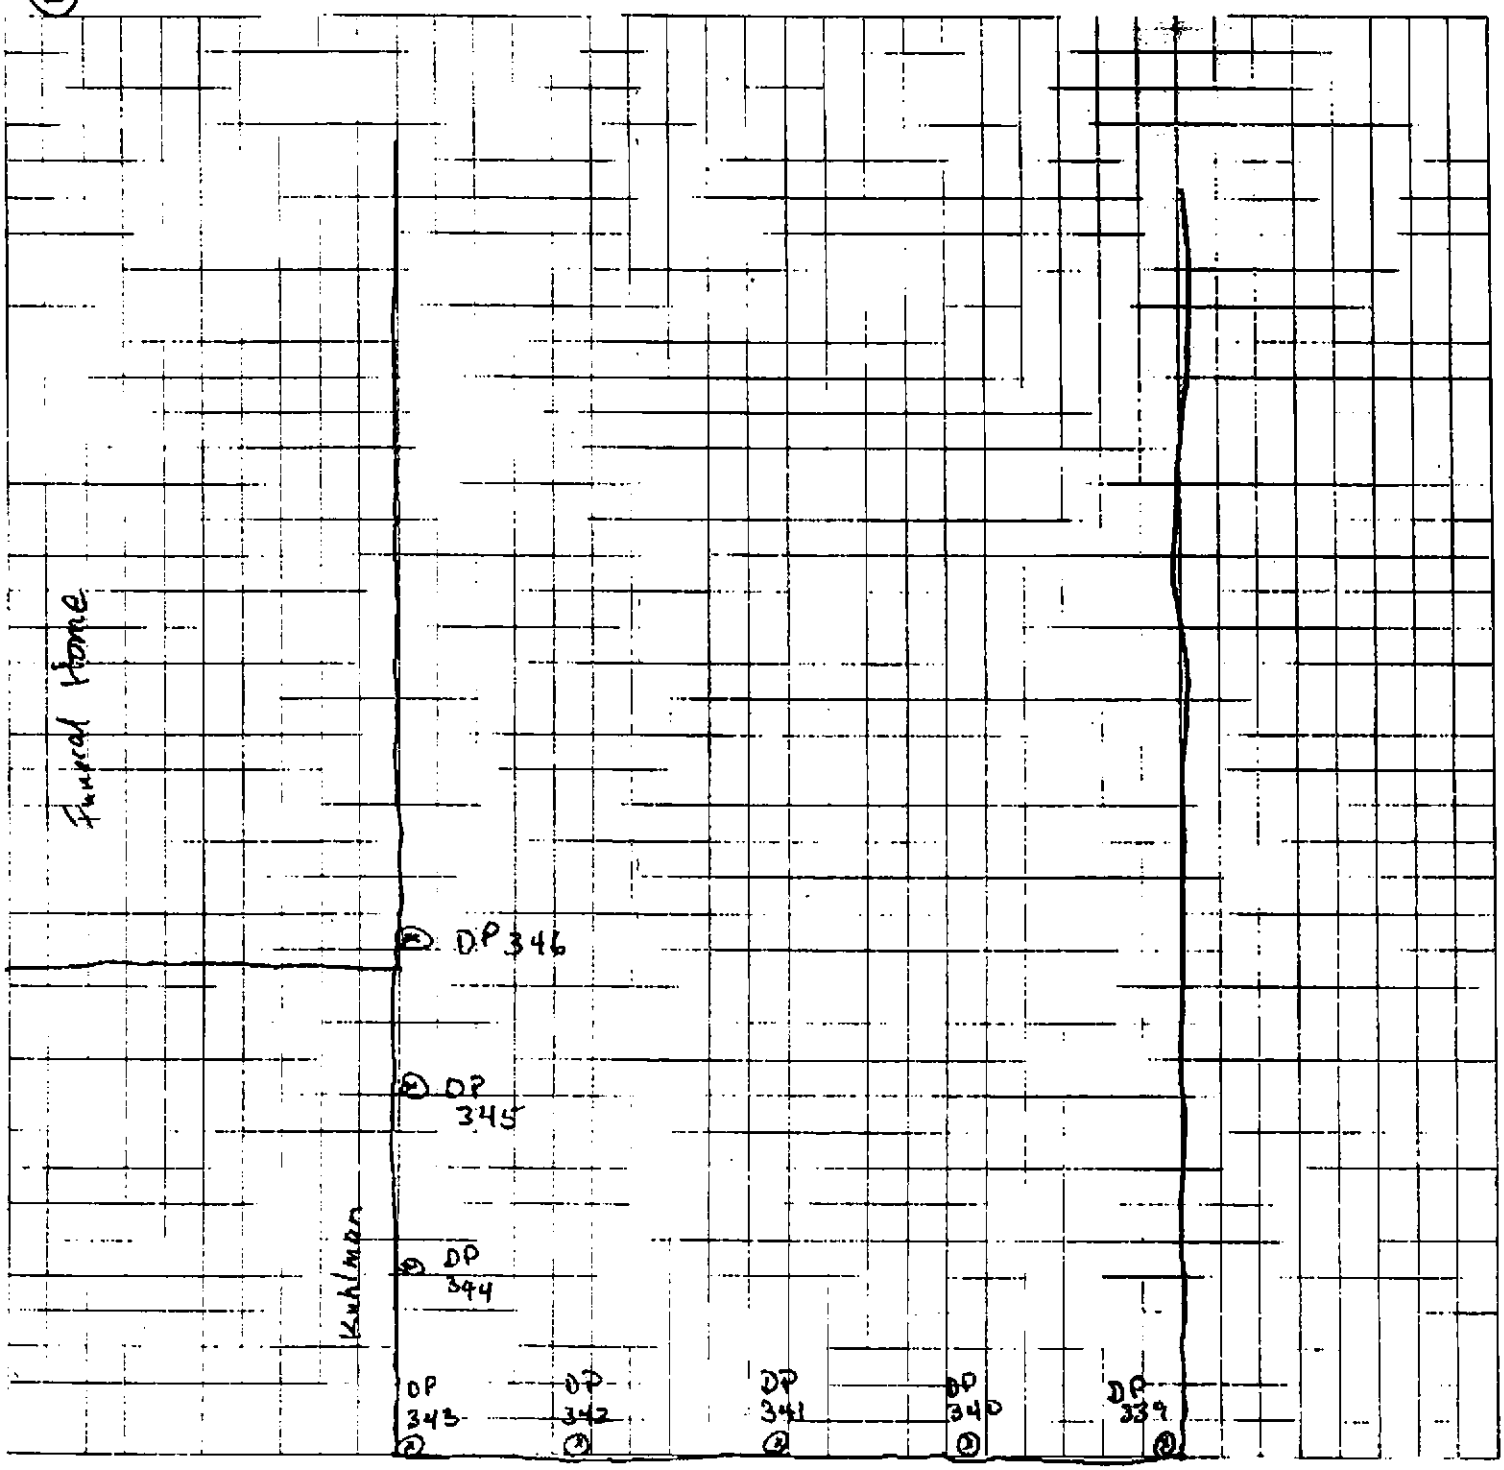

OGDEN

Job Name: Crystal Springs -
Job Number:
Title: Sonny Reeves backyard 405 Jackson
Computed by: Checked by:
Date: 8/16 2000 Sheet: 1 Of:

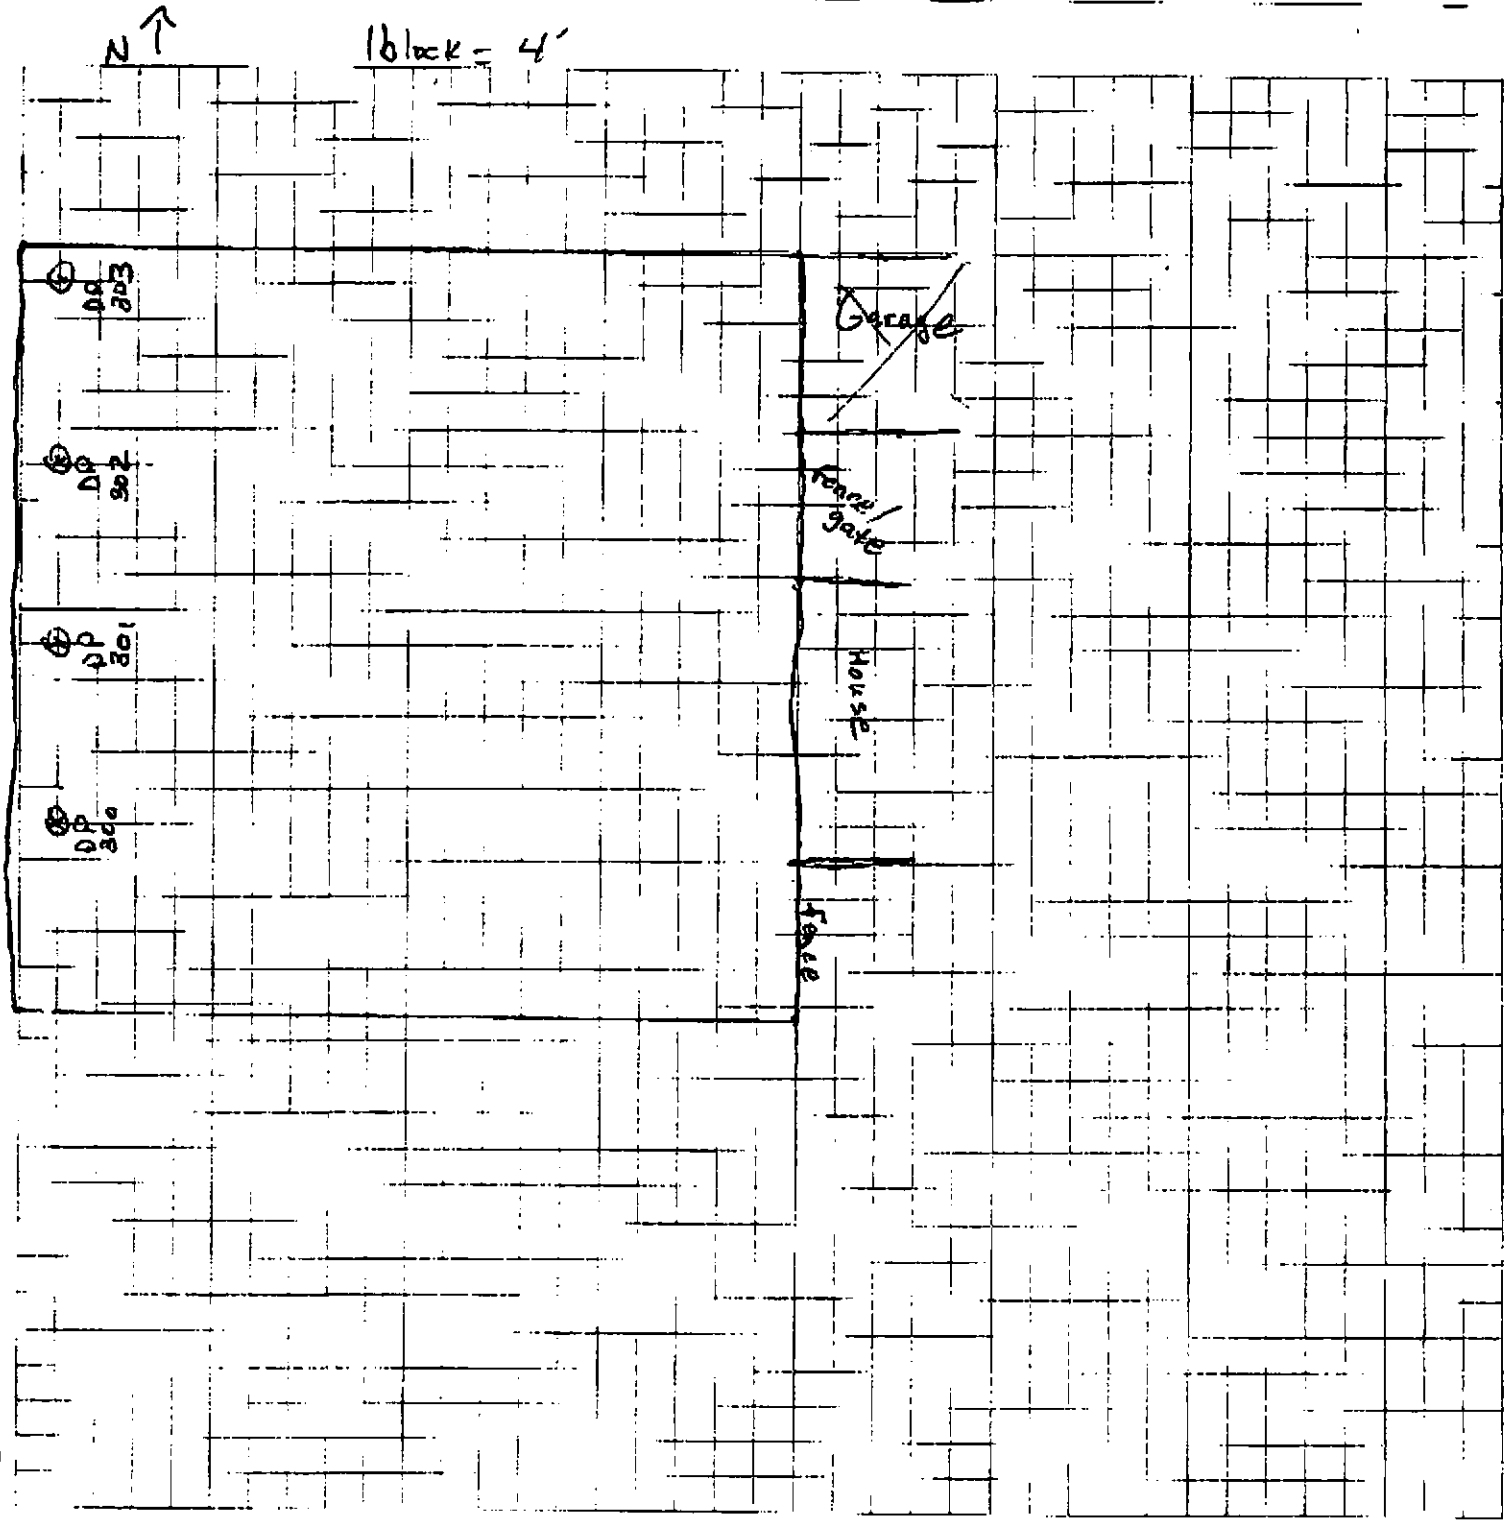

Martin & Slagle
GeoEnvironmental Associates LLC

October 2, 2000

Ms. Gretchen Zmitrovich
Office of Pollution Control
Mississippi Department of Environmental Quality
P.O. Box 10385
Jackson, Mississippi 39289-0385

SUBJECT: Transmittal of Analytical Data for Residences
Kuhlman Electric Corporation
Crystal Springs, Mississippi

Dear Ms. Zmitrovich:

Attached are site plans and spreadsheets showing sampling locations and analytical results from sampling of soils by Ogden Environmental and Energy Services. The soil samples were collected from residential properties surrounding Kuhlman Electric Corporation. Samples were collected from various depths ranging from ground surface to 4 feet below grade and analyzed by an on-site laboratory. Split samples were sent to Paradigm Analytical Laboratories for confirmation of on-site lab results.

The following properties have concentrations of PCB 1260 less than 1 mg/kg.

1. Perry Smith Property at 219 North Jackson Street

2. Stringer Funeral Home at 301 North Jackson Street

3. Stringer Rental Property at 303 North Jackson Street

4. Harold and Suzanne Warren Property at 403 North Jackson Street

5. Elnor Wright Property at 401 North Jackson Street

6. Sonny Reeves Property at 405 North Jackson Street

PO Box 1023
Black Mountain, NC 28711

(828) 669-3929
(828) 669-5289 fax

7. Brent Property at 403 Lee Avenue

8. Louie Lang / David Vinson at 407 North Jackson

9. Jerry Youngblood at 100 Lamar Street

Please contact me at 828-669-3929 if you have any questions or comments concerning these results.

Sincerely,

Martin and Slagle GeoEnvironmental Associates, LLC

Robert L. Martin, P.G.
Project Manager

Cc: Anastasia Hamel, BorgWarner Inc.

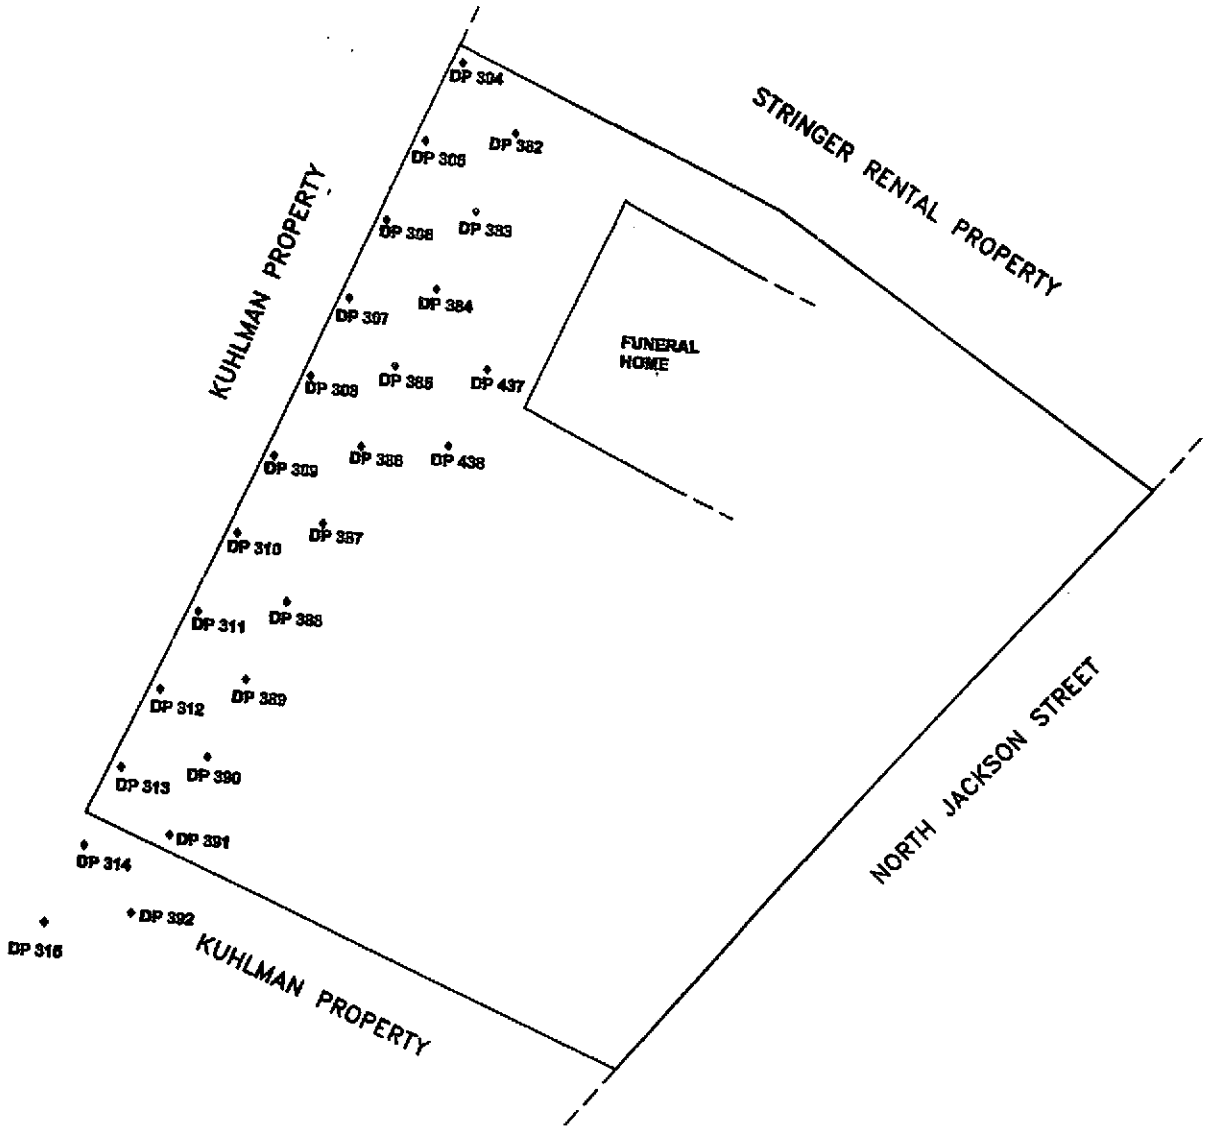

LEGEND

◆ SAMPLE POINT

DP 392 SAMPLE POINT NUMBER

1) ALL DISTANCES ARE ESTIMATED
2) THIS MAP WAS PREPARED FROM RECORD MAPS
3) THIS MAP HAS BEEN PREPARED FOR PRESENTATION PURPOSES ONLY

SAMPLE LOCATIONS FOR STRINGER FUNERAL HOME 301 NORTH JACKSON

SCALE: AS SHOWN	DR MDI	CHK TF	REV

PREPARED BY:

OGDEN ENVIRONMENTAL AND ENGINEERING SERVICES
200 SOUTH OLD STATEVILLE ROAD • HUNTERSVILLE, NC 28078 • 704-875-3570

PROJ: 073350000	DATE: 09/24/00	SHEET 1 OF 1

Soil and Wipe Sample Results
Stringer Funeral Home
301 North Jackson
Crystal Springs, Mississippi

SOIL SAMPLES (MG/KG)										
Target Analyte	Sample #	DP-304	DP-304	DP-305	DP-305	DP-306	DP-306	DP-307	DP-307	DP-308
	Depth	0.5	4	0.5	4	0.5	4	0.5	4	0.5
	Lab #	12	13	14	15	16	17	18	19	20
PCB as 1260		0.29	<0.10	0.66	<0.10	<0.10	<0.10	0.16	<0.10	0.15
	Collection Date	8/16/00	8/16/00	8/16/00	8/16/00	8/16/00	8/16/00	8/16/00	8/16/00	8/16/00
	Collection Time	10:46	10:50	10:52	10:55	10:59	11:03	11:12	11:16	11:20
	Injection Date	8/17/00	8/17/00	8/17/00	8/17/00	8/17/00	8/17/00	8/17/00	8/16/00	8/18/00

WIPE SAMPLES (TOTAL UG)					
Target Analyte	Sample #	SFH-1	SFH-2	SFH-3	SFH-4
	Depth				
	Lab #	736	737	738	739
PCB as 1260		<0.50	<0.50	<0.50	<0.50
	Collection Date	8/30/00	8/30/00	8/30/00	8/30/00
	Collection Time	13:15	13:18	13:22	13:25
	Injection Date	8/30/00	8/30/00	8/30/00	8/30/00

LOCATIONS:
SFH1: Double glass doors, entry from hearse parking.
SFH2: Wooden fence slat, 40' south of north fenceline, 4' above groud surface.
SFH3: North handrail of stairs on north side of building, leading to second story. Taken from third step up from ground level.
SFH4: Double glass doors, south side entrance.

Soil and Wipe Sample Results
Stringer Funeral Home
301 North Jackson
Crystal Springs, Mississippi

SOIL SAMPLES (MG/KG)										
Target Analyte	Sample #	DP-308	DP-309	DP-309	DP-310	DP-310	DP-311	DP-311	DP-312	DP-312
	Depth	4	0.5	4	0.5	4	0.5	4	0.5	4
	Lab #	21	22	23	24	25	26	27	28	29
PCB as 1260		<0.10	<0.10	<0.10	0.22	<0.10	<0.10	<0.10	<0.10	<0.10
	Collection Date	8/16/00	8/16/00	8/16/00	8/16/00	8/16/00	8/16/00	8/16/00	8/16/00	8/16/00
	Collection Time	11:22	11:26	11:30	11:47	11:50	11:55	12:00	12:05	12:09
	Injection Date	8/16/00	8/16/00	8/16/00	8/16/00	8/17/00	8/17/00	8/17/00	8/17/00	8/17/00

SOIL SAMPLES (MG/KG)										
Target Analyte	Sample #	DP-313	DP-313	DP-314	DP-314	DP-315	DP-315	DP-382	DP-382	DP-383
	Depth	0.5	4	0.5	4	0.5	4	0.5	4	0.5
	Lab #	30	31	32	33	34	35	185	186	187
PCB as 1260		<0.10	<0.10	0.16	<0.10	0.12	<0.10	<0.10	NA	<0.10
	Collection Date	8/16/00	8/16/00	8/16/00	8/16/00	8/16/00	8/16/00	8/19/00	8/19/00	8/19/00
	Collection Time	12:12	12:14	12:17	12:20	12:22	12:25	8:15	8:16	8:25
	Injection Date	8/17/00	8/17/00	8/17/00	8/17/00	8/17/00	8/17/00	8/19/00	NA	8/19/00

Soil and Wipe Sample Results
Stringer Funeral Home
301 North Jackson
Crystal Springs, Mississippi

SOIL SAMPLES (MG/KG)										
Target Analyte	Sample #	DP-383	DP-384	DP-384	DP-385	DP-385	DP-386	DP-388	DP-387	DP-387
	Depth	4	0.5	4	0.5	4	0.5	4	0.5	4
	Lab #	188	189	190	191	192	193	194	195	196
PCB as 1260		NA	<0.10	NA	0.68	<0.10	<0.10	NA	<0.10	NA
	Collection Date	8/19/00	8/19/00	8/19/00	8/19/00	8/19/00	8/19/00	8/19/00	8/19/00	8/19/00
	Collection Time	8:26	8:31	8:32	8:45	8:48	8:54	8:56	9:01	9:02
	Injection Date	NA	8/19/00	NA	8/19/00	8/19/00	8/19/00	NA	8/19/00	NA

SOIL SAMPLES (MG/KG)										
Target Analyte	Sample #	DP-388	DP-388	DP-389	DP-389	DP-390	DP-390	DP-391	DP-391	DP-392
	Depth	0.5	4	0.5	4	0.5	4	0.5	4	0.5
	Lab #	197	198	199	200	201	202	203	204	205
PCB as 1260		<0.10	NA	<0.10	NA	<0.10	NA	<0.10	NA	<0.10
	Collection Date	8/19/00	8/19/00	8/19/00	8/19/00	8/19/00	8/19/00	8/19/00	8/19/00	8/19/00
	Collection Time	9:09	9:10	9:15	9:17	9:19	9:20	9:22	9:24	9:26
	Injection Date	8/19/00	NA	8/19/00	NA	8/19/00	NA	8/19/00	NA	8/19/00

Martin & Slagle
GeoEnvironmental Associates LLC

FILE COPY

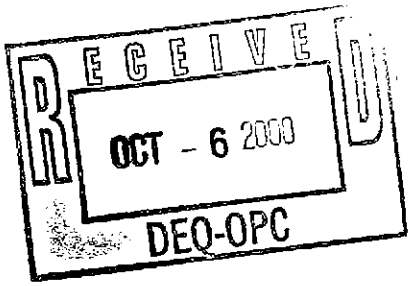

October 5, 2000

Ms. Gretchen Zmitrovich
Office of Pollution Control
Mississippi Department of
Environmental Quality
Office of Pollution Control
P.O. Box 10385
Jackson, Mississippi 39289-0385

SUBJECT: Transmittal of Revised Analytical Data Tables for Residences
Kuhlman Electric Corporation
Crystal Springs, Mississippi

Dear Ms. Zmitrovich:

Attached is one complete set of revised spreadsheets showing analytical results from sampling of soils by Ogden Environmental and Energy Services. The tables were revised based on your review and comments. Results for split samples are being prepared into tables and will be forwarded to you by Monday at the latest.

Please contact me at 828-669-3929 if you have any questions or comments concerning these results.

Sincerely,

Martin and Slagle GeoEnvironmental Associates, LLC

Robert L. Martin, P.G.
Project Manager

Cc: Anastasia Hamel, BorgWarner Inc.

PO Box 1023
Black Mountain, NC 28711

(828) 669-3929
(828) 669-5289 fax

Soil and Wipe Sample Results
Stringer Funeral Home
301 North Jackson
Crystal Springs, Mississippi

SOIL SAMPLES (MG/KG)										
Target Analyte	Sample #	DP-304	DP-304	DP-305	DP-305	DP-306	DP-306	DP-307	DP-307	DP-308
	Depth (ft)	0.5	4	0.5	4	0.5	4	0.5	4	0.5
	Lab #	12	13	14	15	16	17	18	19	20
PCB as 1260		0.29	<0.10	0.66	<0.10	<0.10	<0.10	0.16	<0.10	0.15
	Collection Date	8/16/00	8/16/00	8/16/00	8/16/00	8/16/00	8/16/00	8/16/00	8/16/00	8/16/00
	Collection Time	10:46	10:50	10:52	10:55	10:59	11:03	11:12	11:16	11:20
	Injection Date	8/17/00	8/17/00	8/17/00	8/17/00	8/17/00	8/17/00	8/17/00	8/16/00	8/18/00

WIPE SAMPLES (TOTAL UG)					
Target Analyte	Sample #	SFH-1	SFH-2	SFH-3	SFH-4
	Depth				
	Lab #	736	737	738	739
PCB as 1260		<0.50	<0.50	<0.50	<0.50
	Collection Date	8/30/00	8/30/00	8/30/00	8/30/00
	Collection Time	13:15	13:18	13:22	13:25
	Injection Date	8/30/00	8/30/00	8/30/00	8/30/00

LOCATIONS:
SFH1: Double glass doors, entry from hearse parking.
SFH2: Wooden fence slat, 40' south of north fenceline, 4' above groud surface.
SFH3: North handrail of stairs on north side of building, leading to second story. Taken from third step up from ground level.
SFH4: Double glass doors, south side entrance.

Soil and Wipe Sample Results
Stringer Funeral Home
301 North Jackson
Crystal Springs, Mississippi

SOIL SAMPLES (MG/KG)										
Target Analyte	Sample #	DP-308	DP-309	DP-309	DP-310	DP-310	DP-311	DP-311	DP-312	DP-312
	Depth (ft)	4	0.5	4	0.5	4	0.5	4	0.5	4
	Lab #	21	22	23	24	25	26	27	28	29
PCB as 1260		<0.10	<0.10	<0.10	0.22	<0.10	<0.10	<0.10	<0.10	<0.10
	Collection Date	8/16/00	8/16/00	8/16/00	8/16/00	8/16/00	8/16/00	8/16/00	8/16/00	8/16/00
	Collection Time	11:22	11:26	11:30	11:47	11:50	11:55	12:00	12:05	12:09
	Injection Date	8/16/00	8/16/00	8/16/00	8/16/00	8/17/00	8/17/00	8/17/00	8/17/00	8/17/00

SOIL SAMPLES (MG/KG)										
Target Analyte	Sample #	DP-313	DP-313	DP-314	DP-314	DP-315	DP-315	DP-382	DP-382	DP-383
	Depth (ft)	0.5	4	0.5	4	0.5	4	0.5	4	0.5
	Lab #	30	31	32	33	34	35	185	186	187
PCB as 1260		<0.10	<0.10	0.16	<0.10	0.12	<0.10	<0.10	NA	<0.10
	Collection Date	8/16/00	8/16/00	8/16/00	8/16/00	8/16/00	8/16/00	8/19/00	8/19/00	8/19/00
	Collection Time	12:12	12:14	12:17	12:20	12:22	12:25	8:15	8:16	8:25
	Injection Date	8/17/00	8/17/00	8/17/00	8/17/00	8/17/00	8/17/00	8/19/00	NA	8/19/00

Notes:

NA Indicates Sample Not Analyzed

Soil and Wipe Sample Results
Stringer Funeral Home
301 North Jackson
Crystal Springs, Mississippi

SOIL SAMPLES (MG/KG)										
Target Analyte	Sample #	DP-383	DP-384	DP-384	DP-385	DP-385	DP-386	DP-386	DP-387	DP-387
	Depth (ft)	4	0.5	4	0.5	4	0.5	4	0.5	4
	Lab #	188	189	190	191	192	193	194	195	196
PCB as 1260		NA	<0.10	NA	0.68	<0.10	<0.10	NA	<0.10	NA
	Collection Date	8/19/00	8/19/00	8/19/00	8/19/00	8/19/00	8/19/00	8/19/00	8/19/00	8/19/00
	Collection Time	8:26	8:31	8:32	8:45	8:46	8:54	8:56	9:01	9:02
	Injection Date	NA	8/19/00	NA	8/19/00	8/19/00	8/19/00	NA	8/19/00	NA

Notes:

NA Indicates Sample Not Analyzed

SOIL SAMPLES (MG/KG)										
Target Analyte	Sample #	DP-388	DP-388	DP-389	DP-389	DP-390	DP-390	DP-391	DP-391	DP-392
	Depth (ft)	0.5	4	0.5	4	0.5	4	0.5	4	0.5
	Lab #	197	198	199	200	201	202	203	204	205
PCB as 1260		<0.10	NA	<0.10	NA	<0.10	NA	<0.10	NA	<0.10
	Collection Date	8/19/00	8/19/00	8/19/00	8/19/00	8/19/00	8/19/00	8/19/00	8/19/00	8/19/00
	Collection Time	9:09	9:10	9:15	9:17	9:19	9:20	9:22	9:24	9:26
	Injection Date	8/19/00	NA	8/19/00	NA	8/19/00	NA	8/19/00	NA	8/19/00

Notes:

NA Indicates Sample Not Analyzed

Soil and Wipe Sample Results
Stringer Funeral Home
301 North Jackson
Crystal Springs, Mississippi

SOIL SAMPLES (MG/KG)									
Target Analyte	Sample #	DP-392	DP-437	DP-437	DP-438	DP-438	DP-304	DP-305	DP-385
	Depth (ft)	4	0.5	4	0.5	4	0.1	0.1	0.1
	Lab #	206	300	301	302	303	1121	1122	1123
PCB as 1260		NA	<0.10	NA	<0.10	NA	0.37	0.60*J	0.10
	Collection Date	8/19/00	8/20/00	8/20/00	8/20/00	8/20/00	9/19/00	9/19/00	9/19/00
	Collection Time	9:27	13:20	13:22	13:35	13:36	11:40	11:42	11:45
	Injection Date	NA	8/20/00	NA	8/20/00	NA	9/20/00	9/20/00	9/20/00

Notes:

NA Indicates Sample Not Analyzed
* J Estimated level, due to interference from the presence of Technical Chlordane, DDT, DDD, & DDE.